

0374-1271

C-CENTRAL
ASSAYS
FIRST LIFT
-145 to -142 m RL


220100E

220150E

220200E

564100N

564050N

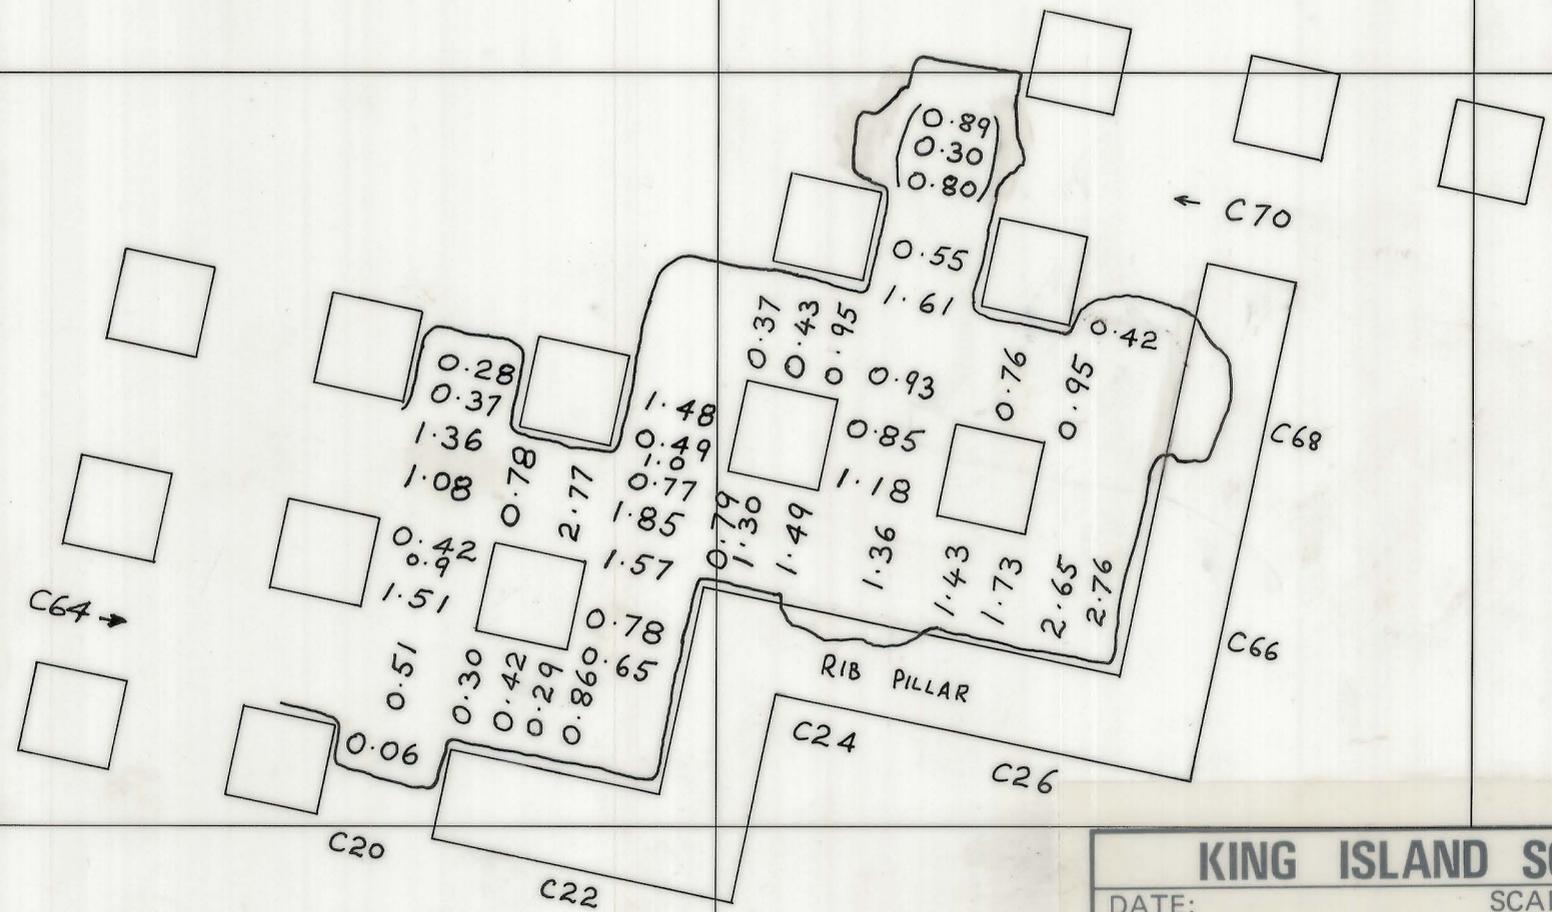

5 cm
0374-1271

KING ISLAND SCHEELITE	
DATE:	SCALE: 1:500
MINE: DOLPHIN	DWG/NO.:
C-CENTRAL FIRST LIFT -145m RL to -142m R.L.	
GRAB SAMPLE ASSAYS	
PRELIMINARY	FINAL