


I17 - L16
CENTRAL
ACCESSSES

0374_1273

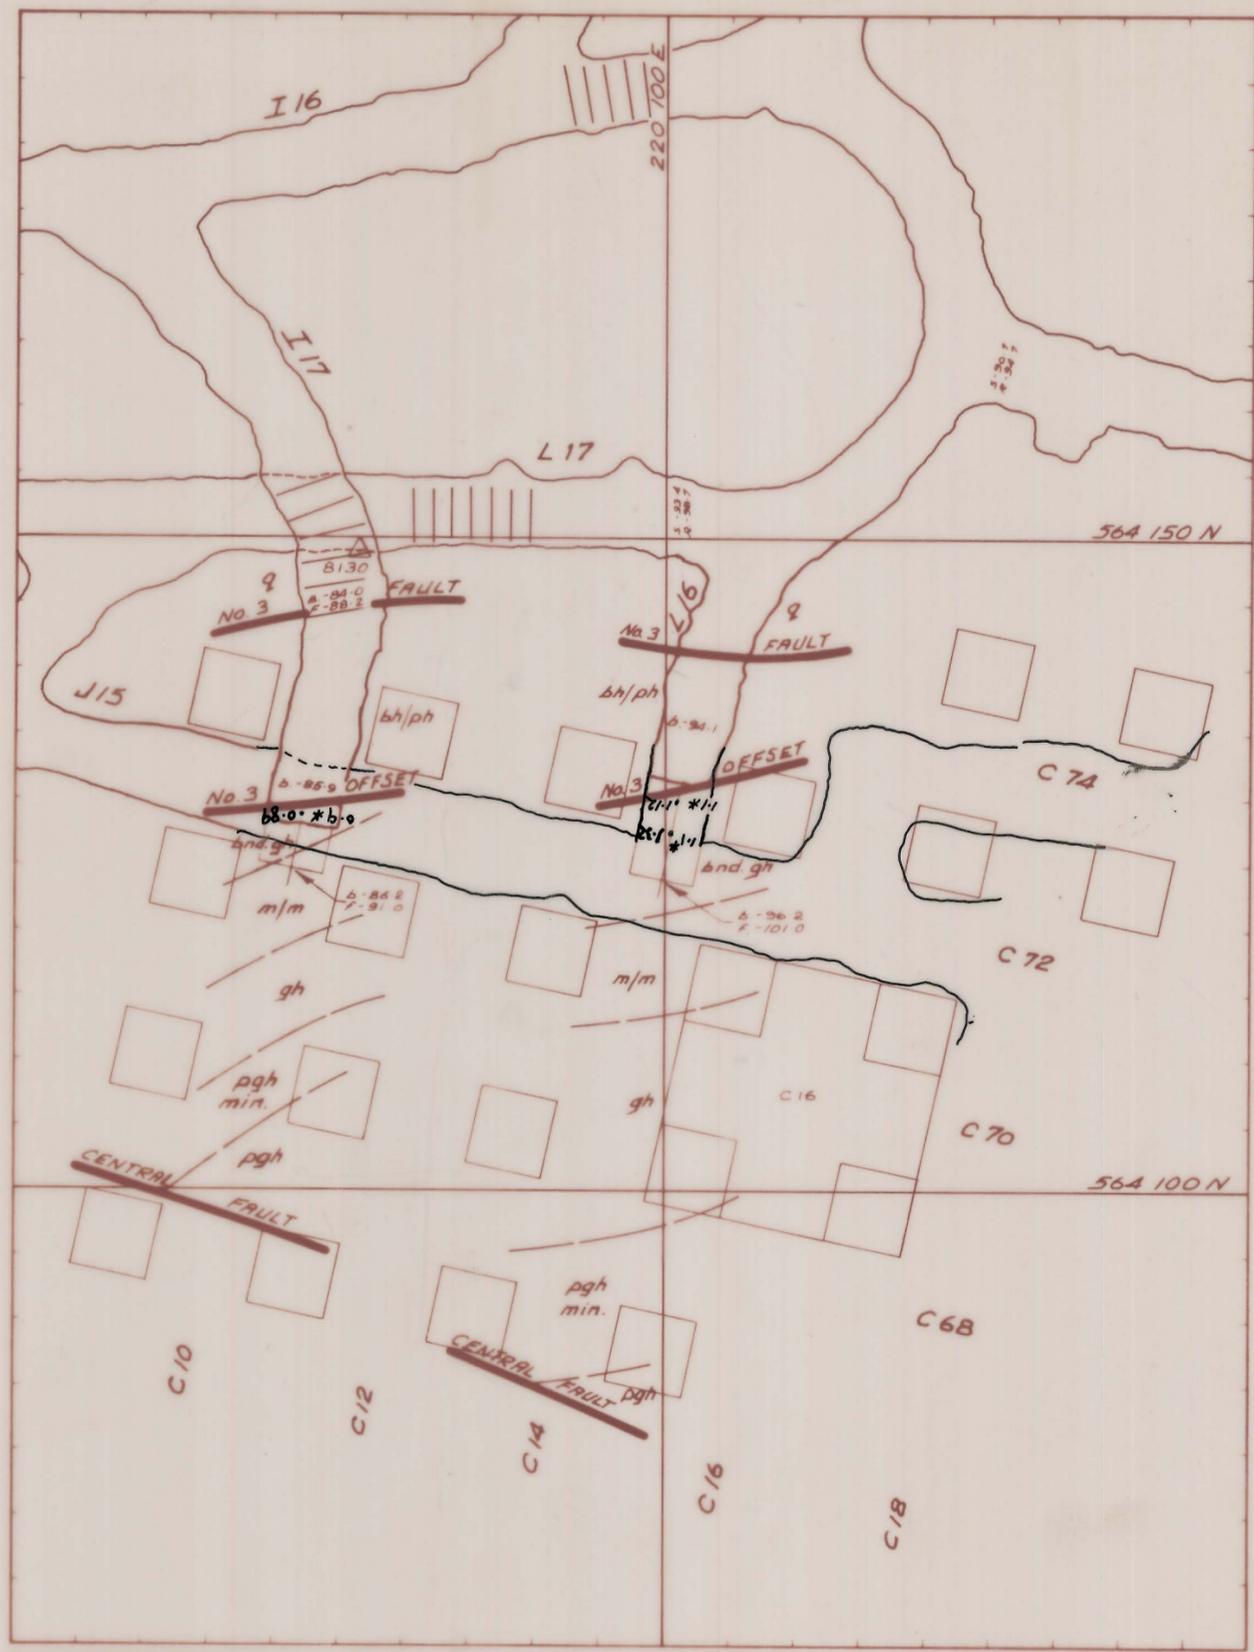

REF PLAN 04 DM14-1002 04 DM14-1003 03 DM04-1033	GEOLOGY I.D.H.	1 500 SCALE	KIS KING ISLAND SCHEELITE GRASSY KING ISLAND
	SURVEY	DOLPHIN MINE L16 - I17 ACCESS CENTRAL AREA NB GEOLOGY at MID-DRIVE HEIGHT	
	PLANNING		
	ROCK MEC		
	GRADE CON		
	DRAFTING		
	T.S.S.	DRAWING NUMBER	

0374_1273

