


-200m R.L.
STRIKE DRIVE

KG04DM14-1107

0374_1307

27 JUN 1981

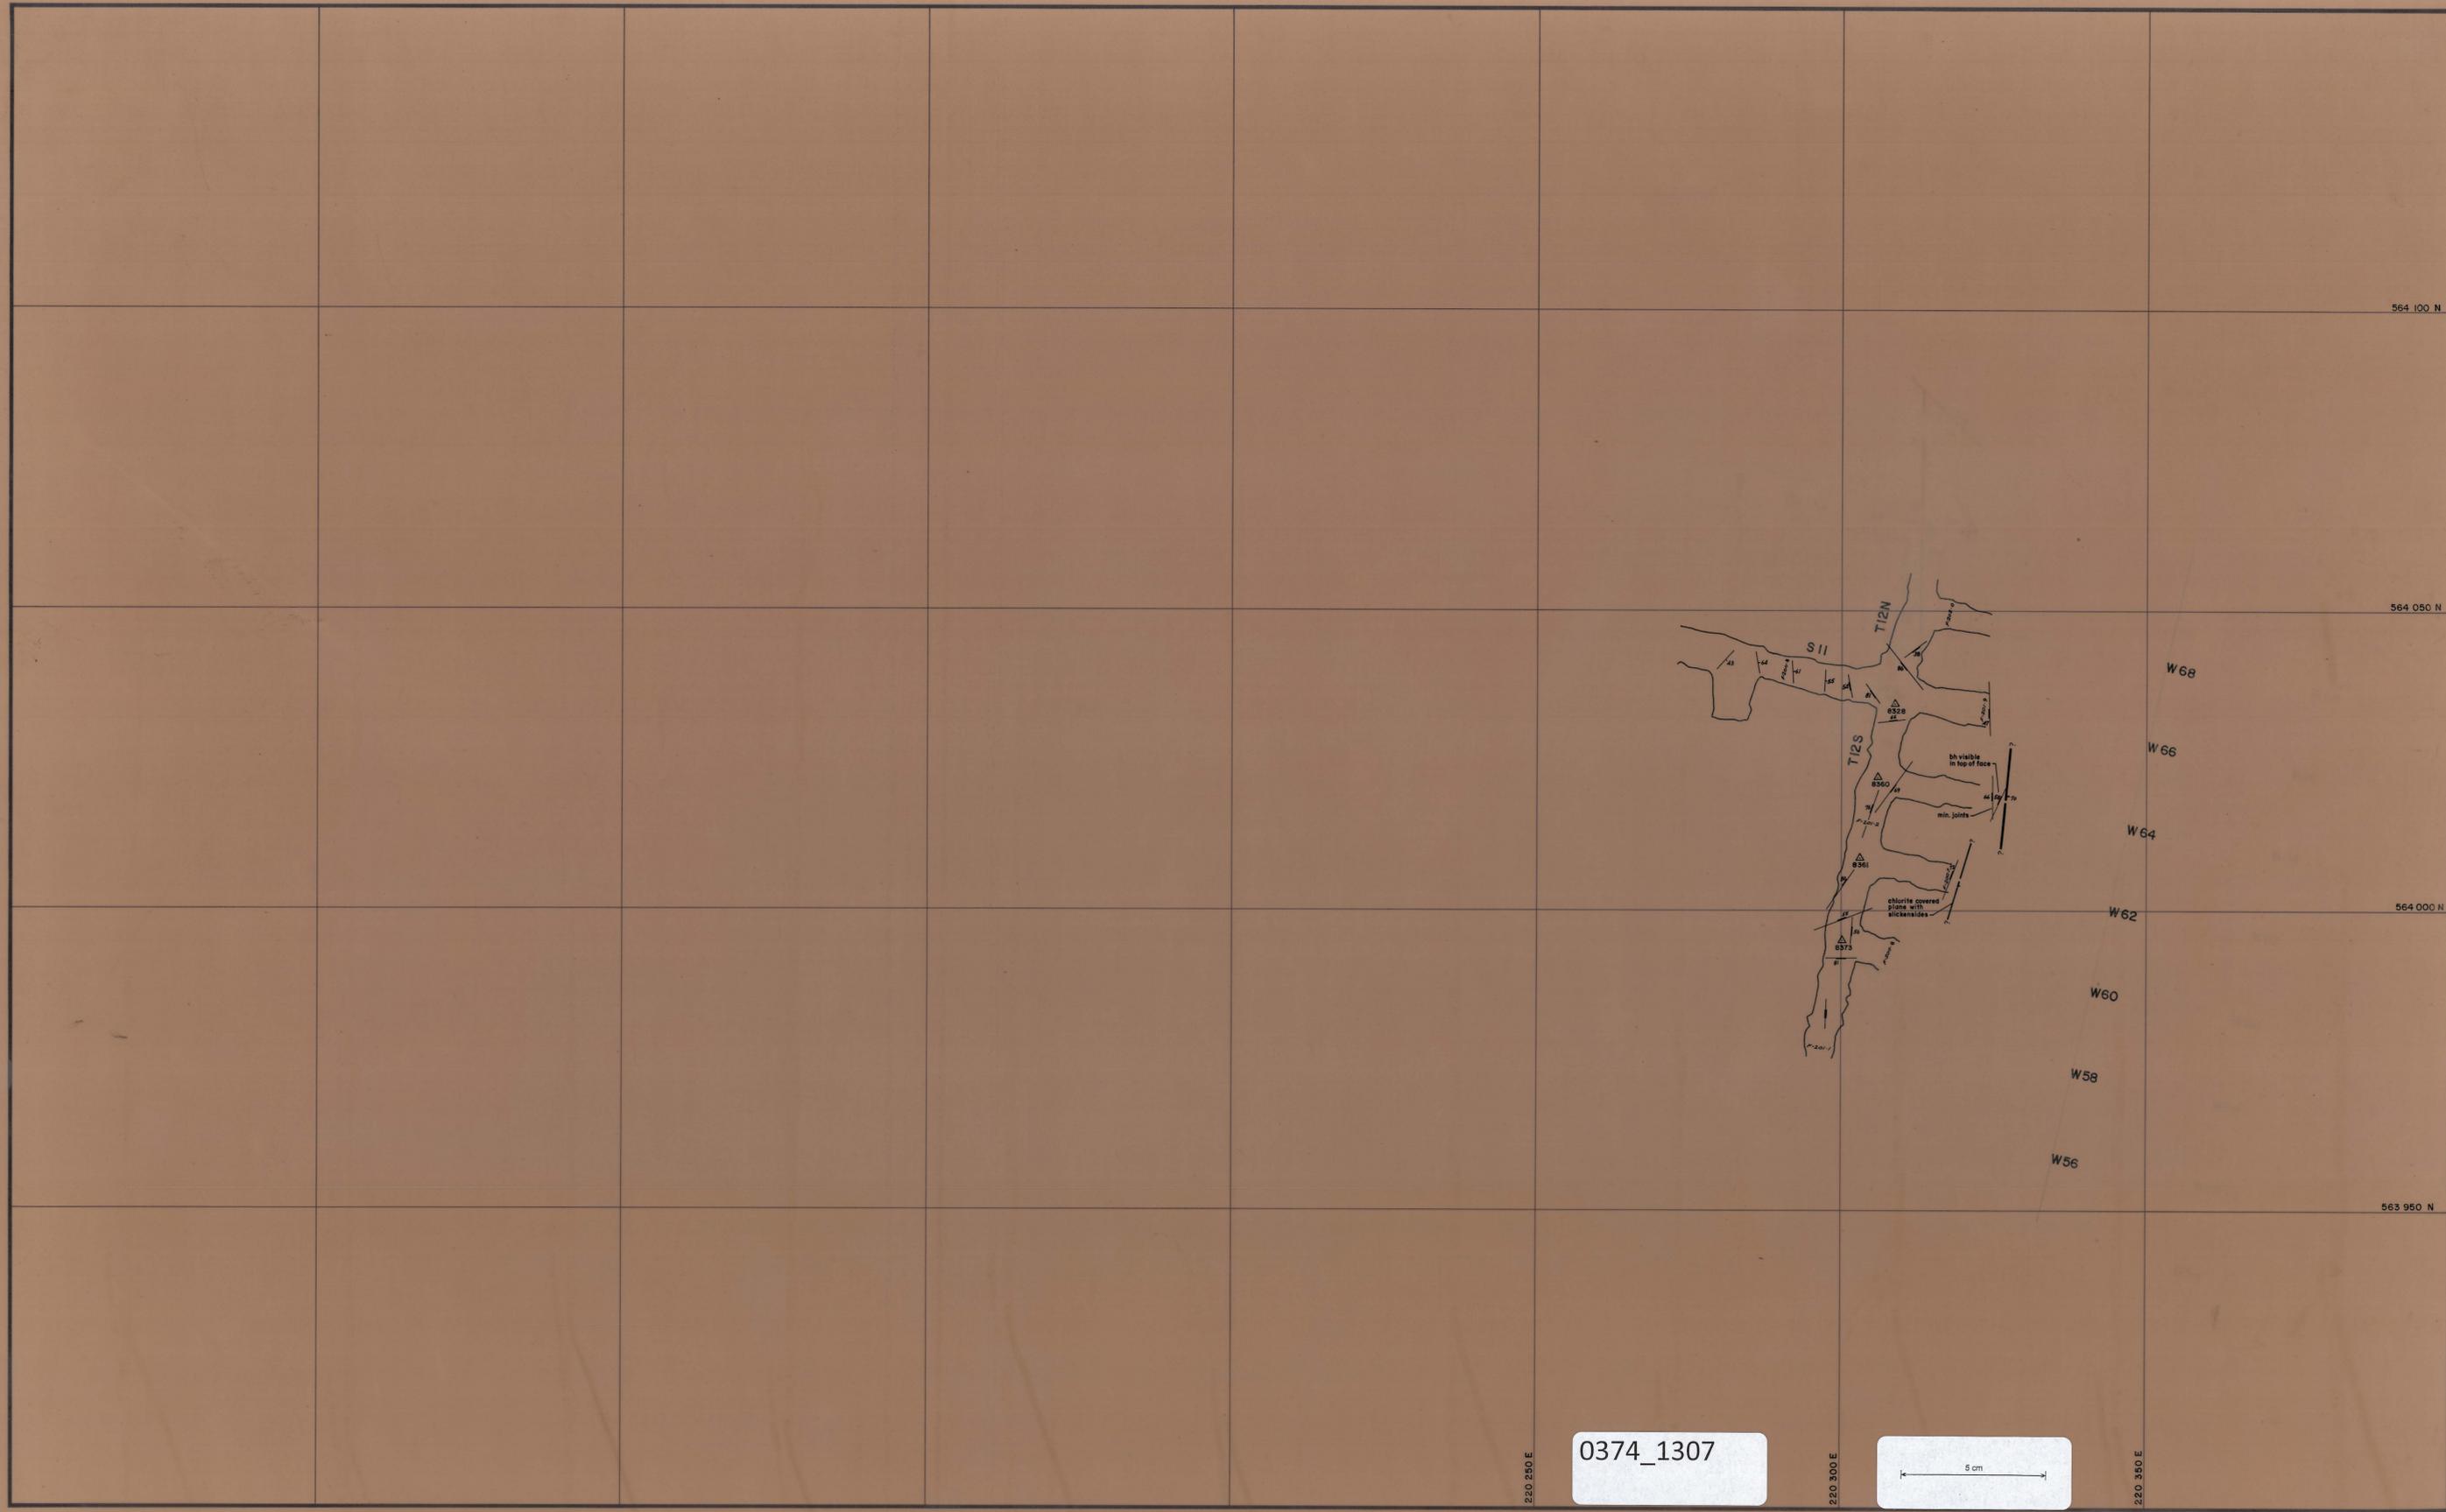

0374_1307



LEGEND				
v	Upper metavolcanics	— strike and dip	— geological boundary	
bh/ph	Banded hornfels	— strike and dip vertical joint	— minor fault	
ch	Marble	— joint vertical	— major fault	
bh	Biotite hornfels	— unconformity	b	back
pgh	Pyroxene garnet hornfels	— relative movement	f	floor
gh	Garnet hornfels	— rise extending through level	r	road
lv	Lower metavolcanics	— head of rise	s	spad
q	Quartzite	— foot of rise	Δ	survey station
ap	Aplite	—		
gr	Granite	—		

KING ISLAND SCHEELITE

DOLPHIN MINE
-200m R.L. STRIKE DRIVE

DATE: _____

DRAWN: _____

GEOLOGY: _____

CHECKED: _____

SCALE 1:500

DWG. No. KG04DM14-1107