


0374_1315

K93-251-012
251 959m R.L.

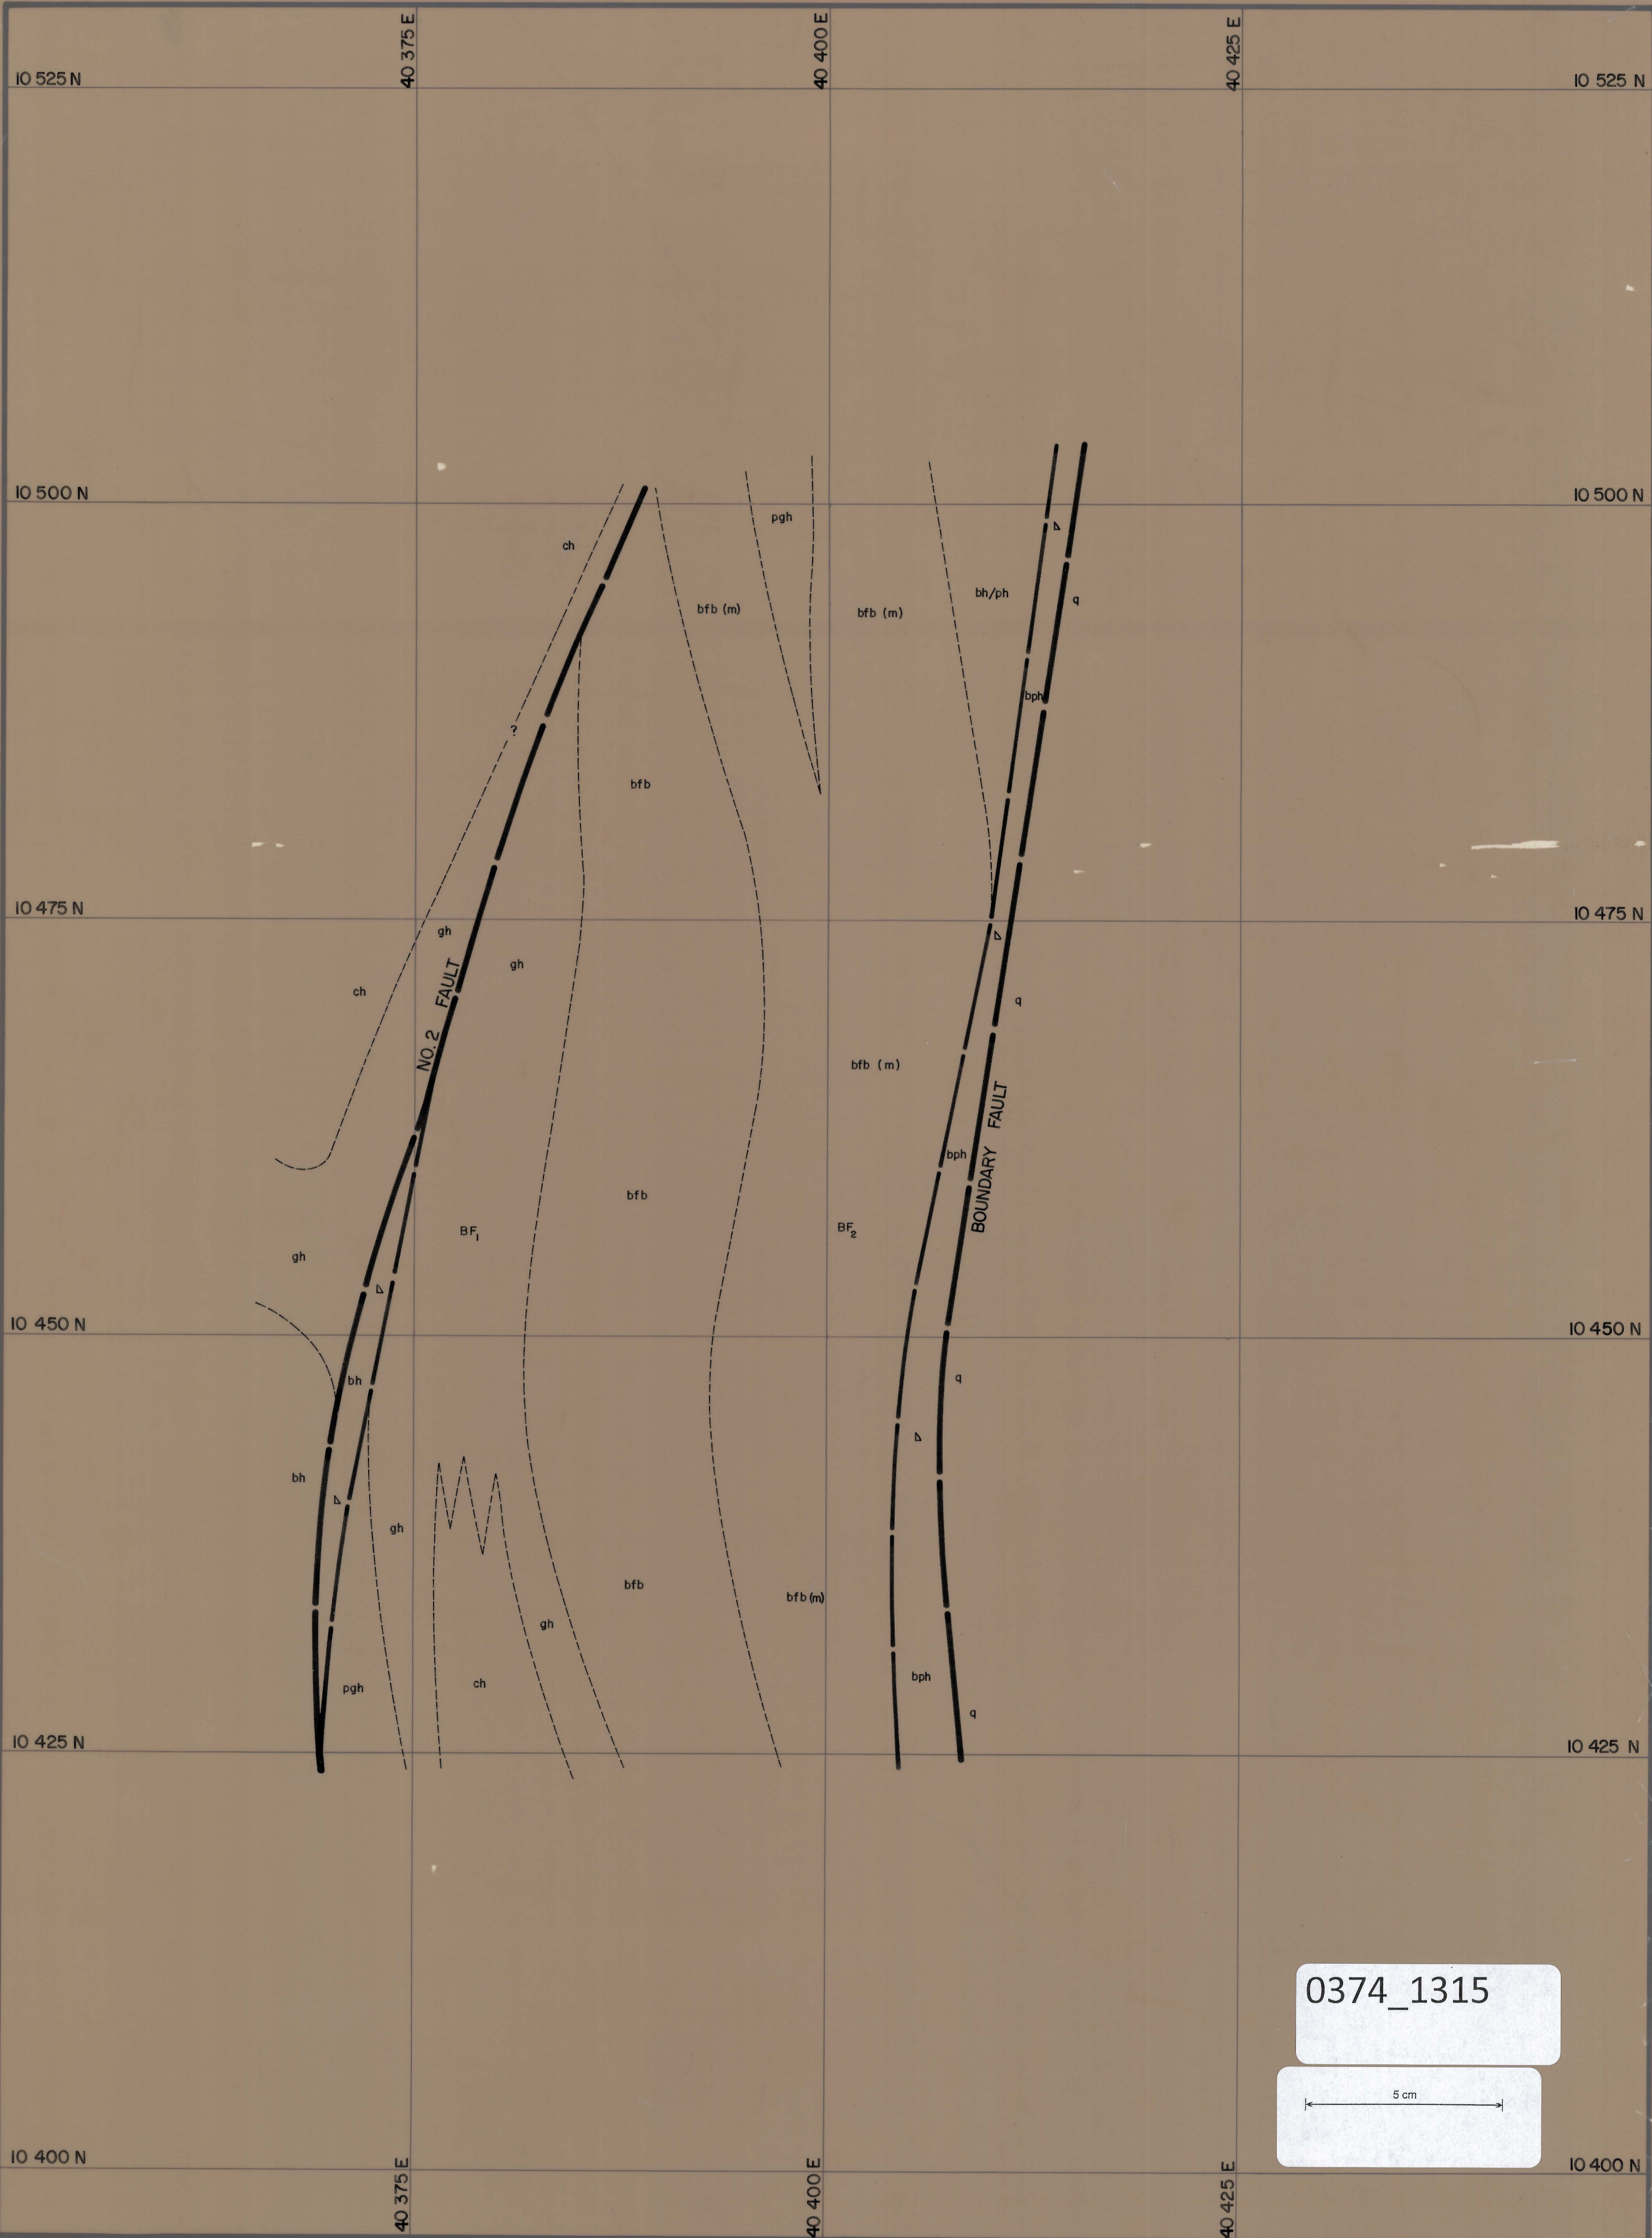

0374_1315

5 cm



DATE: Aug 76
GEOL: S.G.B.
DWN: L.G.
CHKD: M.C.R.

GEOPEKO LIMITED
KING ISLAND

Scale: 1:250

No. K93-251-012

BOLD HEAD MINE
GEOLOGICAL FLOOR PLAN
B LENS FAULT BLOCK
959m R.L.