


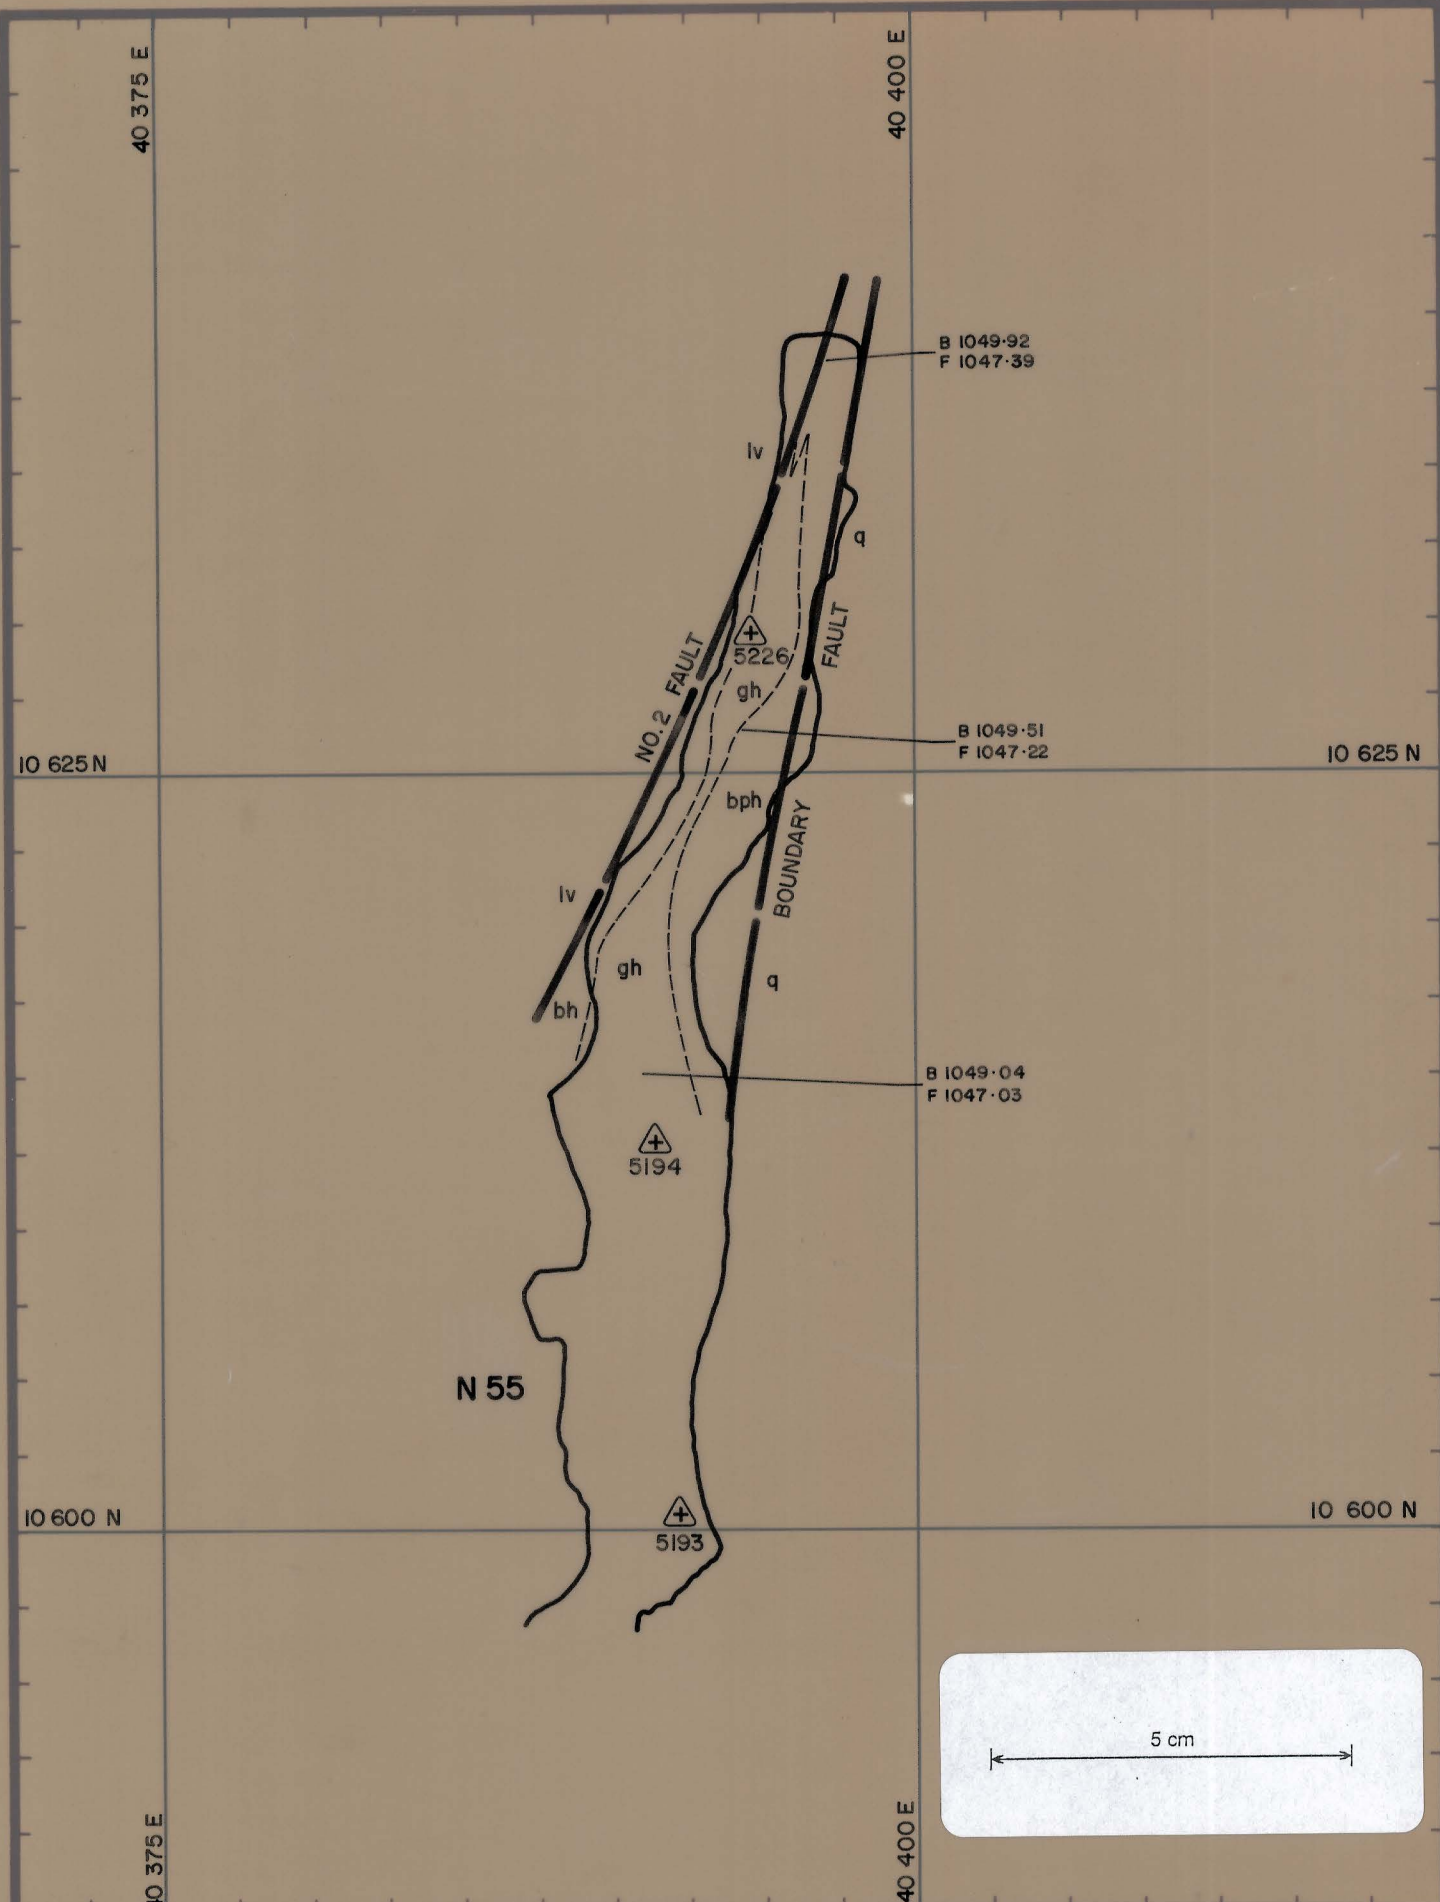

LEGEND:

0374_1336


DATE: Sept 76
GEOL: S.G.B.
DWN: L.G.
CHKD: M.C.R.

GEOPEKO LIMITED
KING ISLAND
Scale: 1: 250
N9KG3-261-003
BOLD HEAD MINE
GEOLOGICAL BACK PLAN
BOUNDARY OREBODY

0374_1336

261 K53-261-003
A Lens Back Plan