



KG3-255
 Bend Head O/B
 P.62 Stope
 4th Lift
 1:250

0374_1394

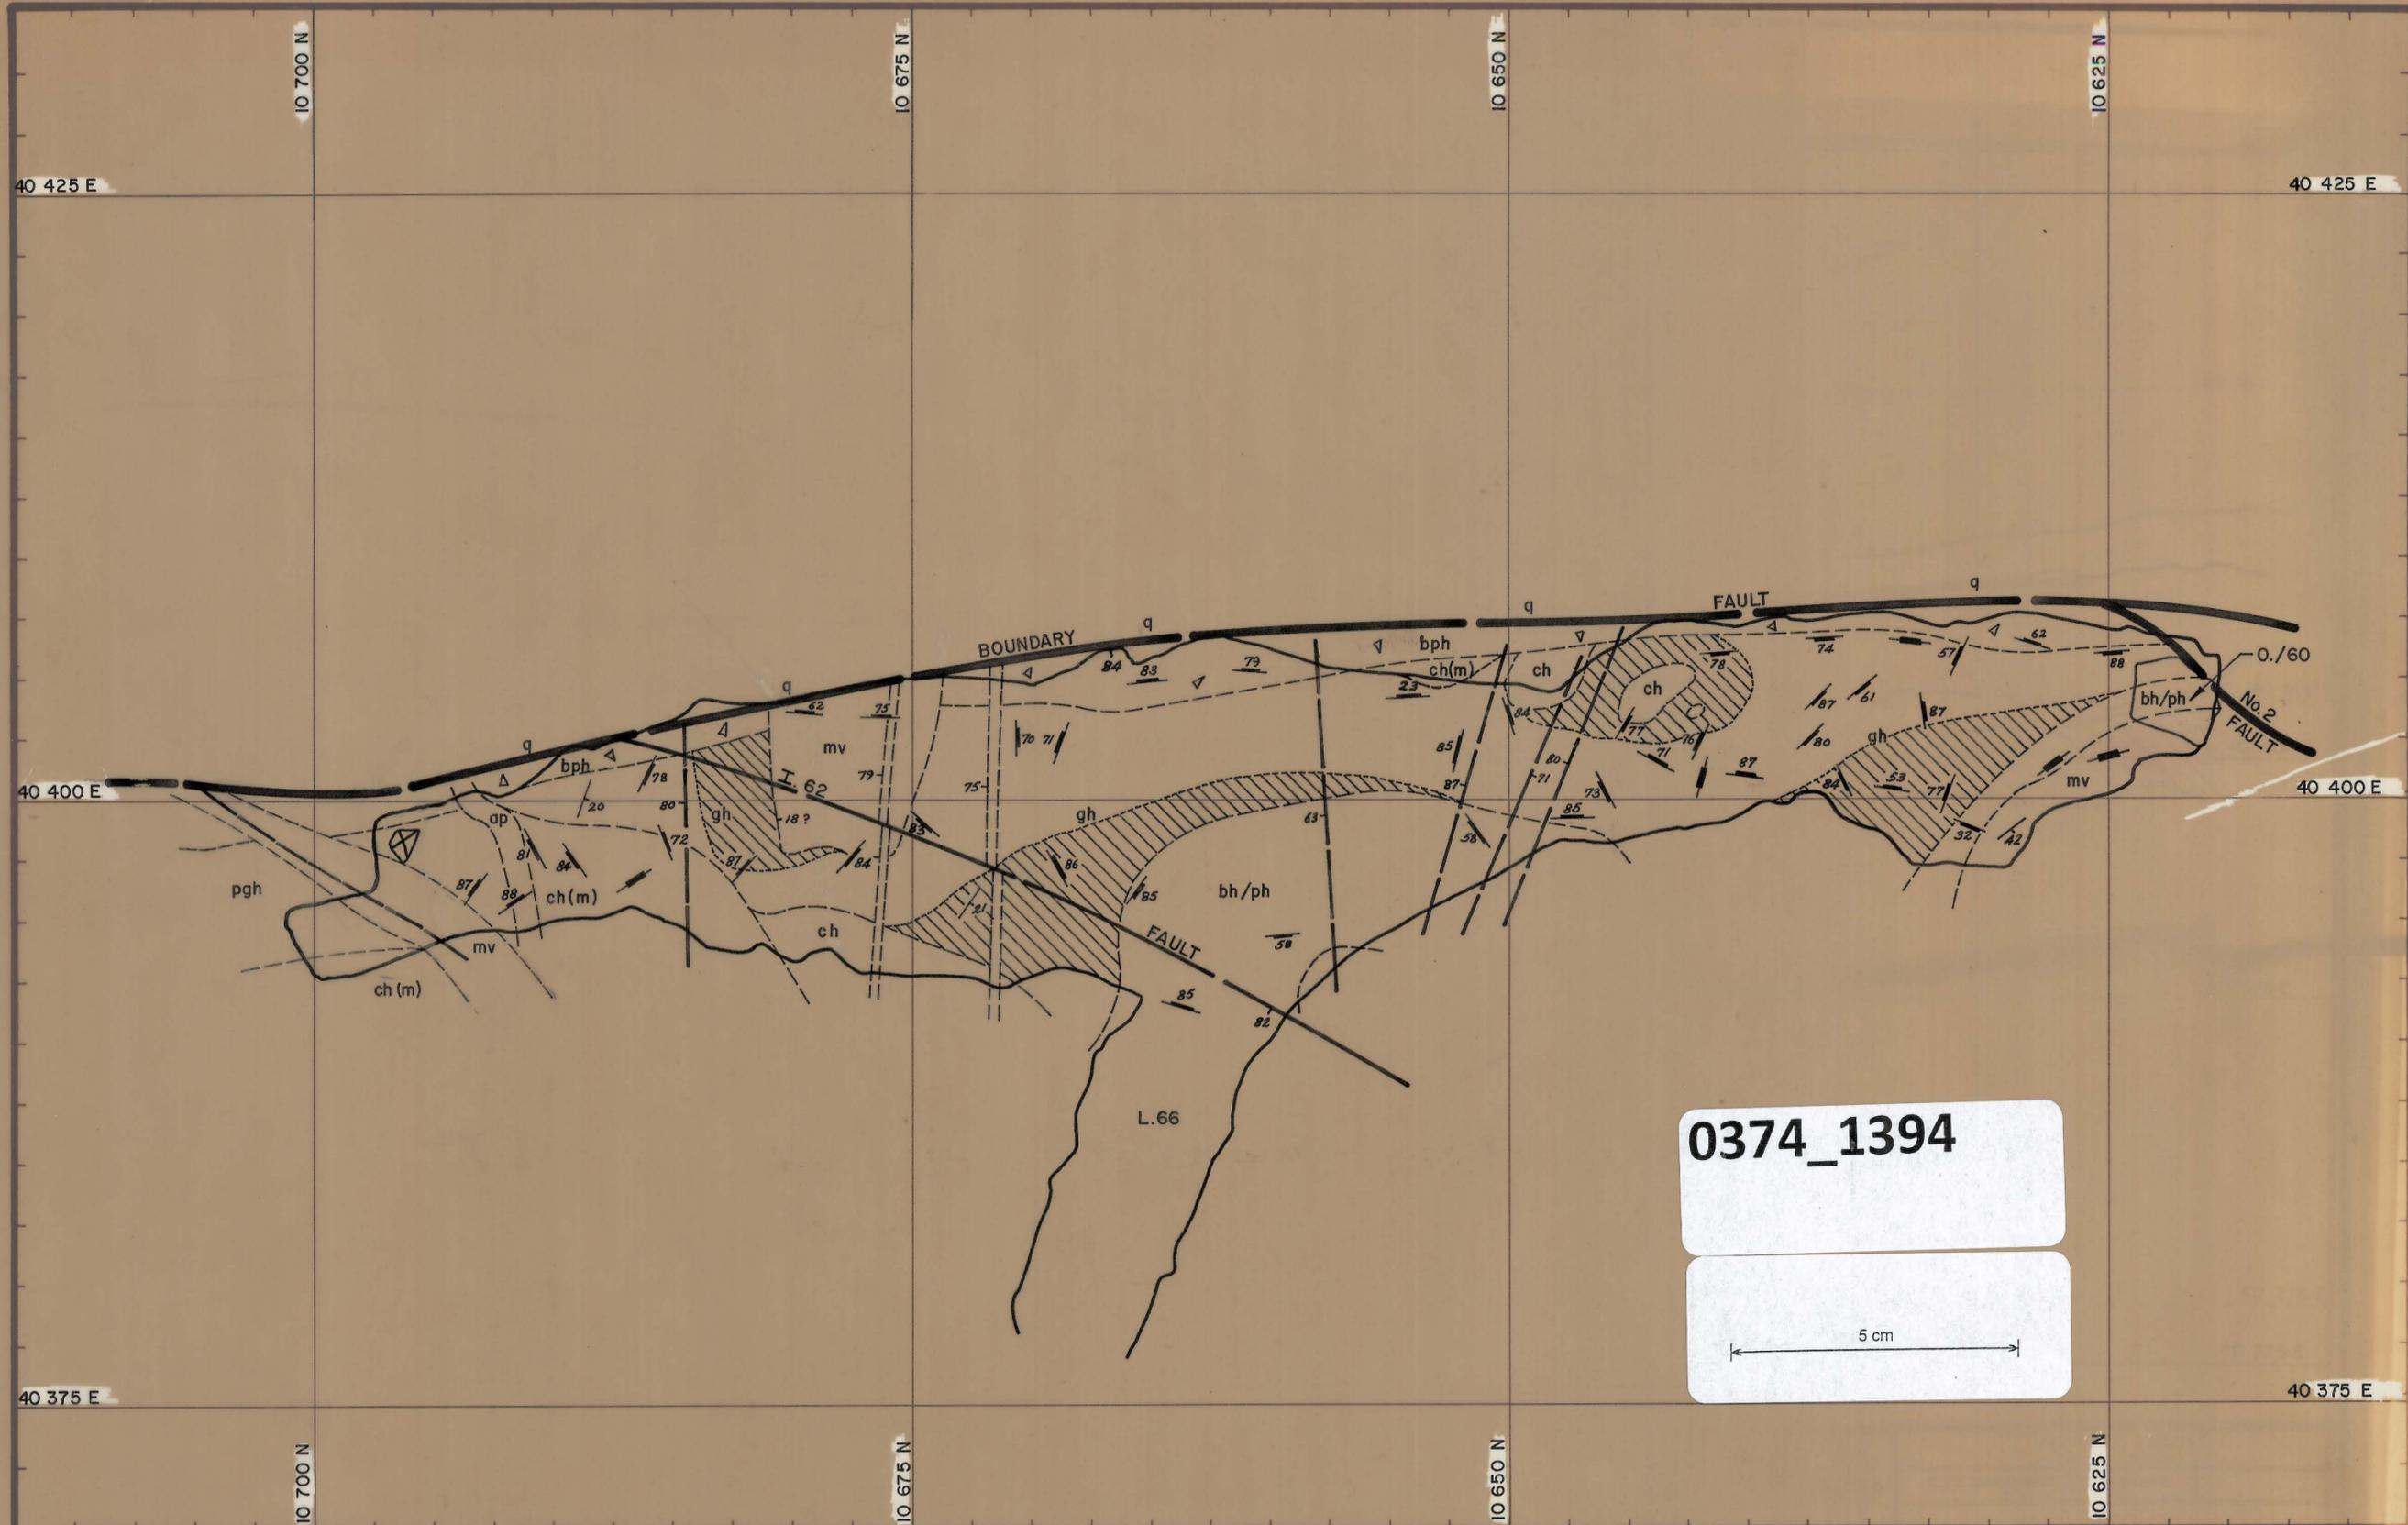

0374_1394

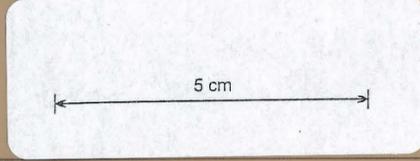

LEGEND:			
uv	Upper metavolcanics	lv	Lower metavolcanics
bh	Biotite hornfels	pgh	Pyroxene garnet hornfels
ph	Pyroxene hornfels	gh	Garnet hornfels
ch	Marble	bfb	Banded footwall beds
		q	Quartzite
		ad	Adamellite
		ap	Aplite
		△ △ △ △	Breccia
		—	Fault
		- - - - -	Geological boundary
		▨	Possible areas of thin ore.

GEOPEKO LIMITED
 KING ISLAND
 Scale: 1:250
 No. KG3-263-
 DATE: _____
 GEOL: S.G.B.
 DWN: R.F.
 CHKD: M.C.R.
BOLD HEAD OREBODY
R62 STOPE
Roof 4th Lift