


C.L.F.M.S.
082-1000

KG04BH4-1011

0374_1410

27 JUN 1981

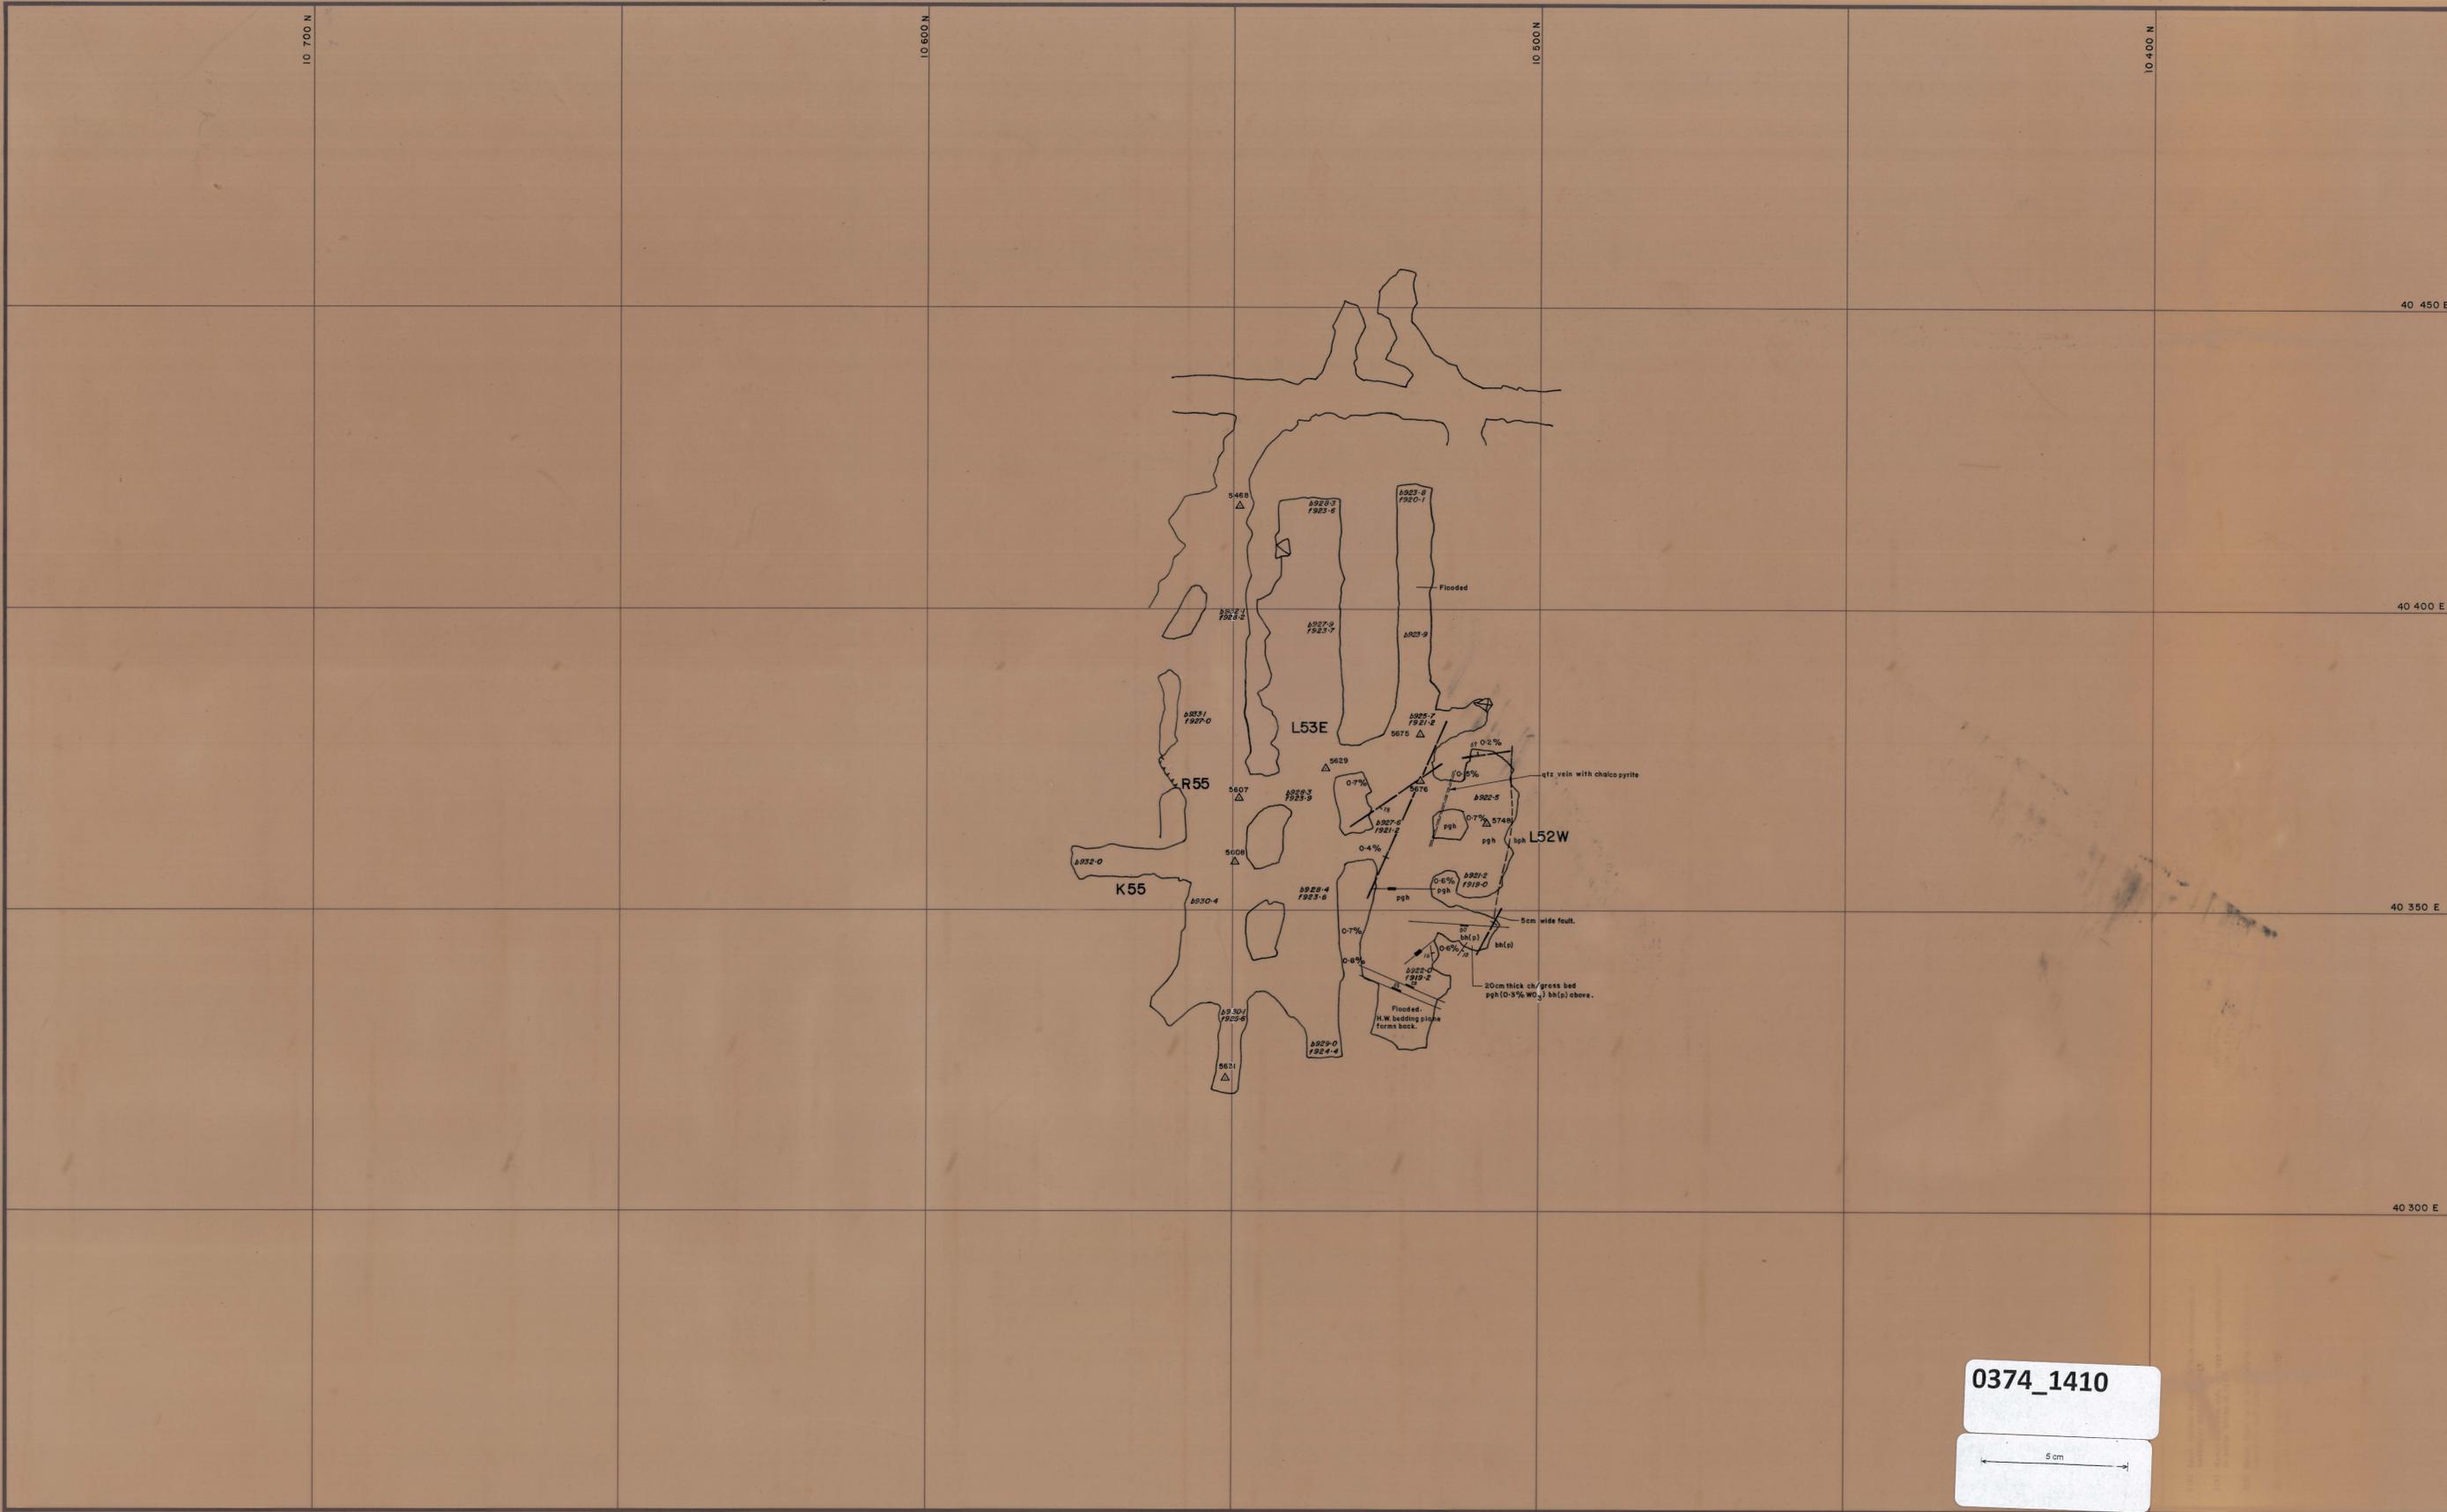

0374_1410

5 cm

LEGEND: v Upper metavolcanics bh/ph Banded hornfels ch Marble bh Biotite hornfels pgh Pyroxene garnet hornfels gh Garnet hornfels bh/ph ch/gh Banded footwall beds bph Biotite pyroxene hornfels lv Lower metavolcanics q Quartzite ap Aplites gr Granite		strike and dip strike and dip vertical joint joint vertical unconformity relative movement rise extending through level head of rise foot of rise survey station	geological boundary minor fault major fault b back f floor r road s spoil
--	--	---	---

DATE: _____
 DRAWN: M.vdS.
 GEOLOGY: R.E.S-D
 CHECKED: _____

KING ISLAND SCHEELITE

DWG. No. KG04BH4-1011

BOLD HEAD MINE

C LENS OREBODY