


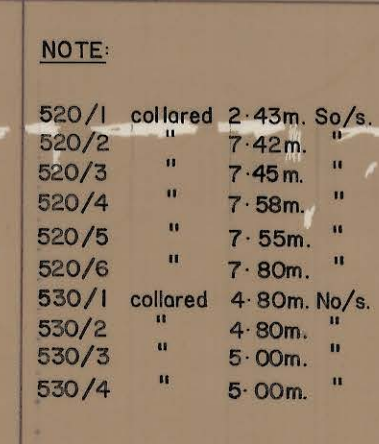

DATE: FEB, 1976

GEOLOGIST: S.G.B.

DRAWN: A.H.

CHECKED: M.C.R.

'B' LENS FAULT BLOCK