


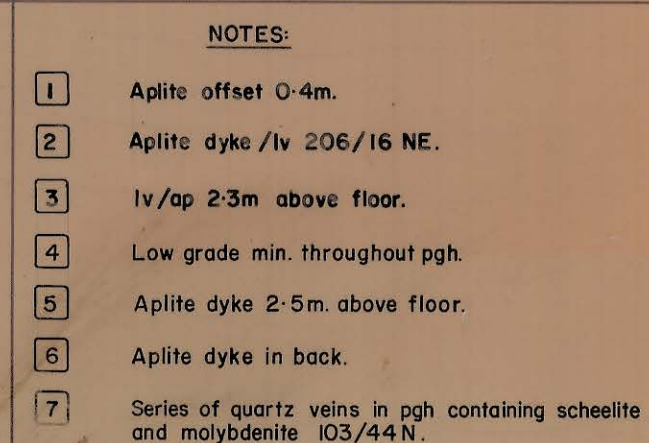

uv	Upper metavolcanics	pgh	Pyroxene garnet hornfels
bh	Biotite hornfels	gh	Mineralized skarn (>0.25% WO_3)
ph	Pyroxene hornfels	gh	Unmineralized skarn (<0.25% WO_3)
		bh/gh	Banded footwall beds

ad	Adamellite	60
ap	Aplite	55

Strike and dip
Joint, inclined
Joint, vertical
Fault
Fault showing relative movement
Degree of uncertainty in fault position

ph gh


PDH (Percussion Drill Hole) with inferred geology.

DDH (Diamond Drill Hole)

5

See top right corner.

	A	B	C
	D	E	F
	G	H	I
J	K		
N			

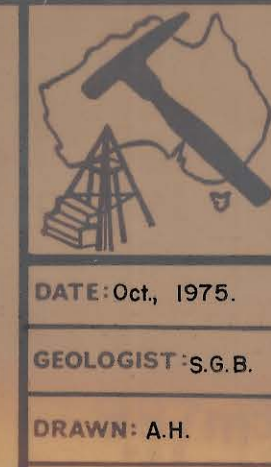

GEOPERO LIMITED
KING ISLAND GROUP

No. K63-264-001

OLD HEAD MINE
GEOLOGICAL FLOOR PLAN
N5 FAULT BLOCK
1018m PL