


0324-1535

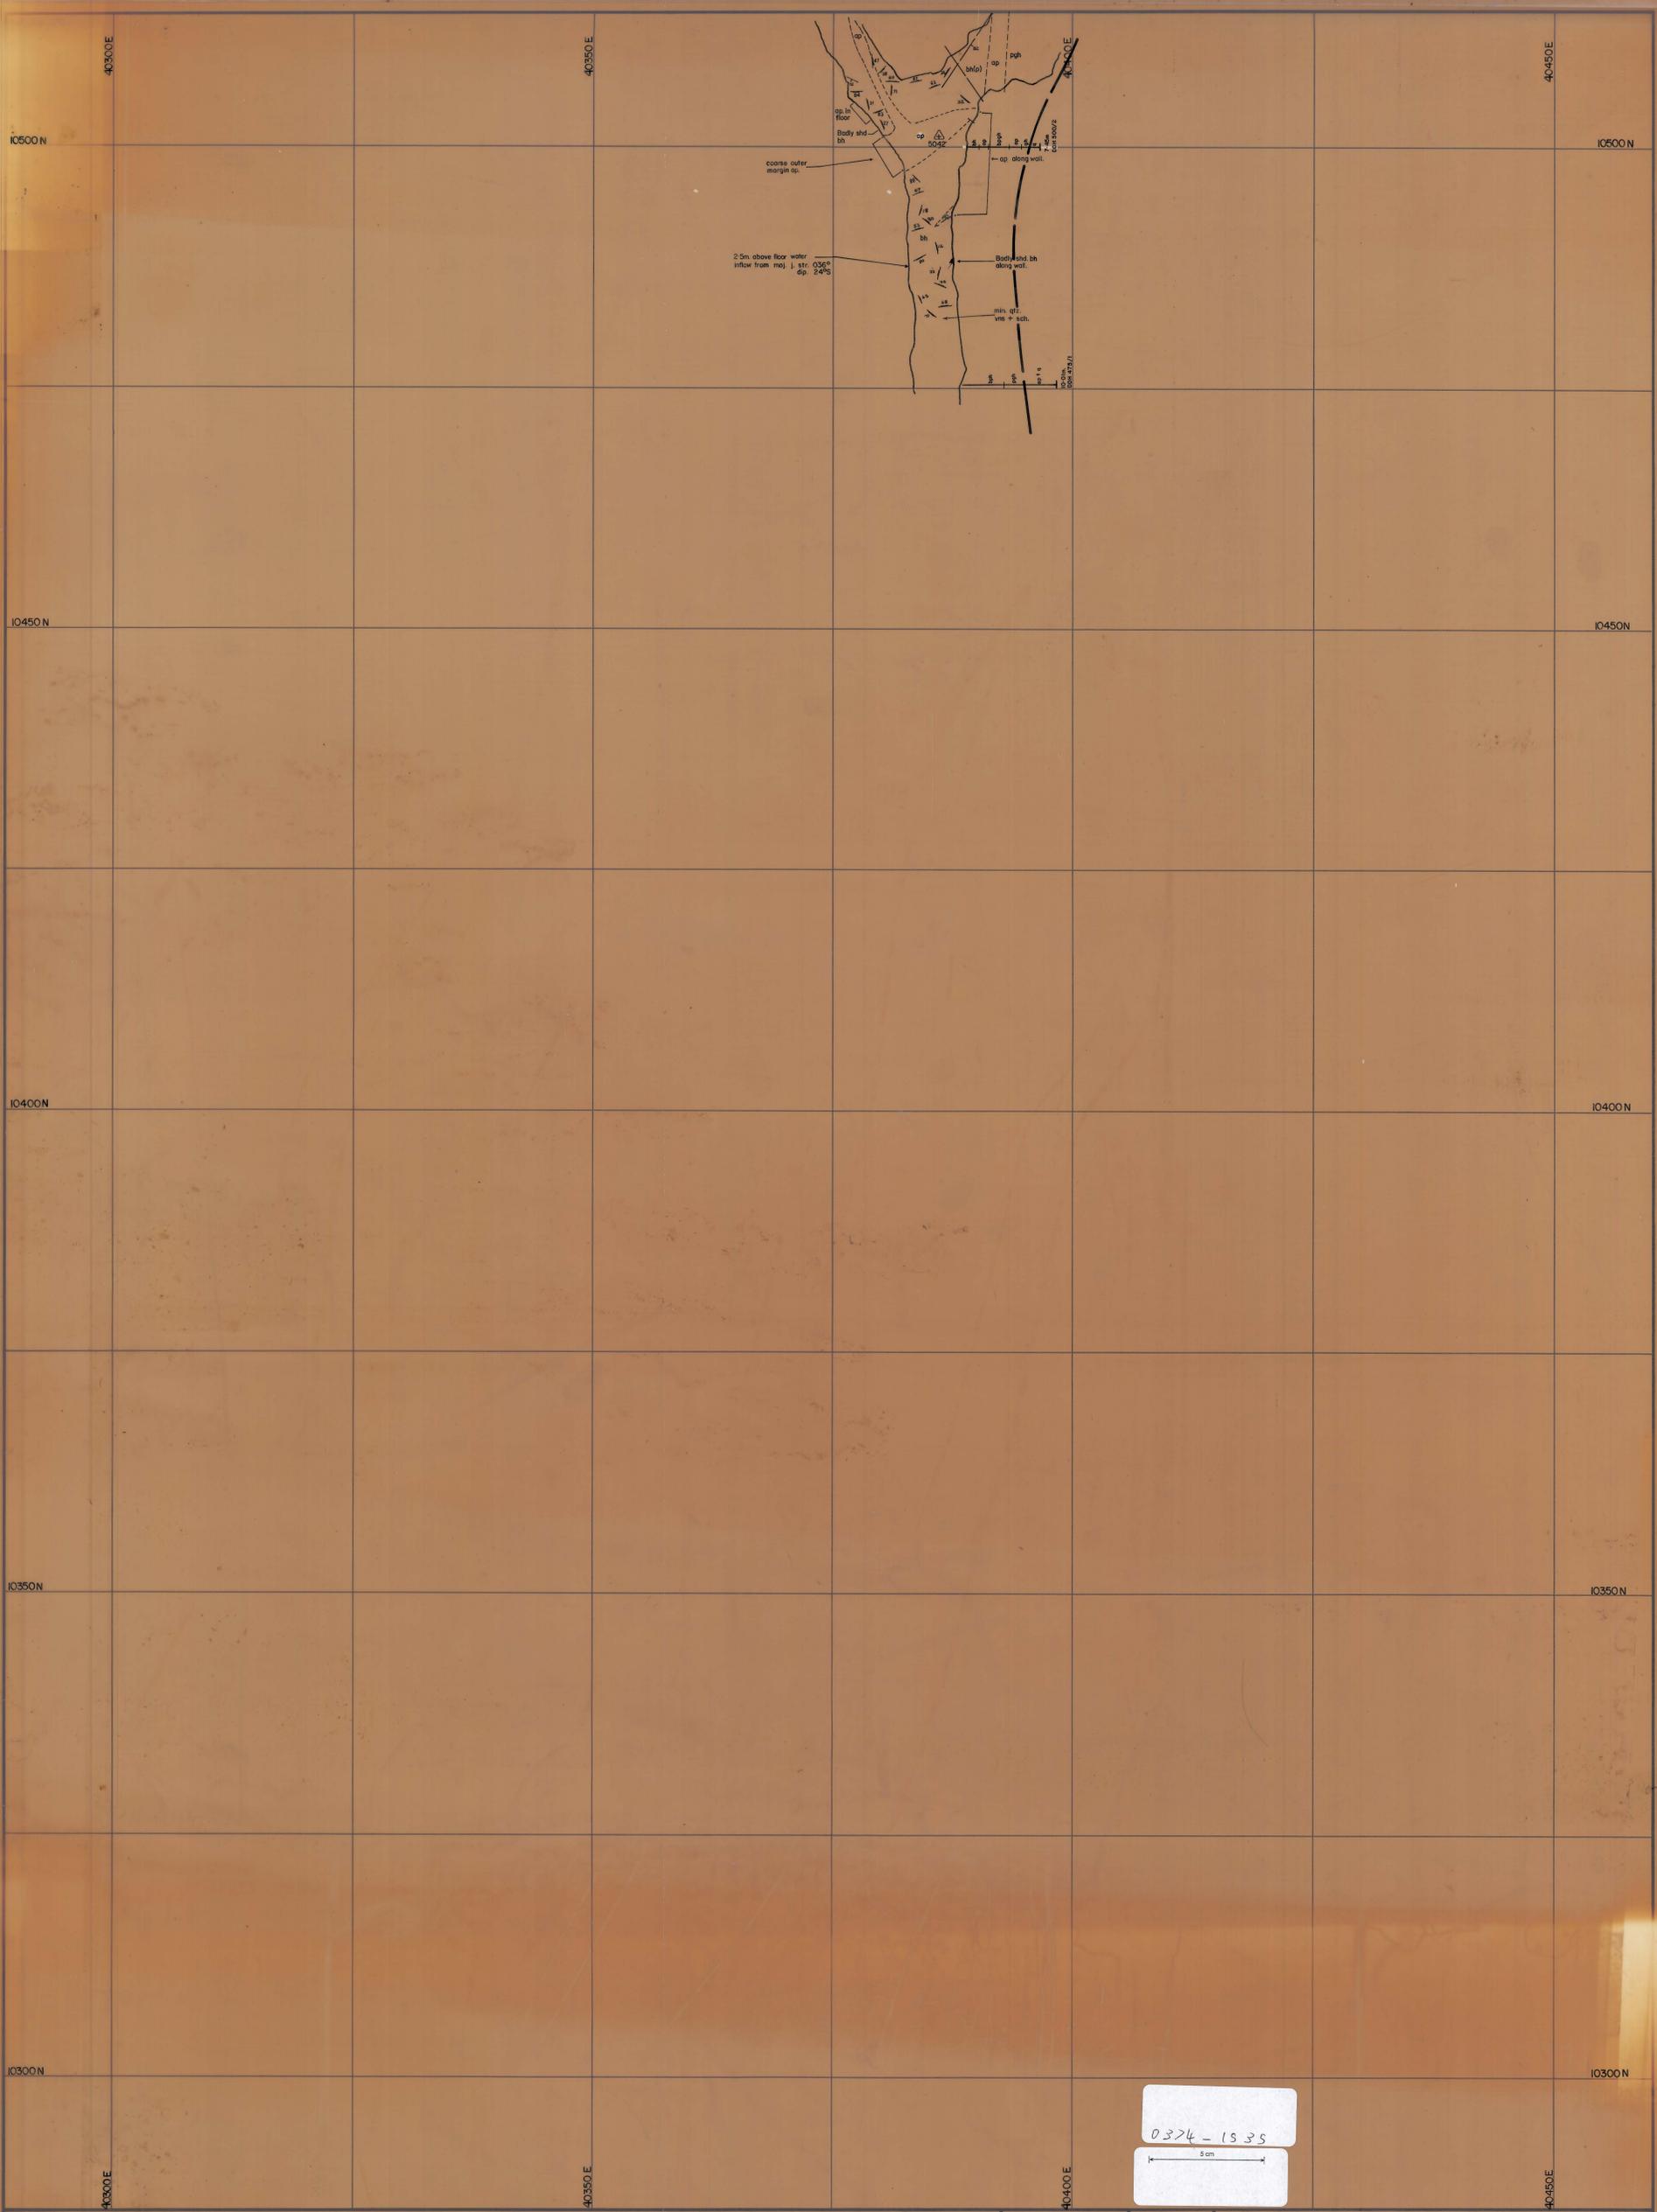

0324-1535
8 cm

LEGEND: uv Upper metavolcanics bh Basite hornfels pgh Pyroxene garnet hornfels gh Mineralized skarn (>0.25% WO ₃) sh Unmineralized skarn (<0.25% WO ₃)		ad Adamellite ap Apatite		60 Strike and dip 30 Joint, inclined Joint, vertical Fault Fault showing relative movement		PDH (Percussion Drill Hole) with inferred geology. DDH (Diamond Drill Hole)		A B C D E F G H I J K N		DATE: JAN, 1975 GEOLOGIST: S.G.B. DRAWN: A.H. CHECKED: M.C.R.		GEOPEKO LIMITED KING ISLAND GROUP No. K93-264-002 SCALE: 1:250 BOLD HEAD MINE GEOLOGICAL MAP 'B' LENS FAULT BLOCK	
--	--	-----------------------------	--	--	--	--	--	-------------------------------------	--	--	--	---	--