



0374_1568

40 415 E LONG SECT.
T47 AREA

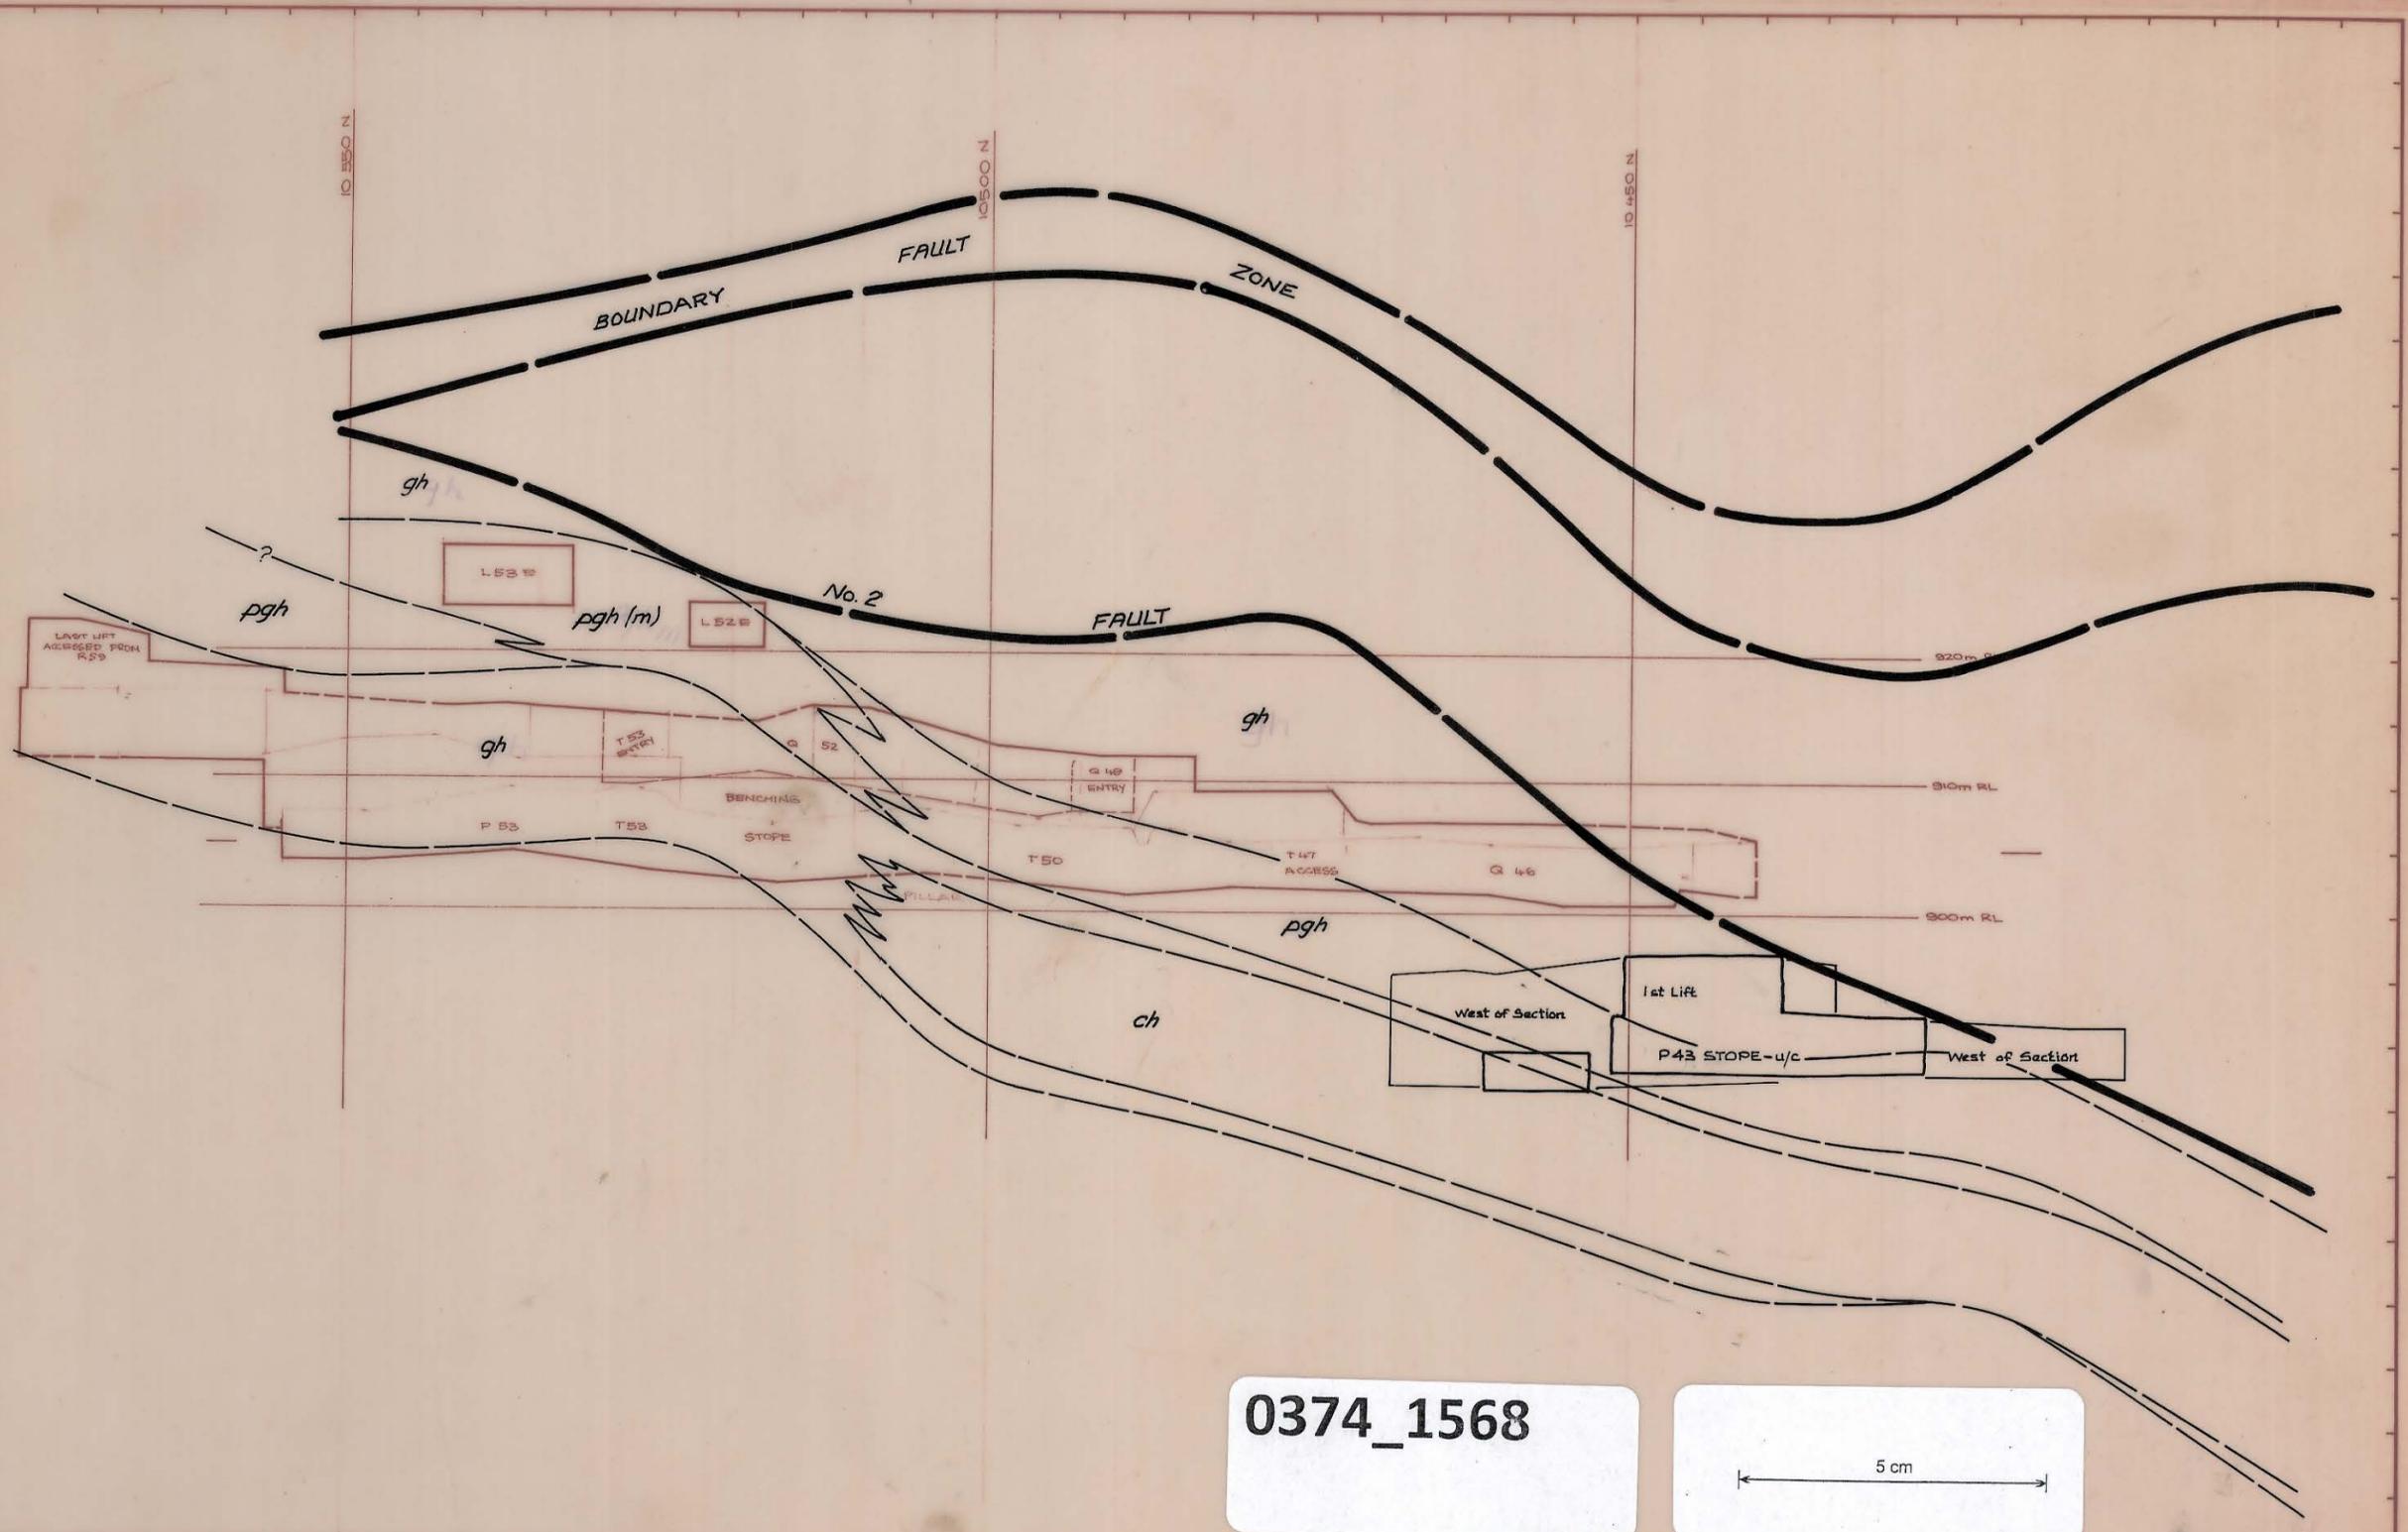

0374_1568

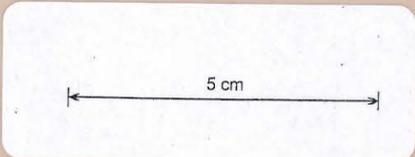

REF. PLAN	GEOLOGY	<i>S.F.B.</i>	<i>13-8-82</i>	SCALE 1: 500	
	SURVEY				
	PLANNING			BOLD HEAD MINE LONG SECTION 40 415 E	
	ROCK MEC.				
	GRADE CON.				
	DRAFTING	<i>[Signature]</i>	<i>13-8-82</i>		
T.S.S.			DRAWING NUMBER	04BH22 - 3003	