



0374-162

04BH15-107-97

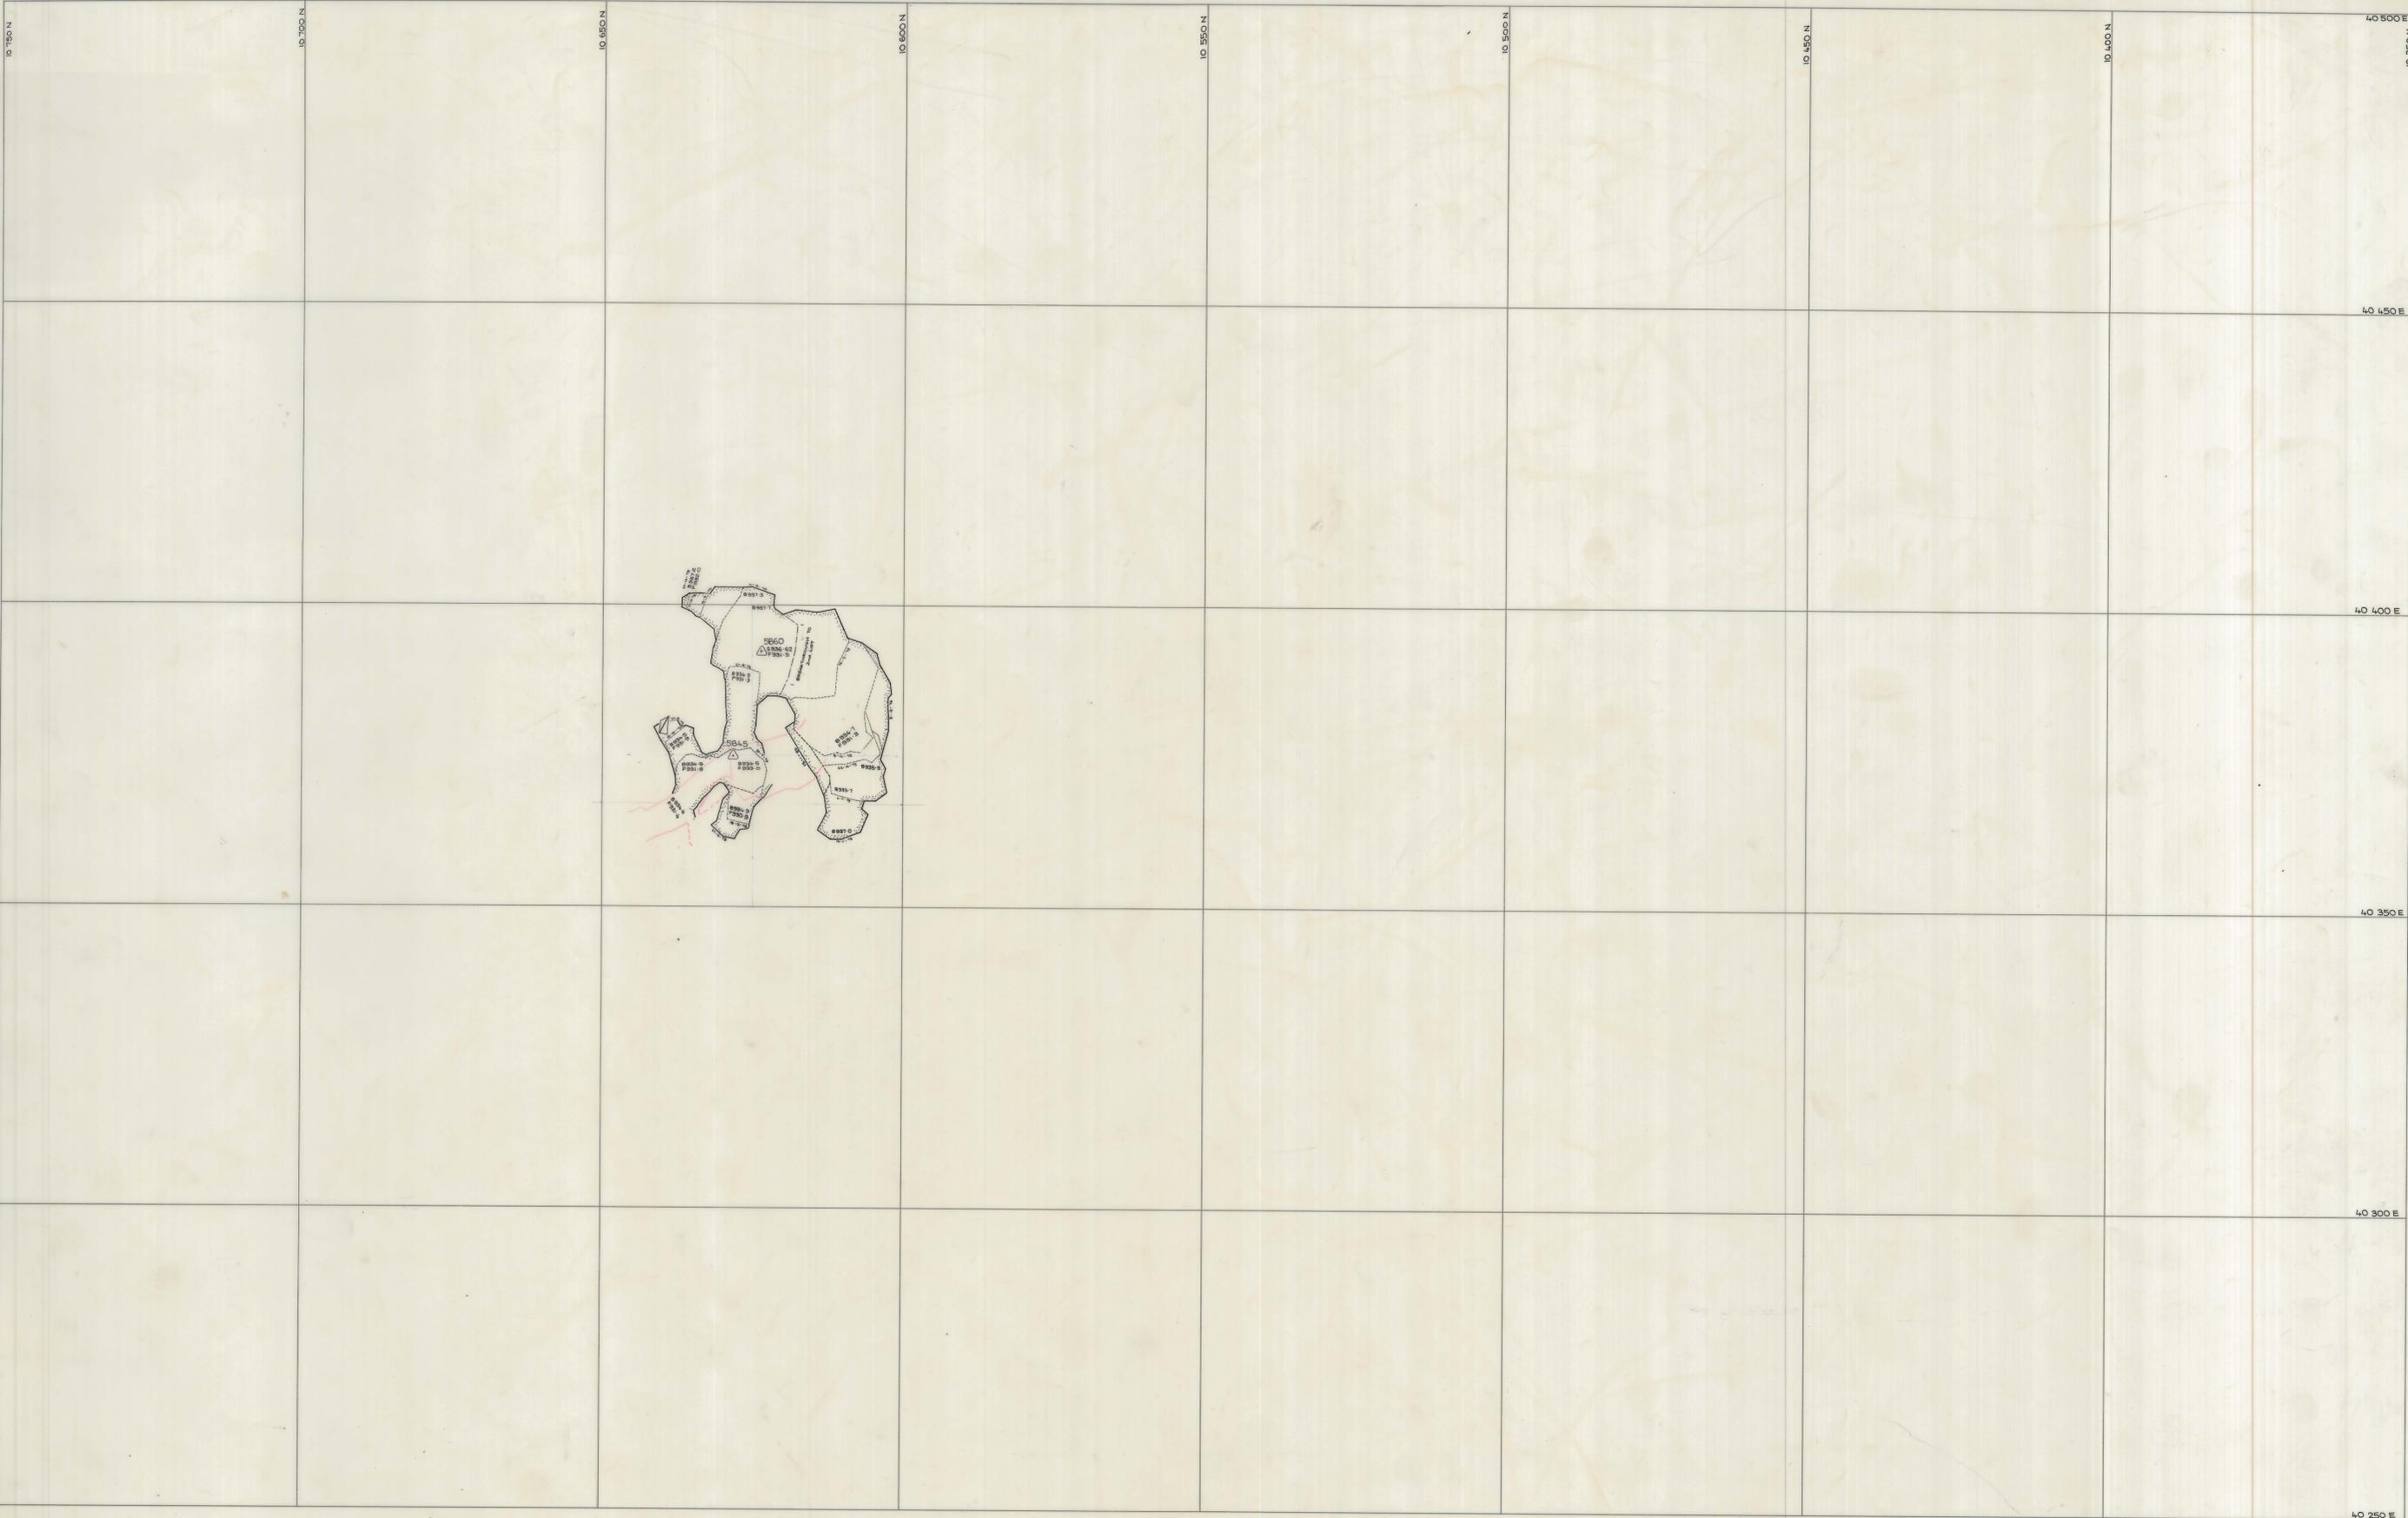

SCALE 1:500

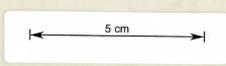

north

LOCATION

BOLD HEAD MINE

SUBJECT

C₂ OREBODY

R 60 - 3rd lift



PLAN NUMBER 107-97

04BH15 - 107 - 97