


0374 - 165

04BH15 - 108 - 98



SCALE 1: 500

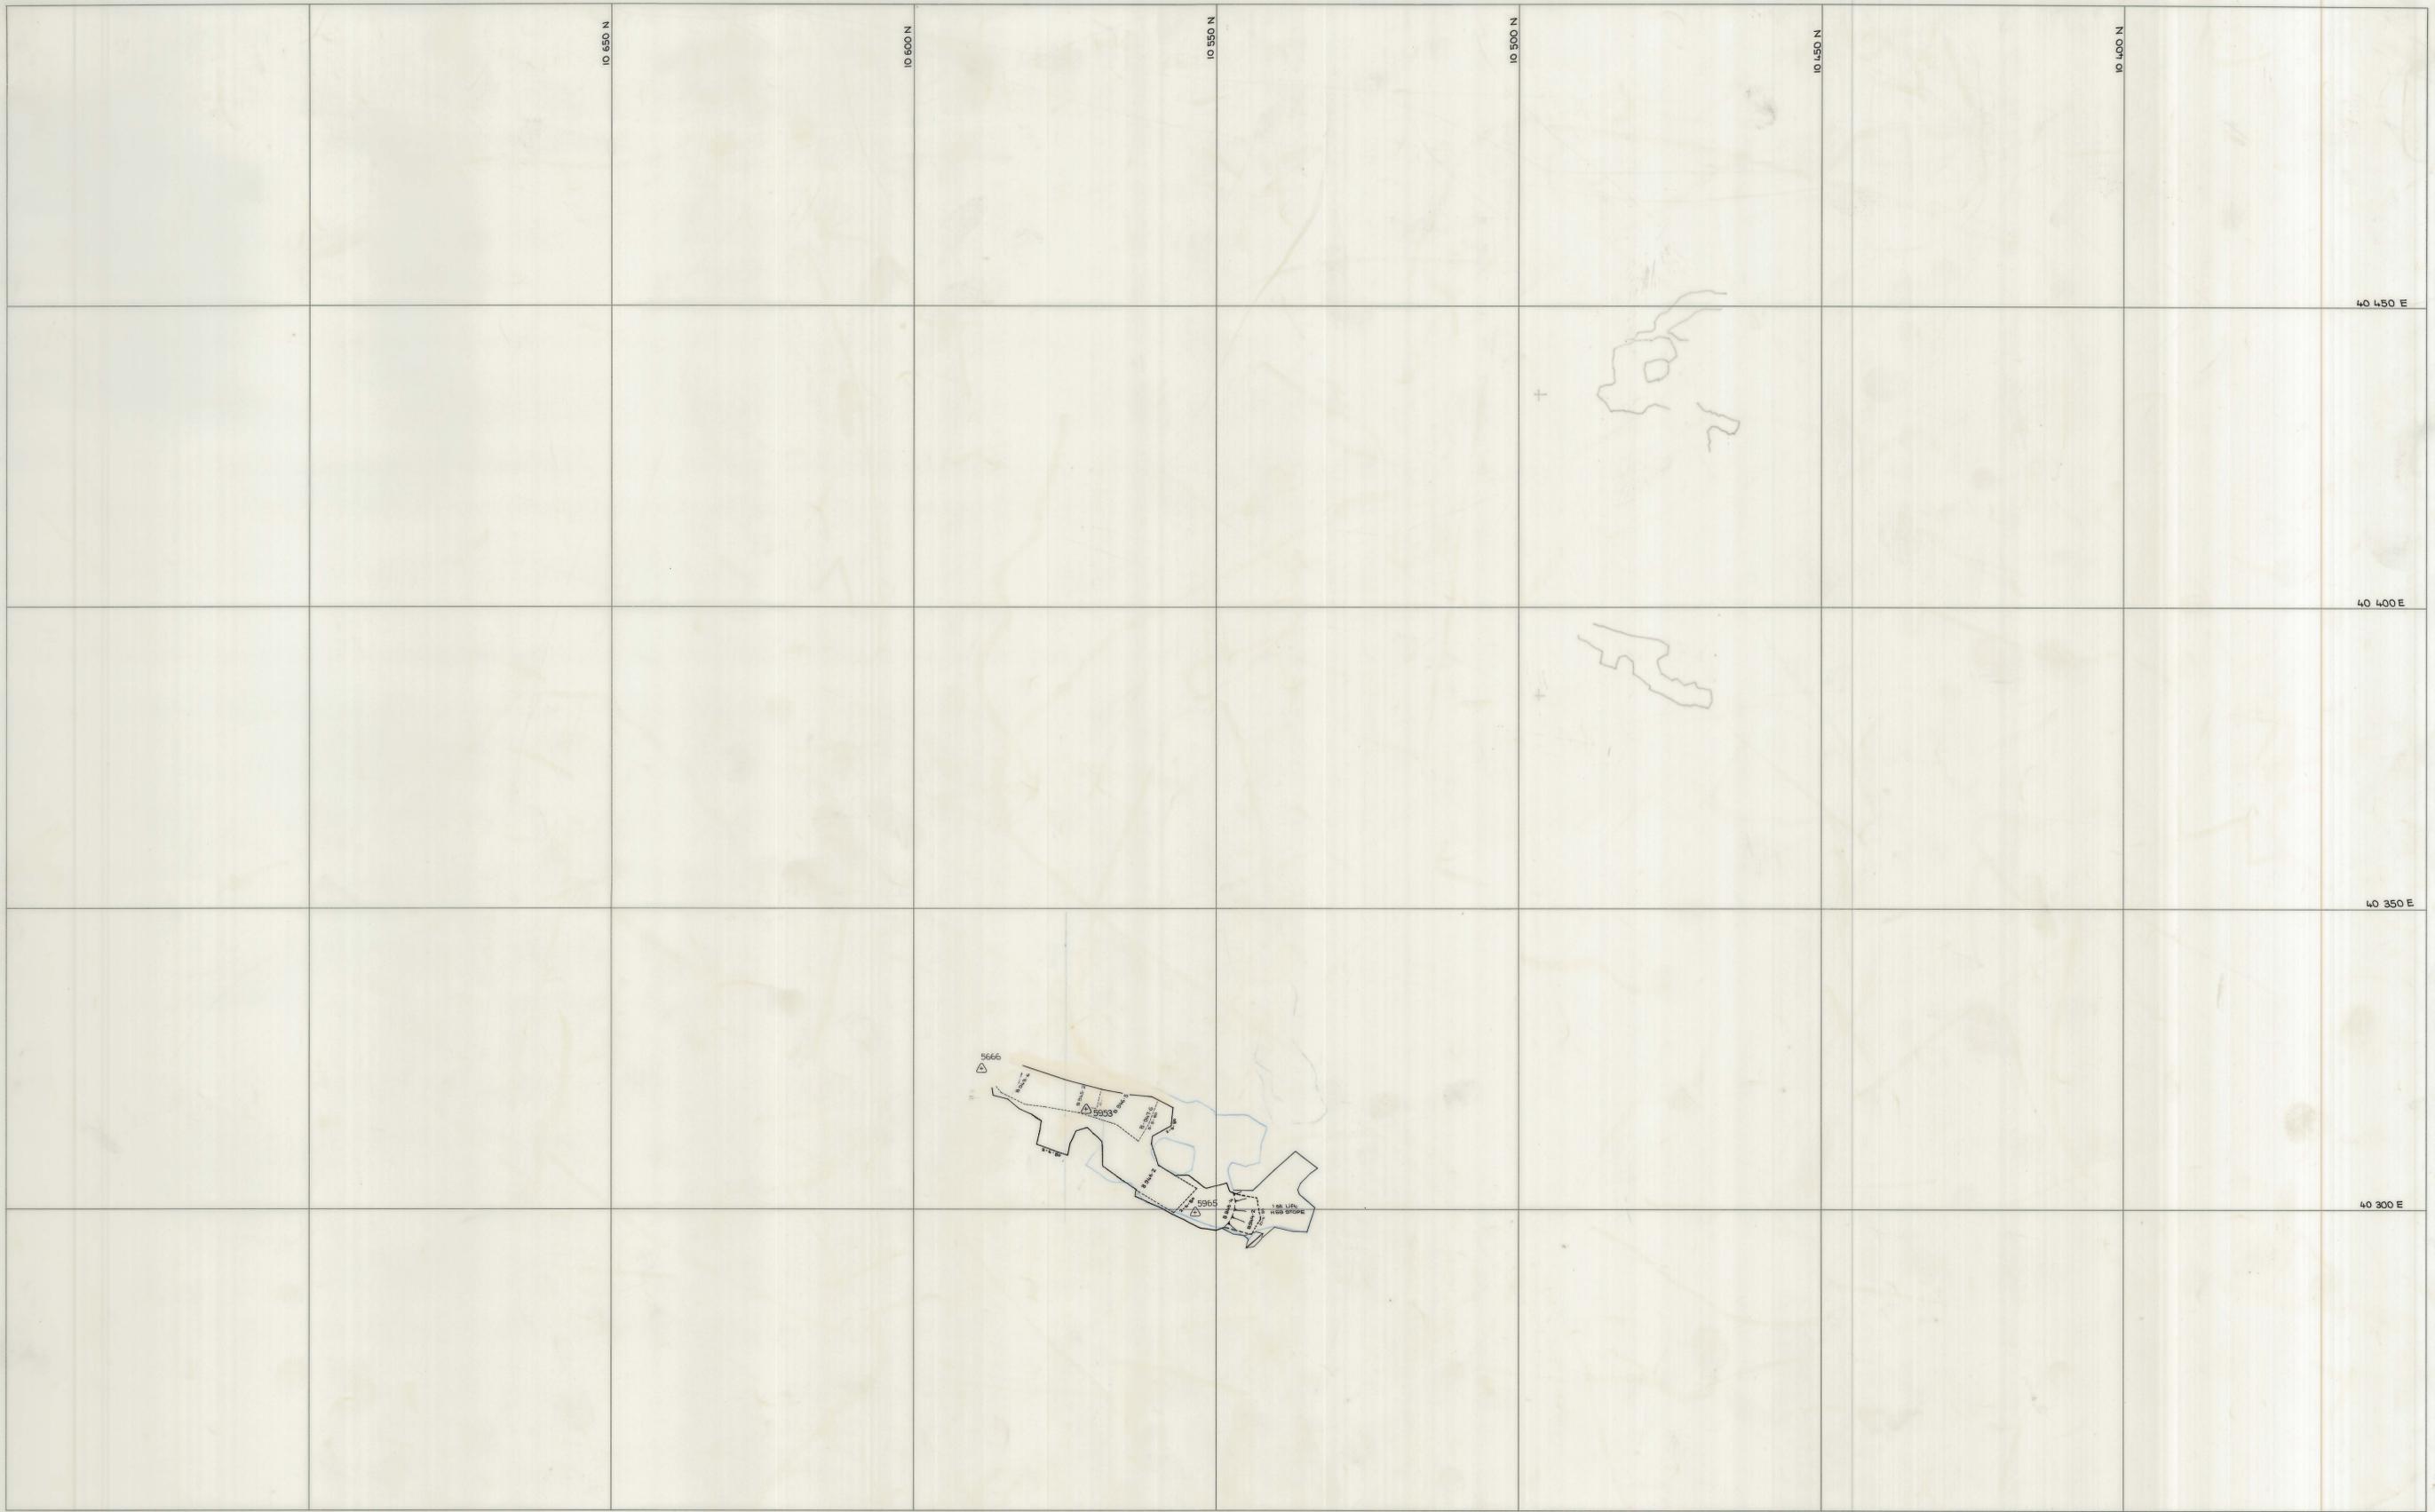

north

LOCATION	BOLD	HEAD	MINE
SUBJECT	H 59 - 2nd lift		



PLAN NUMBER 04BH15 - 108 - 98