


0374_1670

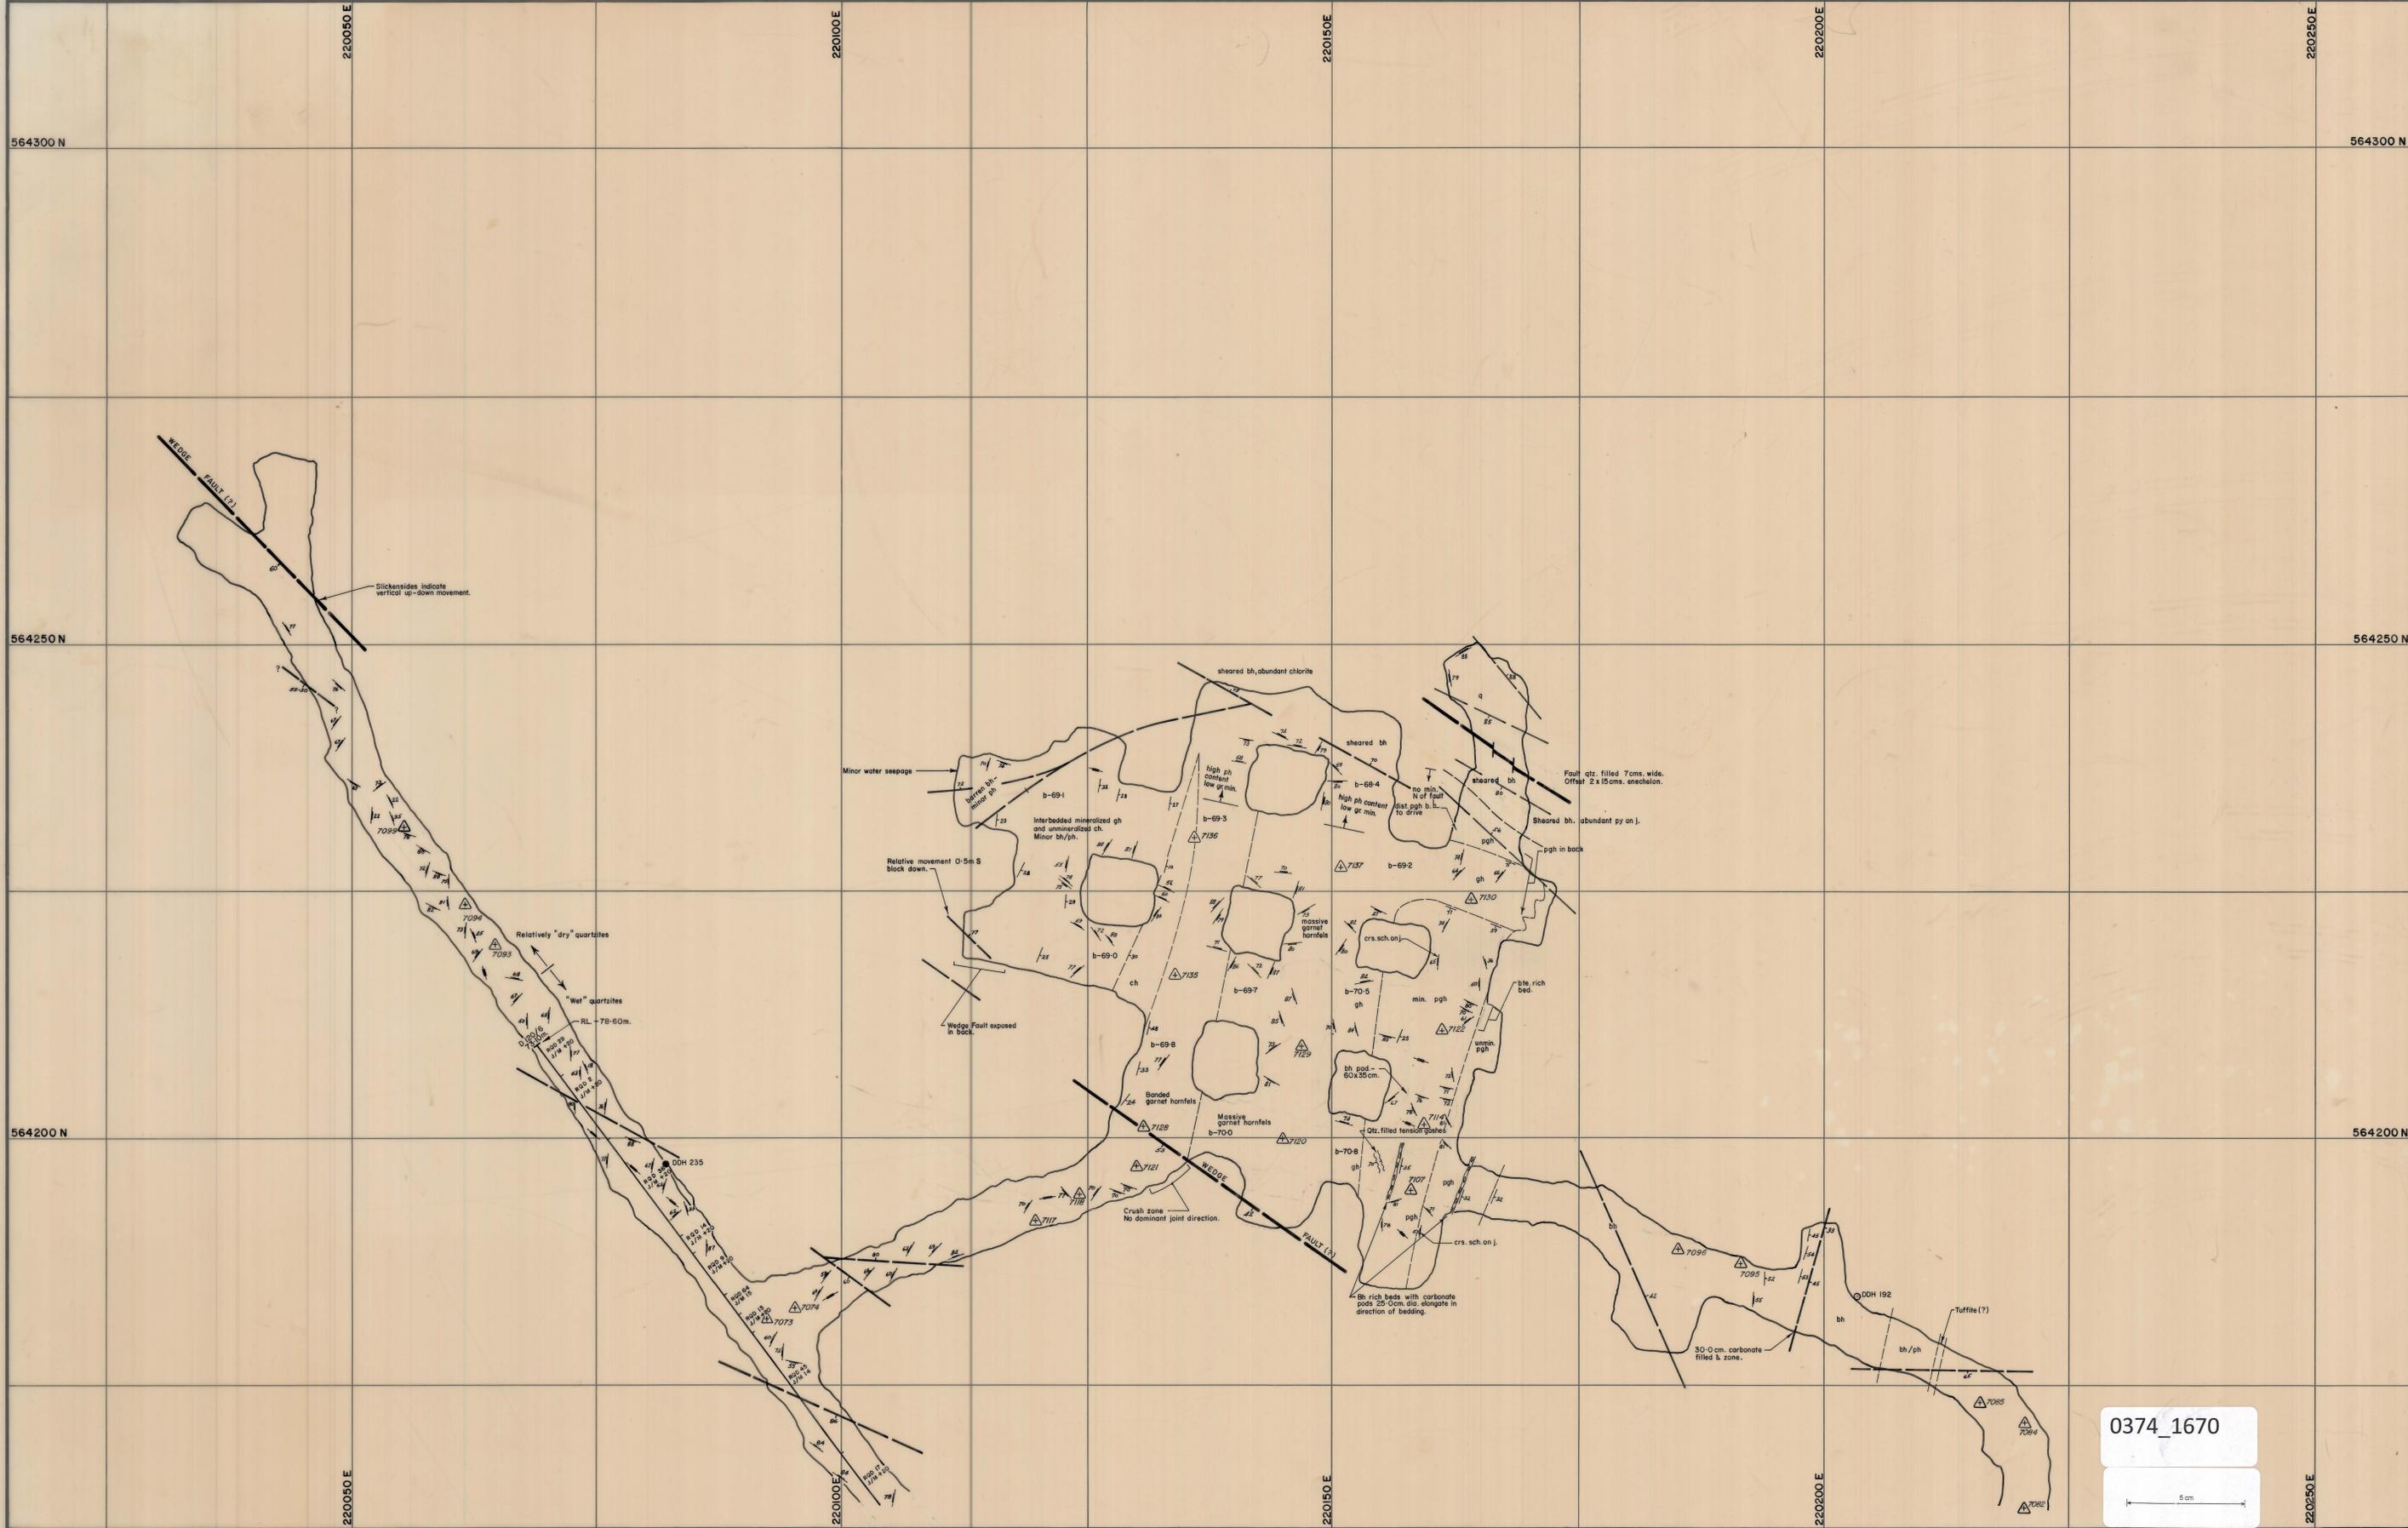

0374_1670

5 cm

- Legend:**
- v Upper metavolcanics
 - sh/bh Banded hornfels
 - ch Marble
 - bh Biotite hornfels
 - pgh Pyroxene garnet hornfels
 - gh Garnet hornfels
 - 60 Banded footwall beds
 - bph Biotite pyroxene hornfels
 - lv Lower metavolcanics
 - q Quartzite
 - ap Aplite
 - 60 Strike and dip
 - 55 Joint, inclined
 - Joint, vertical
 - Fault
 - Degree of uncertainty in Fault position
 - Mapping height = -73.2m approx.
 - b = Back height in metres.

DATE: AUG., 1974
 GEOLOGIST: M.J.G.
 DRAWN: R.F.
 CHECKED: M.C.R.

GEOPEKO LIMITED
KING ISLAND GROUP

DOLPHIN MINE
GEOLOGICAL MAP
-75m. R.L.

No. KG2-071-001