

KG2-071-002
071

0374_1671



-69.5m. R.L.



-66.5m. R.L.




-63.5m. R.L.

0374_1671

5 cm

Legend:			
v	Upper metavolcanics	BR/gh	Banded footwall beds
ph/bh	Banded hornfels	gh	Biotite pyroxene hornfels
ch	Marble	lv	Lower metavolcanics
bh	Biotite hornfels	q	Quartzite
pgh	Pyroxene garnet hornfels	ap	Aplite
gh	Garnet hornfels		
		60	Strike and dip
		55	Joint, inclined
			Joint, vertical
			Fault
			Degree of uncertainty in Fault position
		b-65-5	Back height in metres

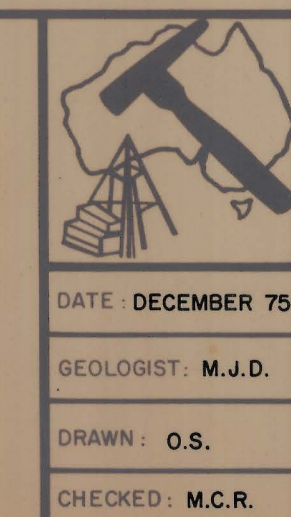

GEOPEKO LIMITED
KING ISLAND GROUP

SCALE: 1:250

No. KG2-071-002

DOLPHIN MINE
GEOLOGICAL MAPS
-63.5m, -66.5m & -69.5m R.Ls.

DATE: DECEMBER 75
GEOLOGIST: M.J.D.
DRAWN: O.S.
CHECKED: M.C.R.