


04 DM15-1058

0374_1678

27 JUN 1981

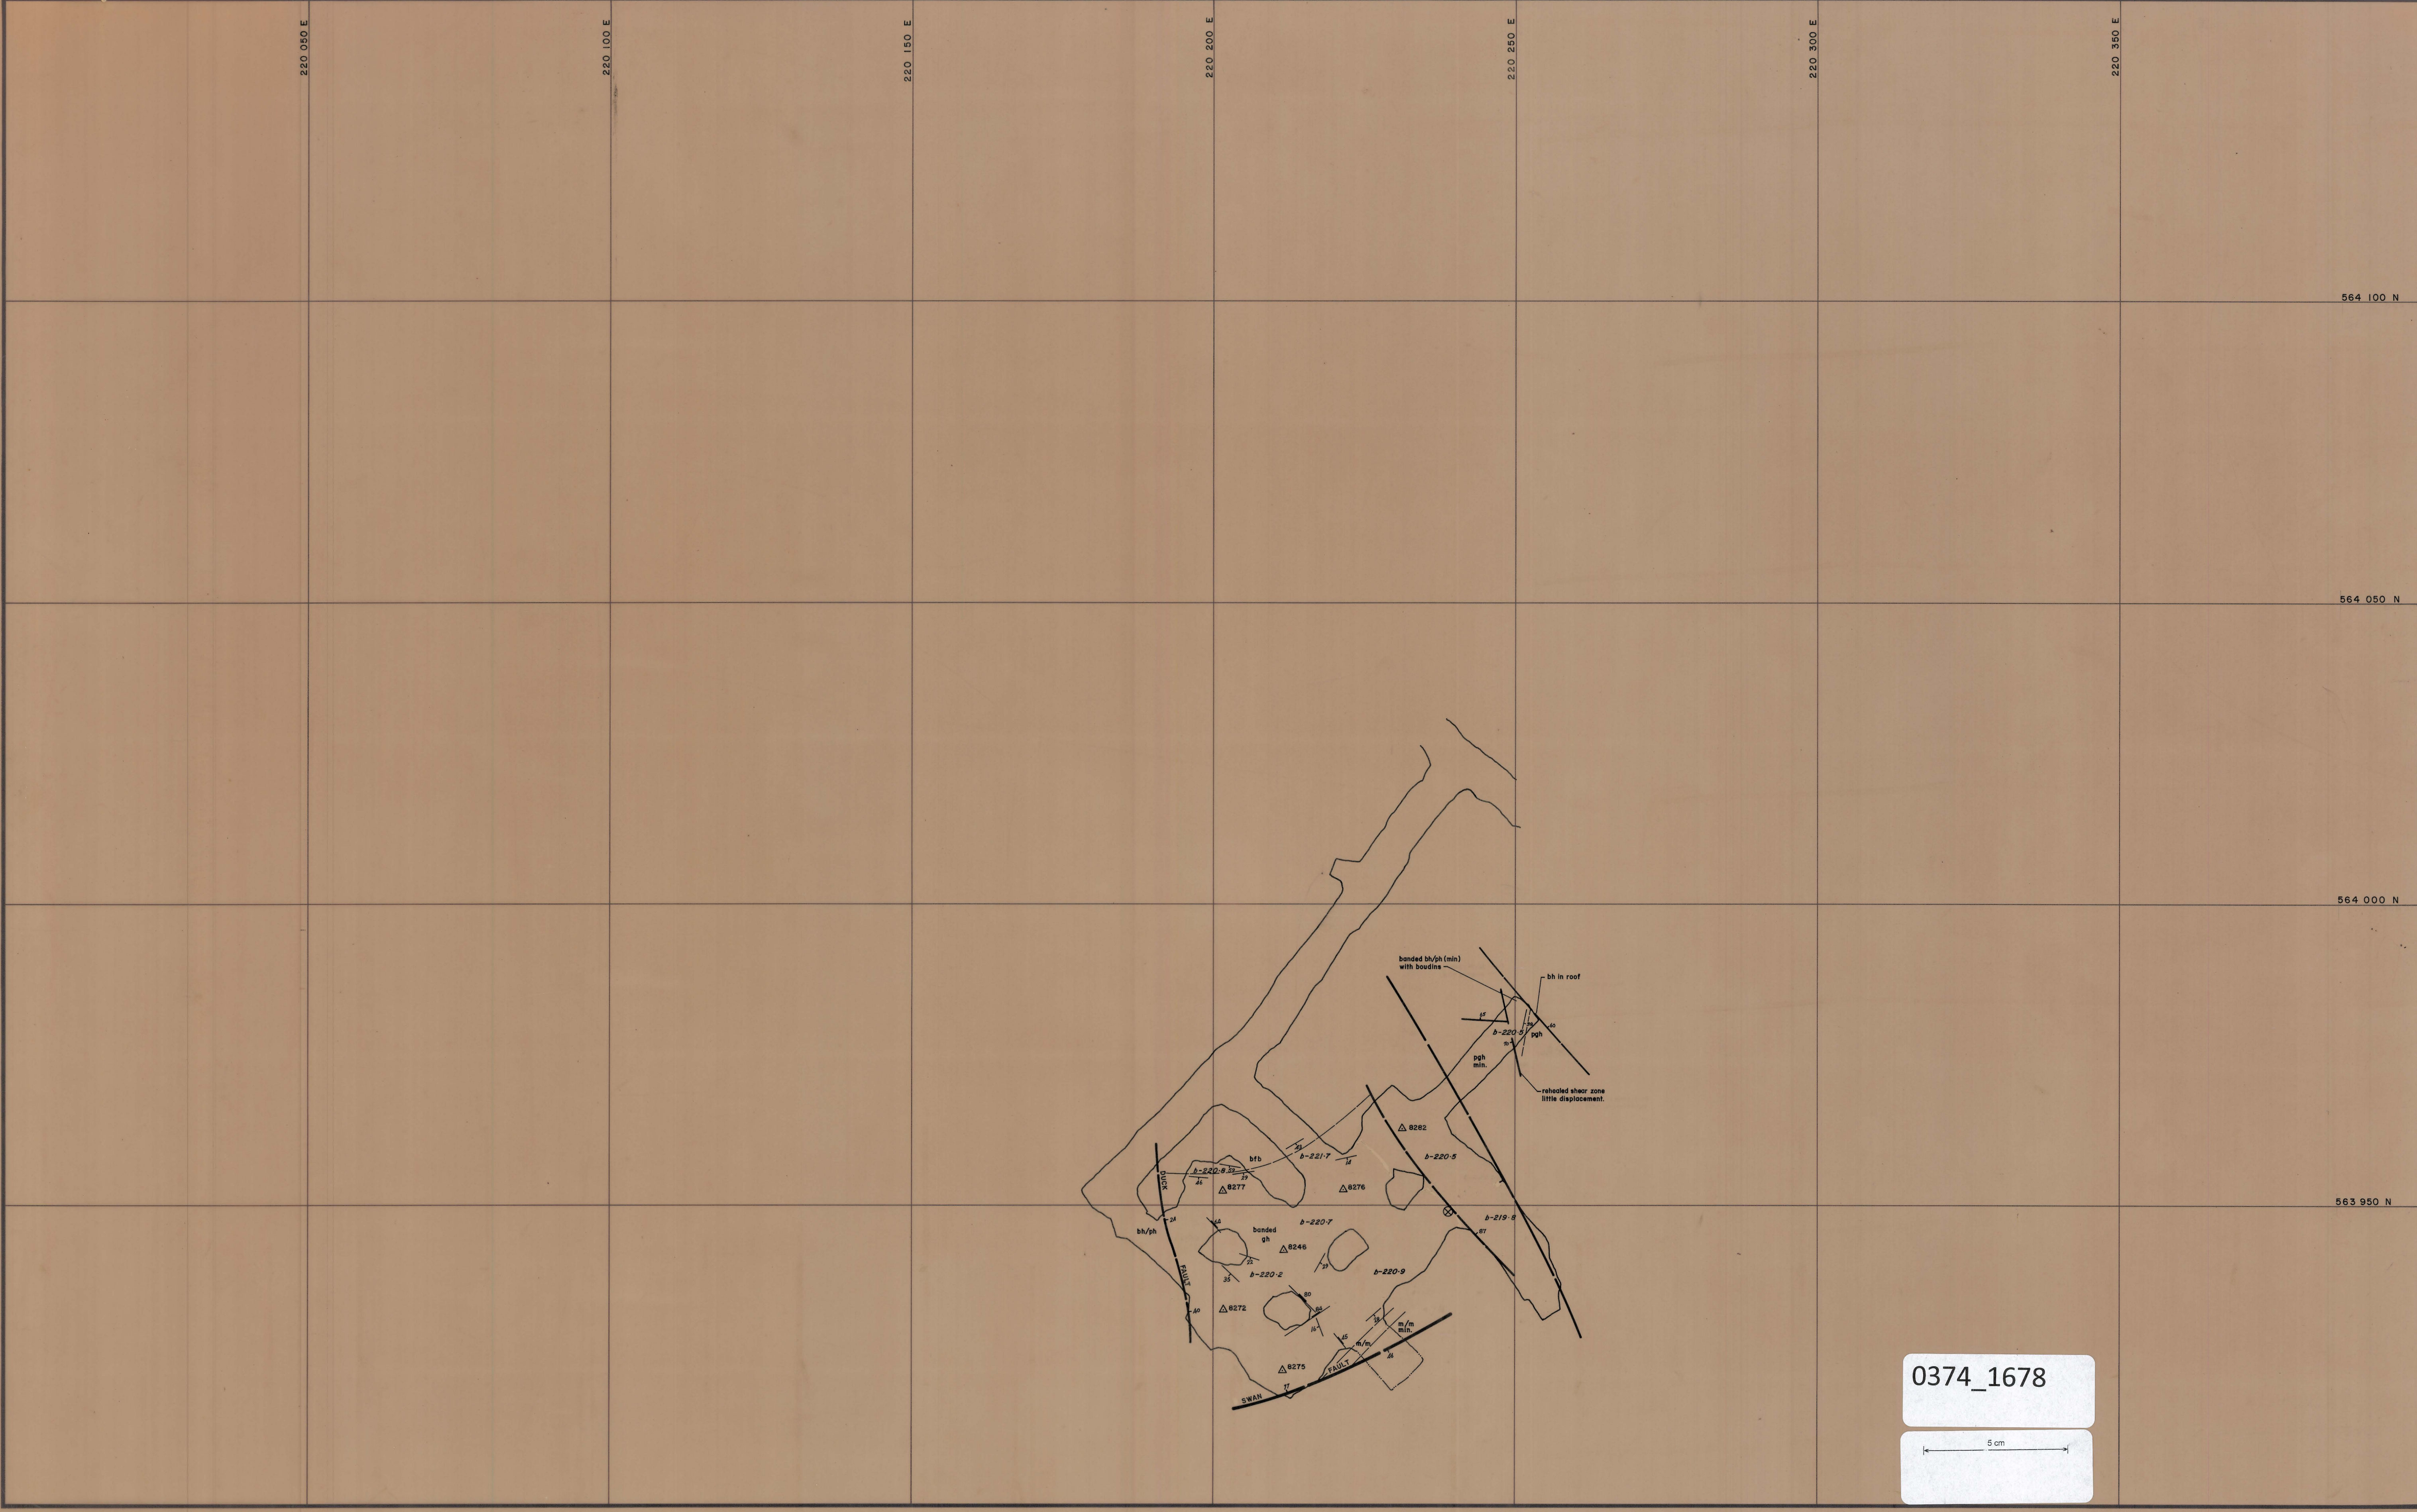

0374_1678

5 cm

LEGEND:

v	Upper metavolcanics	bh/ph	Banded footwall beds	strike and dip	geological boundary	
ch	Marble	bph	Biotite pyroxene hornfels	strike and dip vertical	minor fault	
bh	Biotite hornfels	lv	Lower metavolcanics	joint	major fault	
pgh	Pyroxene garnet hornfels	q	Quartzite	joint vertical	b	back
gh	Garnet hornfels	ap	Aplite	unconformity	f	floor
		gr	Granite	relative movement	r	road
				rise extending through level	s	spad
				head of rise		
				foot of rise		
				survey station		

DATE:

DRAWN:

GEOLOGY:

CHECKED:

KING ISLAND SCHEELITE

SCALE 1:500

DWG. No. KG04DM15-1058

1st LIFT
LOWER PIT
-224mRL CONTOUR