



0374 - 168

04 BH15 - 109 - 96

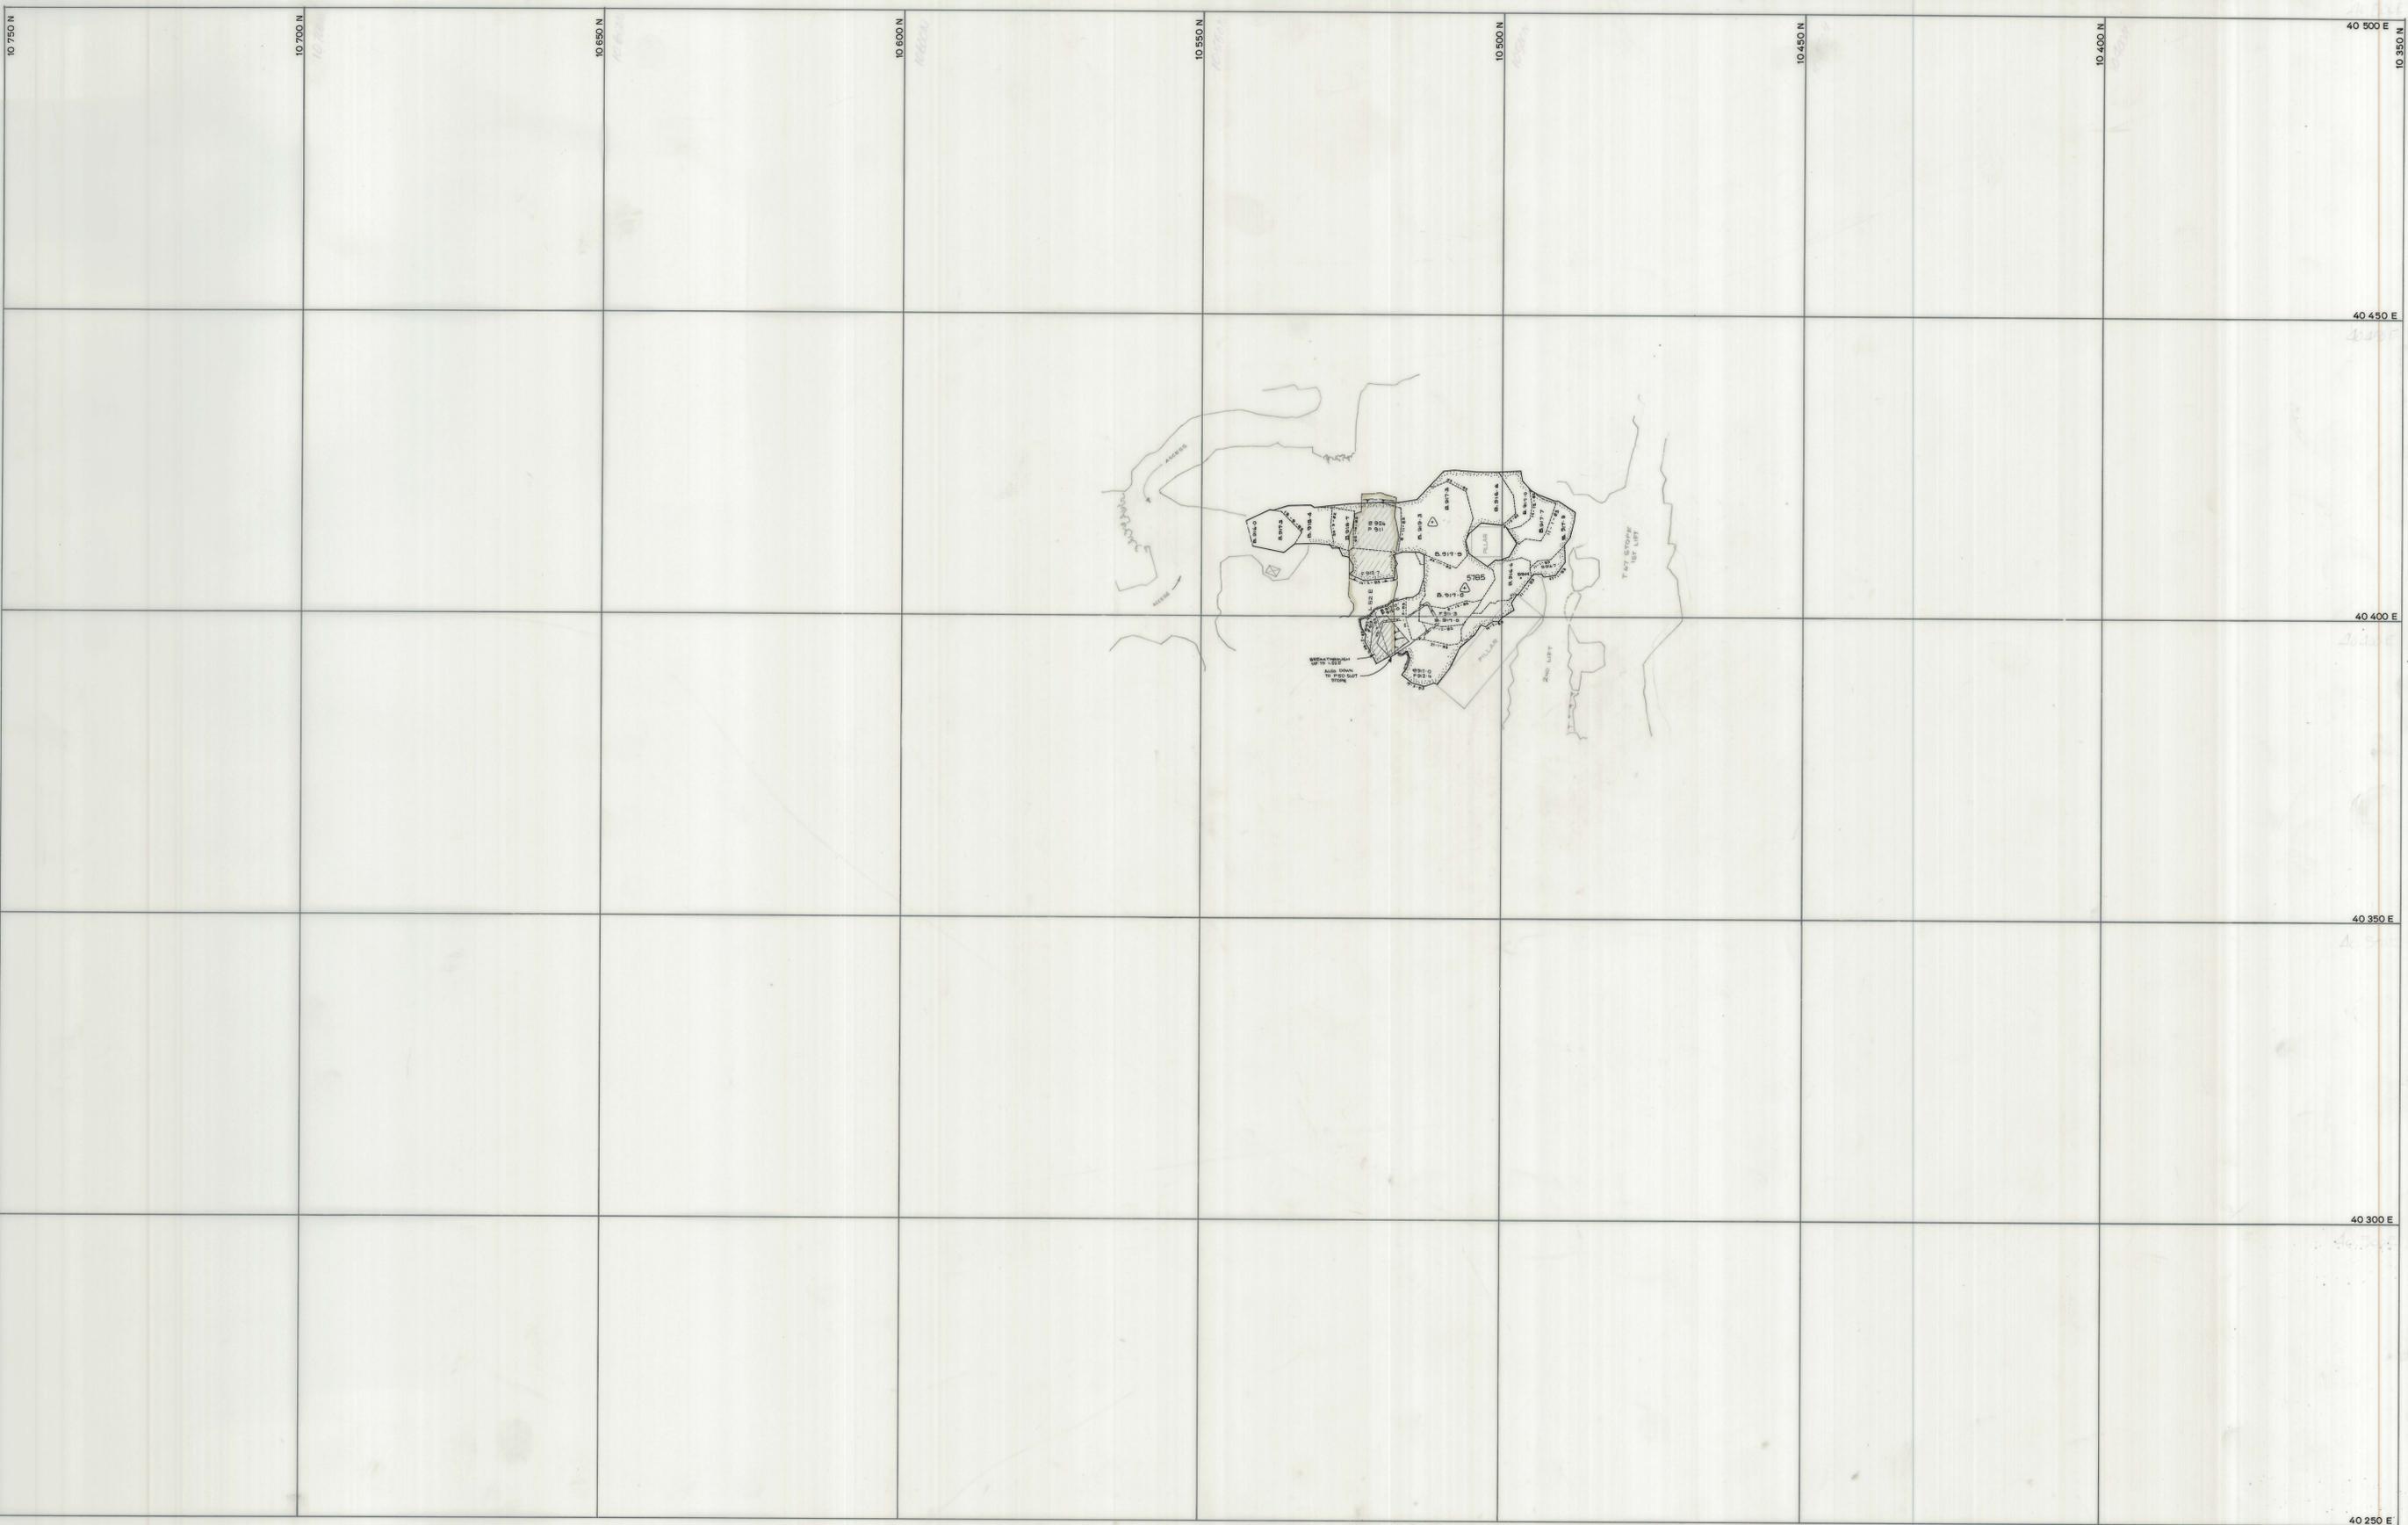

SCALE 1:500

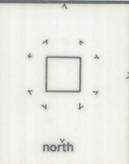

LOCATION  
BOLD HEAD MINE

SUBJECT  
Q52 Stope  
Lift

**KIS** KING ISLAND SCHEELITE  
A DIVISION OF WARMAN INTERNATIONAL

GRASSY KING ISLAND

04 BH15 - 109 - 96