


0374 1687

27 JUN 1981

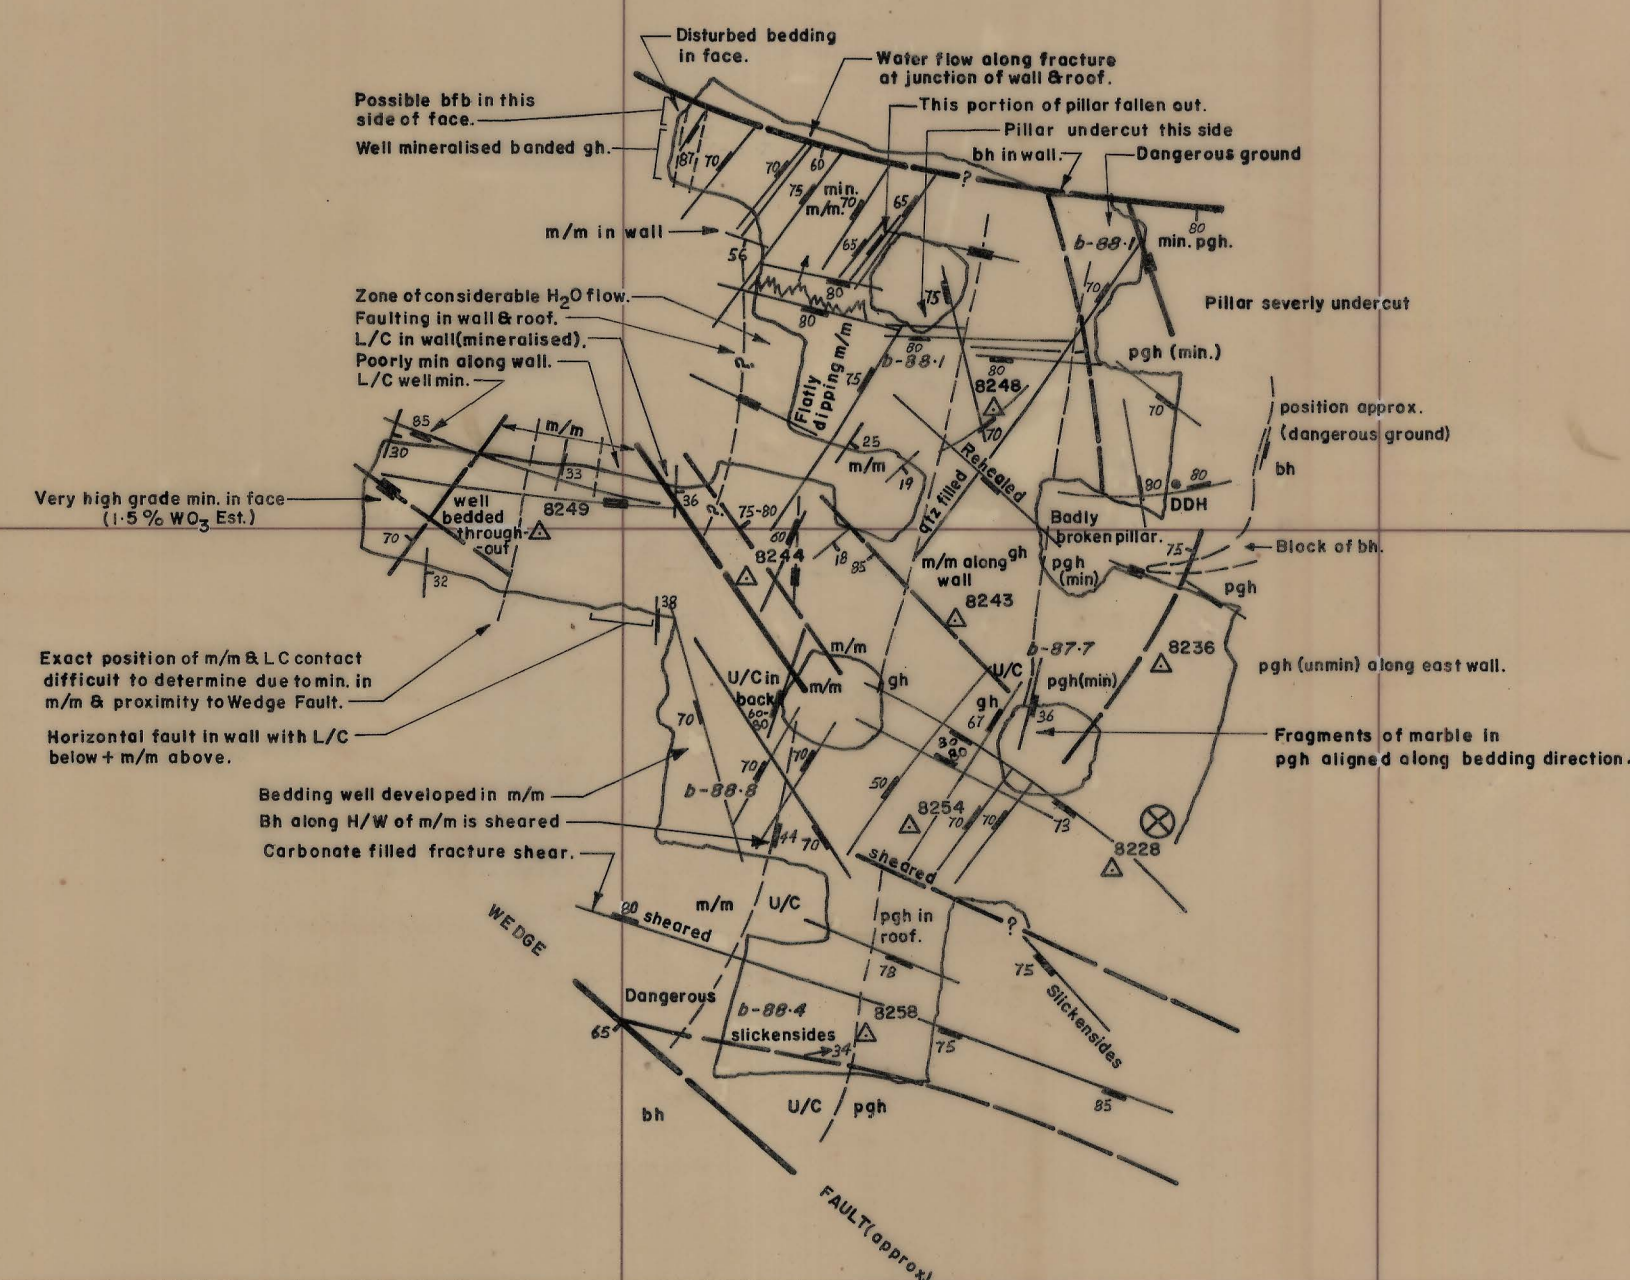

0374_1687

LEGEND :

v	Upper metavolcanics
bh/ph	Banded hornfels
ch	Marble
bh	Biotite hornfels
pgh	Pyroxene garnet hornfels
gh	Garnet hornfels

bh / ph ch / gh	Banded footwall beds
bph	Biotite pyroxene hornfels
lv	Lower metavolcanics
q	Quartzite
ap	Aplite
gr	Granite

-  strike and dip
-  strike and dip vertical
-  joint
-  joint vertical
-  unconformity
-  relative movement
-  rise extending through level
-  head of rise
-  foot of rise
-  survey station

----- geological boundary
 ———— minor fault
 ===== major fault

b	back
f	floor
r	road
s	spad



DATE: _____
DRAWN: **M.ydS.**
GEOLOGY: _____
CHECKED: _____

БЕЛОРУССКА

KING ISLAND BASE
A DIVISION OF PEKO-WALLSEND OPERATIONS LTD.

DWG. No. KGO4 DMII5-10II

DOLPHIN MINE
C WEDGE STOPE-92m. CONTOUR