

10 700 N

10 650 N

10 600 N

10 550 N

10 500 N

10 450 N


10 400 N

40 450 E

40 400 E

40 350 E

40 300 E

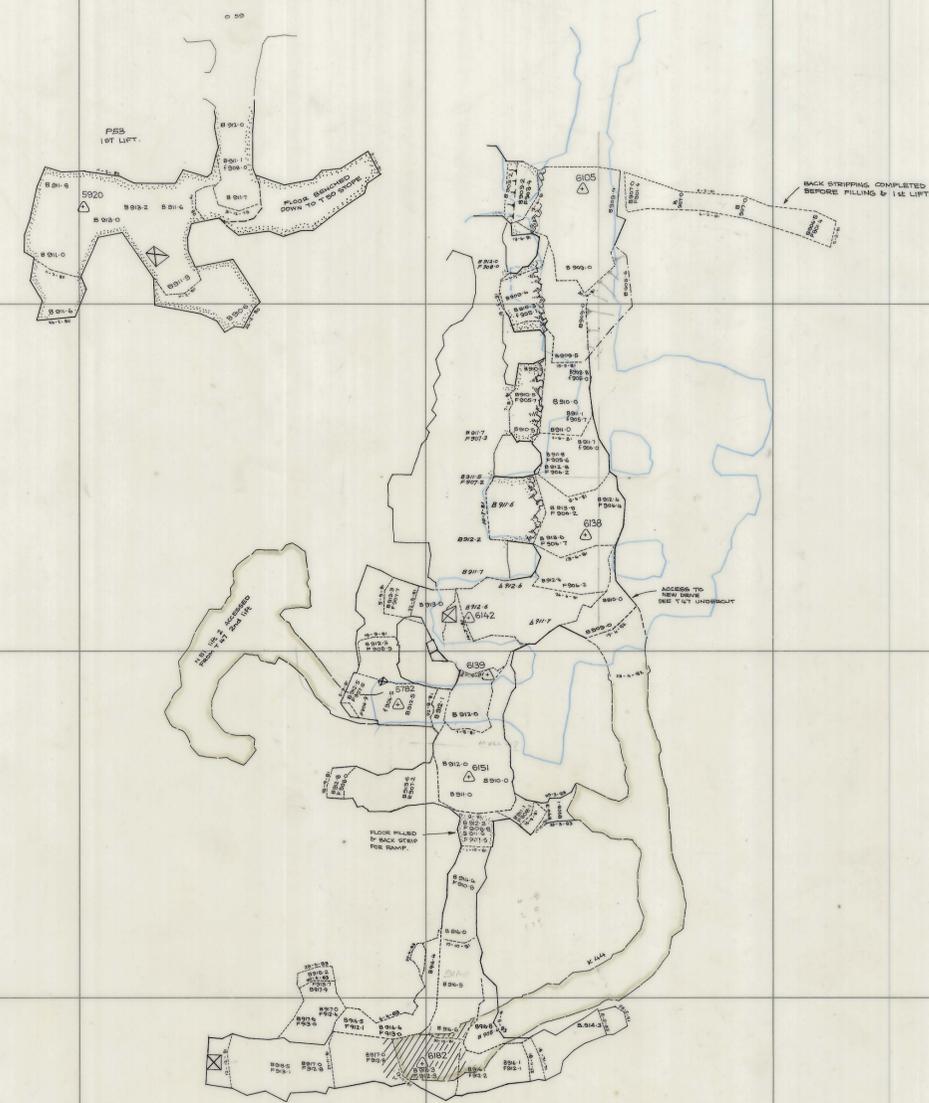

SCALE 1: 500



north

LOCATION BOLD HEAD MINE

SUBJECT P53 STOPE
C1 LENS - T47 STOPE
1st lift



PLAN NUMBER 04BH15 - 109 - 99