

04ADM15-1016

0374\_1693


220 100 E

220 200 E


220 300 E

564 200 N

564 100 N

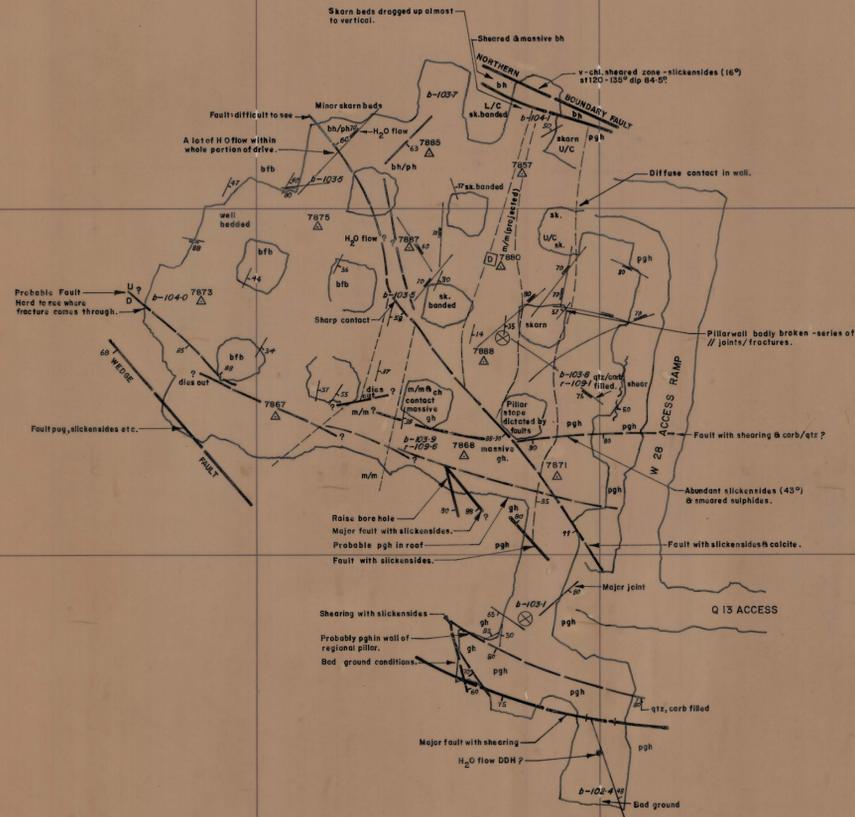

0374\_1693

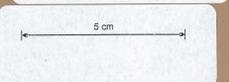

LEGEND:					
v	Upper metavolcanics	— strike and dip	— geological boundary	b	back
bh/ph	Banded footwall beds	+ strike and dip vertical	- - - minor fault	f	floor
bph	Biotite pyroxene hornfels	- joint	- - - major fault	r	road
lv	Lower metavolcanics	- joint vertical		s	spod
ch	Marble	~~~ unconformity			
bh	Biotite hornfels	~ relative movement			
pgh	Pyroxene garnet hornfels	⊠ rise extending through level			
gh	Garnet hornfels	⊠ head of rise			
ap	Aplite	⊠ foot of rise			
gr	Granite	⊠ survey station			

**GEOPEKO** KING ISLAND BASE  
A DIVISION OF PEKO-WALLSEND OPERATIONS LTD.

DATE: MAR 79  
DRAWN: M.v.d.S.  
GEOLOGY:  
CHECKED:

SCALE 1:500

DW.G. No. KG04DM15-1016

DOLPHIN MINE  
C LENS WEDGE -107m. R.L.

27 JUN 1981