


04 DM 15-1017A

0374_1695

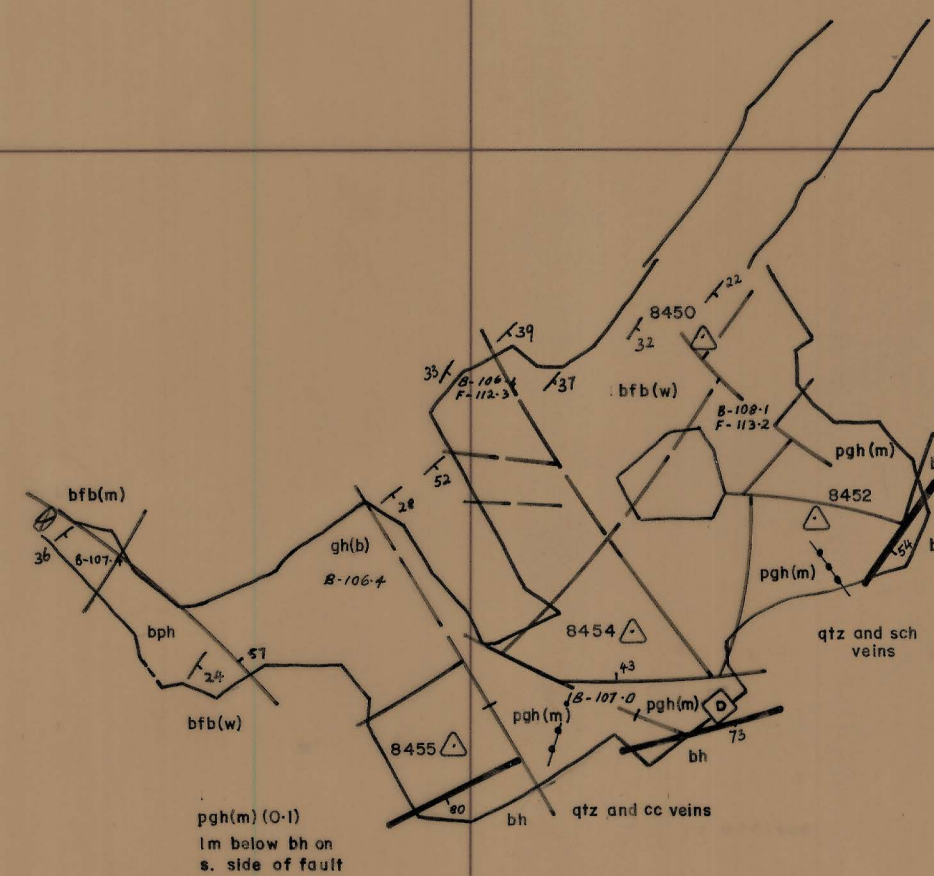

0374_1695

5 cm

LEGEND:

- v Upper metavolcanics
- bh/ph Banded hornfels
- ch Marble
- bh Biotite hornfels
- pgh Pyroxene garnet hornfels
- gh Garnet hornfels

- bh/ph Banded footwall beds
- bph Biotite pyroxene hornfels
- lv Lower metavolcanics
- q Quartzite
- ap Aplite
- gr Granite

- strike and dip
- strike and dip vertical
- joint
- joint vertical
- unconformity
- relative movement
- rise extending through level
- head of rise
- foot of rise
- survey station

- geological boundary
- minor fault
- major fault

- b back
- f floor
- r road
- s spoil



DATE: JAN. 81

DRAWN: M.F.

GEOLOGY: R.H.D.

CHECKED:

KING ISLAND SCHEELITE

10 0 10 20 30 40

SCALE 1:500

DWG. No. KG04 DM15-1017A

DOLPHIN MINE

C LENS WEDGE-110m.R.L.

27 JUN 1981