


04 DM15-1020

0374_1698

0374_1698

5 cm

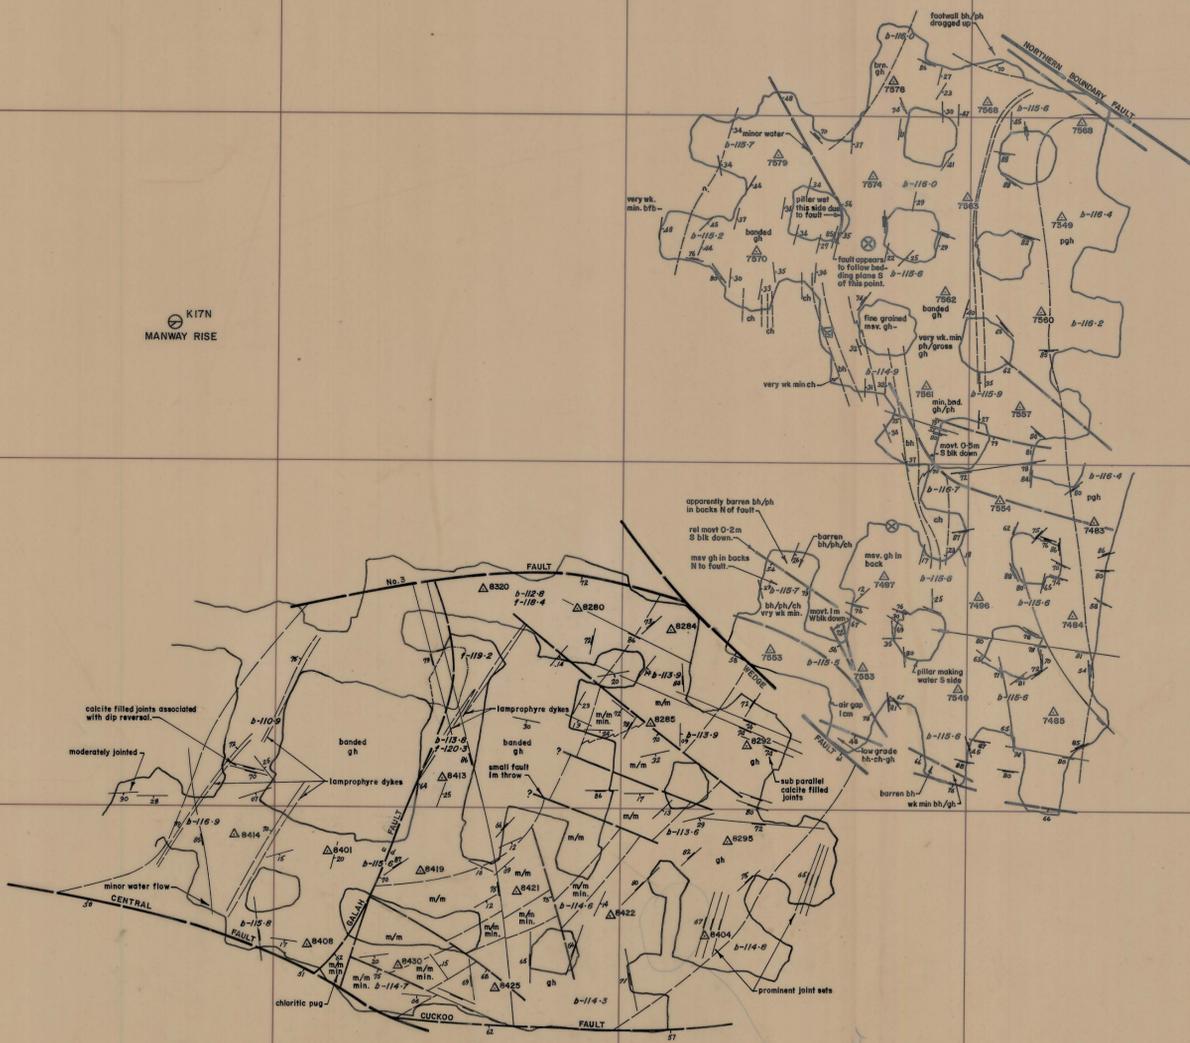

LEGEND:

- | | | | | | | | |
|-------|--------------------------|-------|---------------------------|---|------------------------------|-----|---------------------|
| v | Upper metavolcanics | bh/bh | Banded footwall beds | — | strike and dip | --- | geological boundary |
| bh/bh | Banded hornfels | bph | Biotite pyroxene hornfels | — | strike and dip vertical | --- | minor fault |
| ch | Marble | lv | Lower metavolcanics | — | joint | --- | major fault |
| bh | Biotite hornfels | q | Quartzite | — | joint vertical | b | back |
| pgh | Pyroxene garnet hornfels | ap | Aplite | — | unconformity | f | floor |
| gh | Garnet hornfels | gr | Granite | — | relative movement | r | road |
| | | | | — | rise extending through level | s | spad |
| | | | | — | head of rise | | |
| | | | | — | foot of rise | | |
| | | | | — | survey station | | |



GEOPEKO KING ISLAND BASE
A DIVISION OF PEKO-WALLESEND OPERATIONS LTD.

SCALE 1:500 DWG. No. KGo4DM15-1020

DATE:
DRAWN:
GEOLOGY:
CHECKED:

DOLPHIN MINE
WEDGE - C Lens, -119mR.L.

27 JUN 1981