



DM 15-1022

0374\_1701

27 JUN 1981

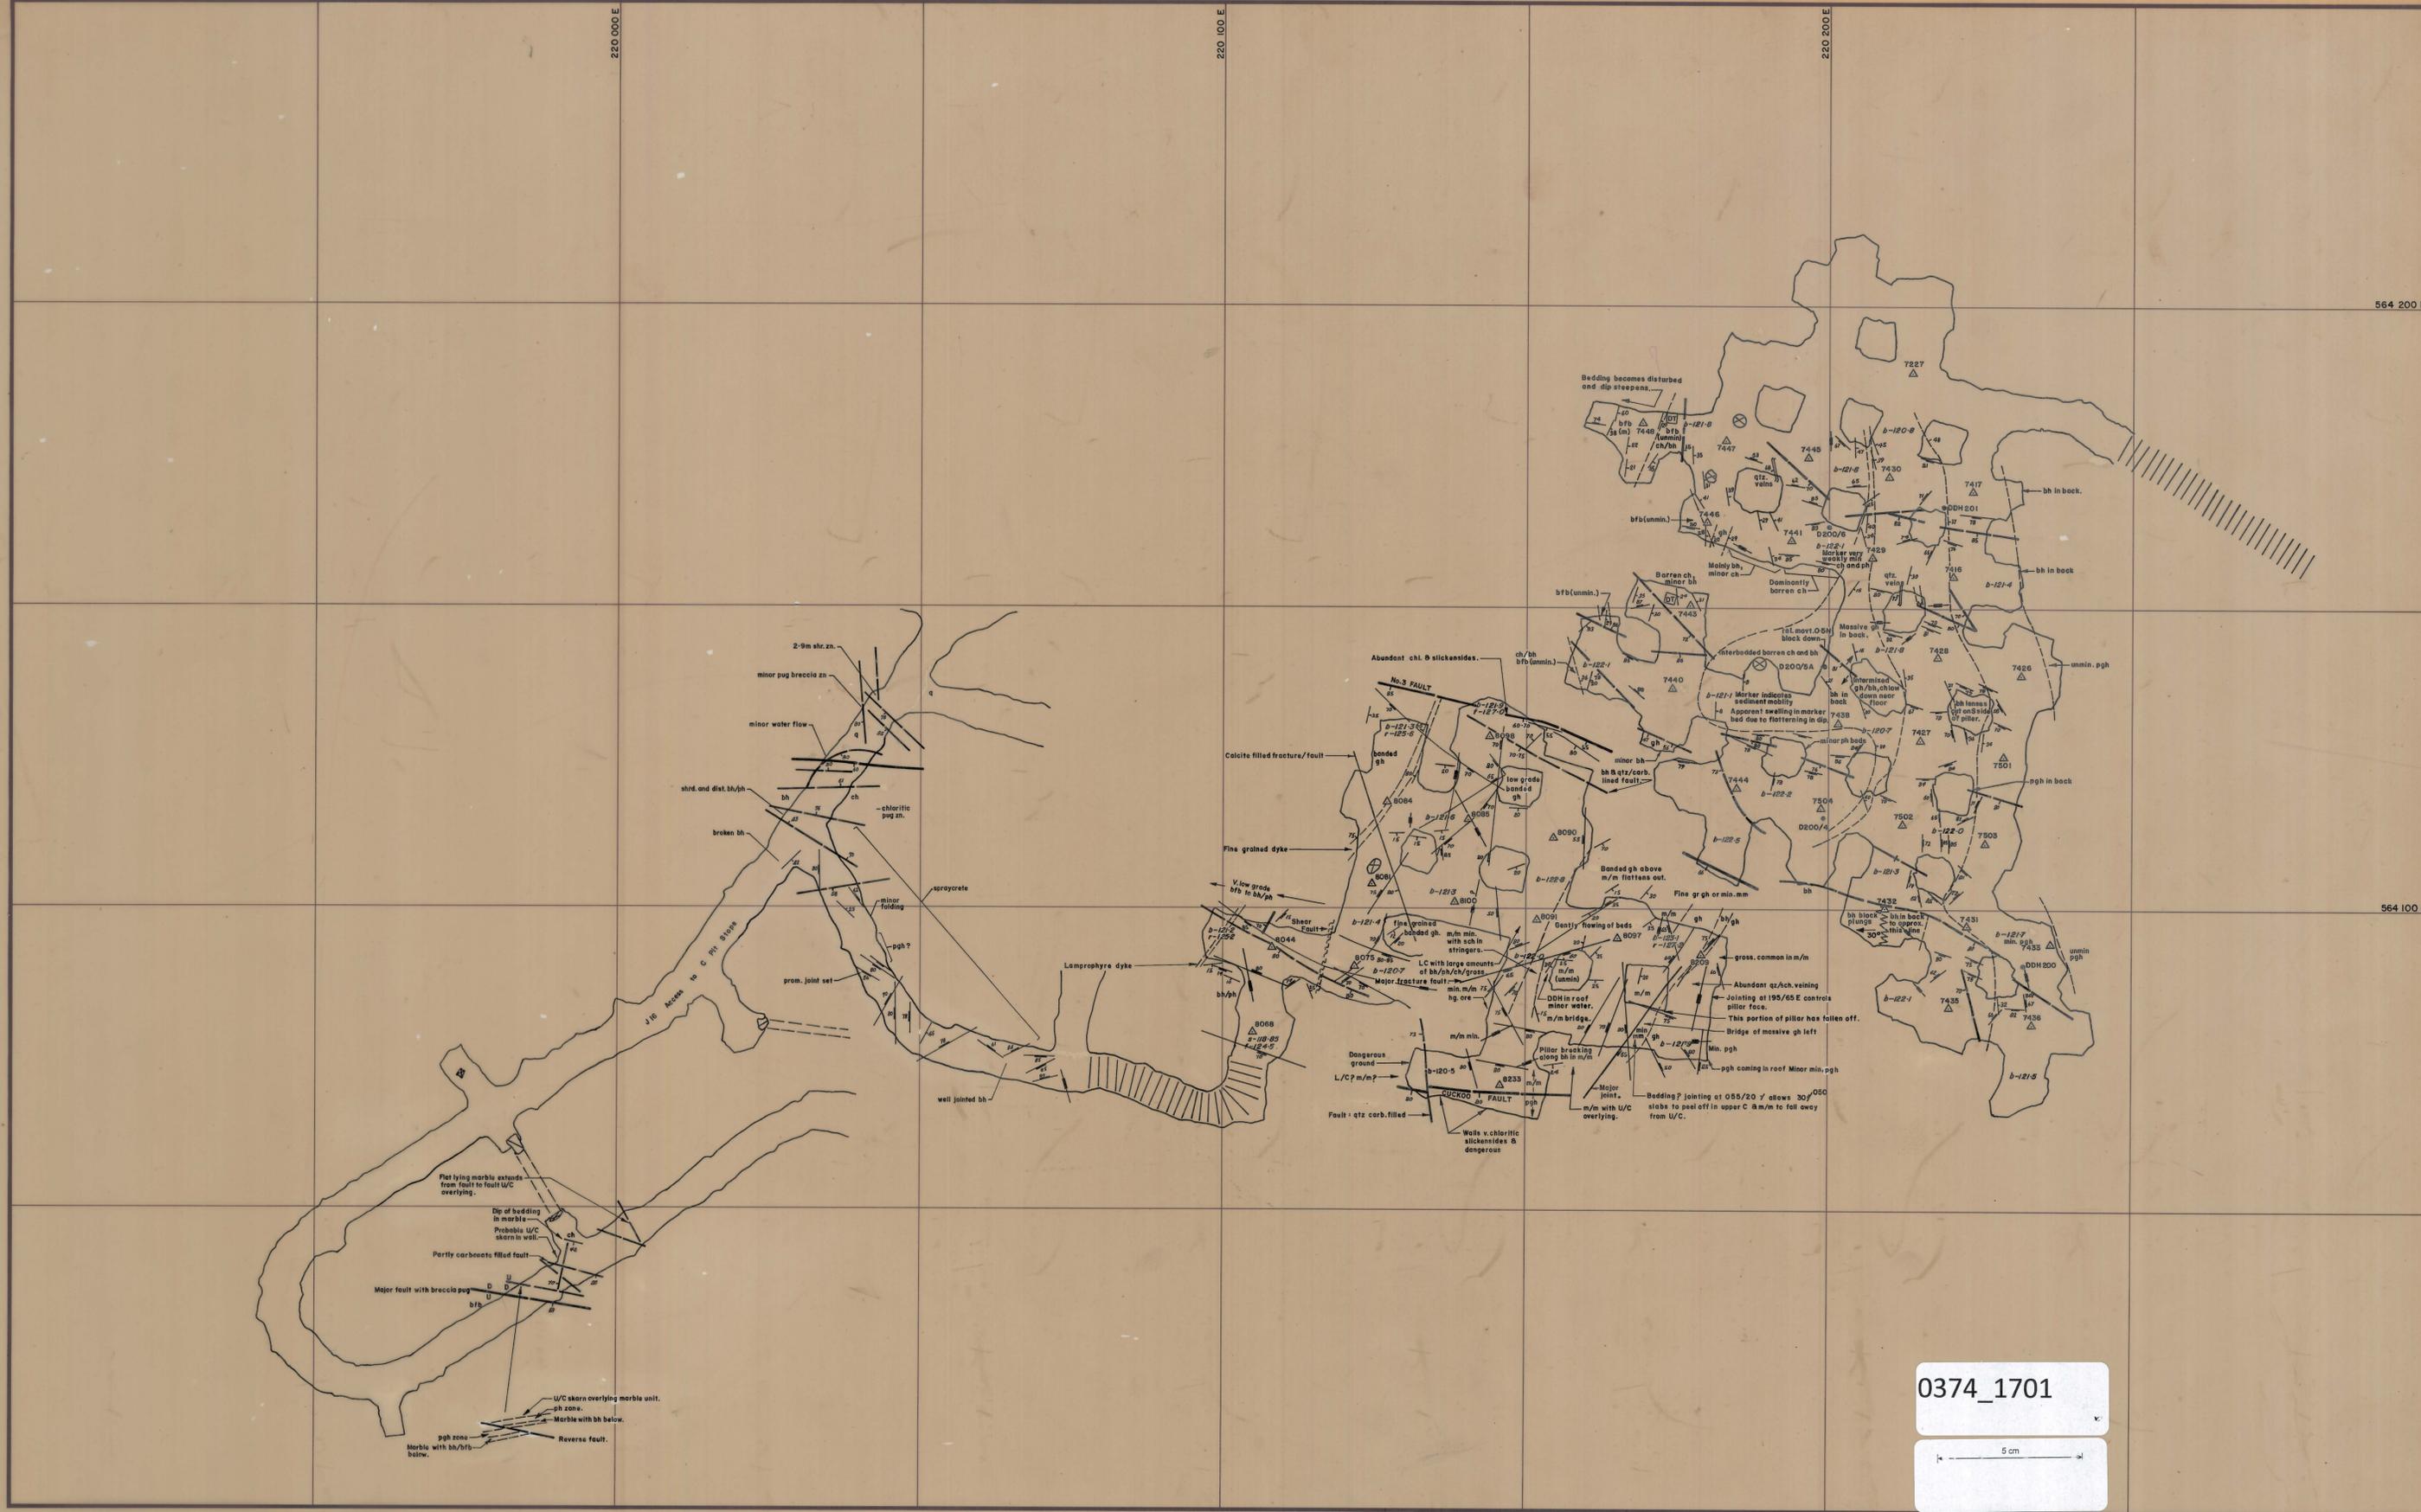

0374\_1701

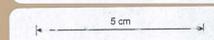

LEGEND:				
v	Upper metavolcanics	— strike and dip	— geological boundary	
bh/ph	Banded hornfels	+ strike and dip vertical	— minor fault	
ch	Marble	— joint	— major fault	
bh	Biotite hornfels	— joint vertical	b	back
pgh	Pyroxene garnet hornfels	— unconfornity	f	floor
gh	Garnet hornfels	— relative movement	r	road
bh/ph	Banded footwall beds	— rise extending through level	s	spad
bph	Biotite pyroxene hornfels	— head of rise		
lv	Lower metavolcanics	— foot of rise		
q	Quartzite	— survey station		
ap	Aplite			
gr	Granite			

DATE: APR. 79  
DRAWN: M.v.d.S.  
GEOLOGY: M.J.D.  
R.S.P. & G.J.B.  
CHECKED:

**KING ISLAND BASE**  
A DIVISION OF PEKO-WALLSEND OPERATIONS LTD.

**DOLPHIN MINE**  
C WEDGE CENTRAL & PIT STOPES -125m CONTOUR.

DWG. No. KG 04DM15-1022