


0374-171

04BH15-110-98



SCALE 1: 500

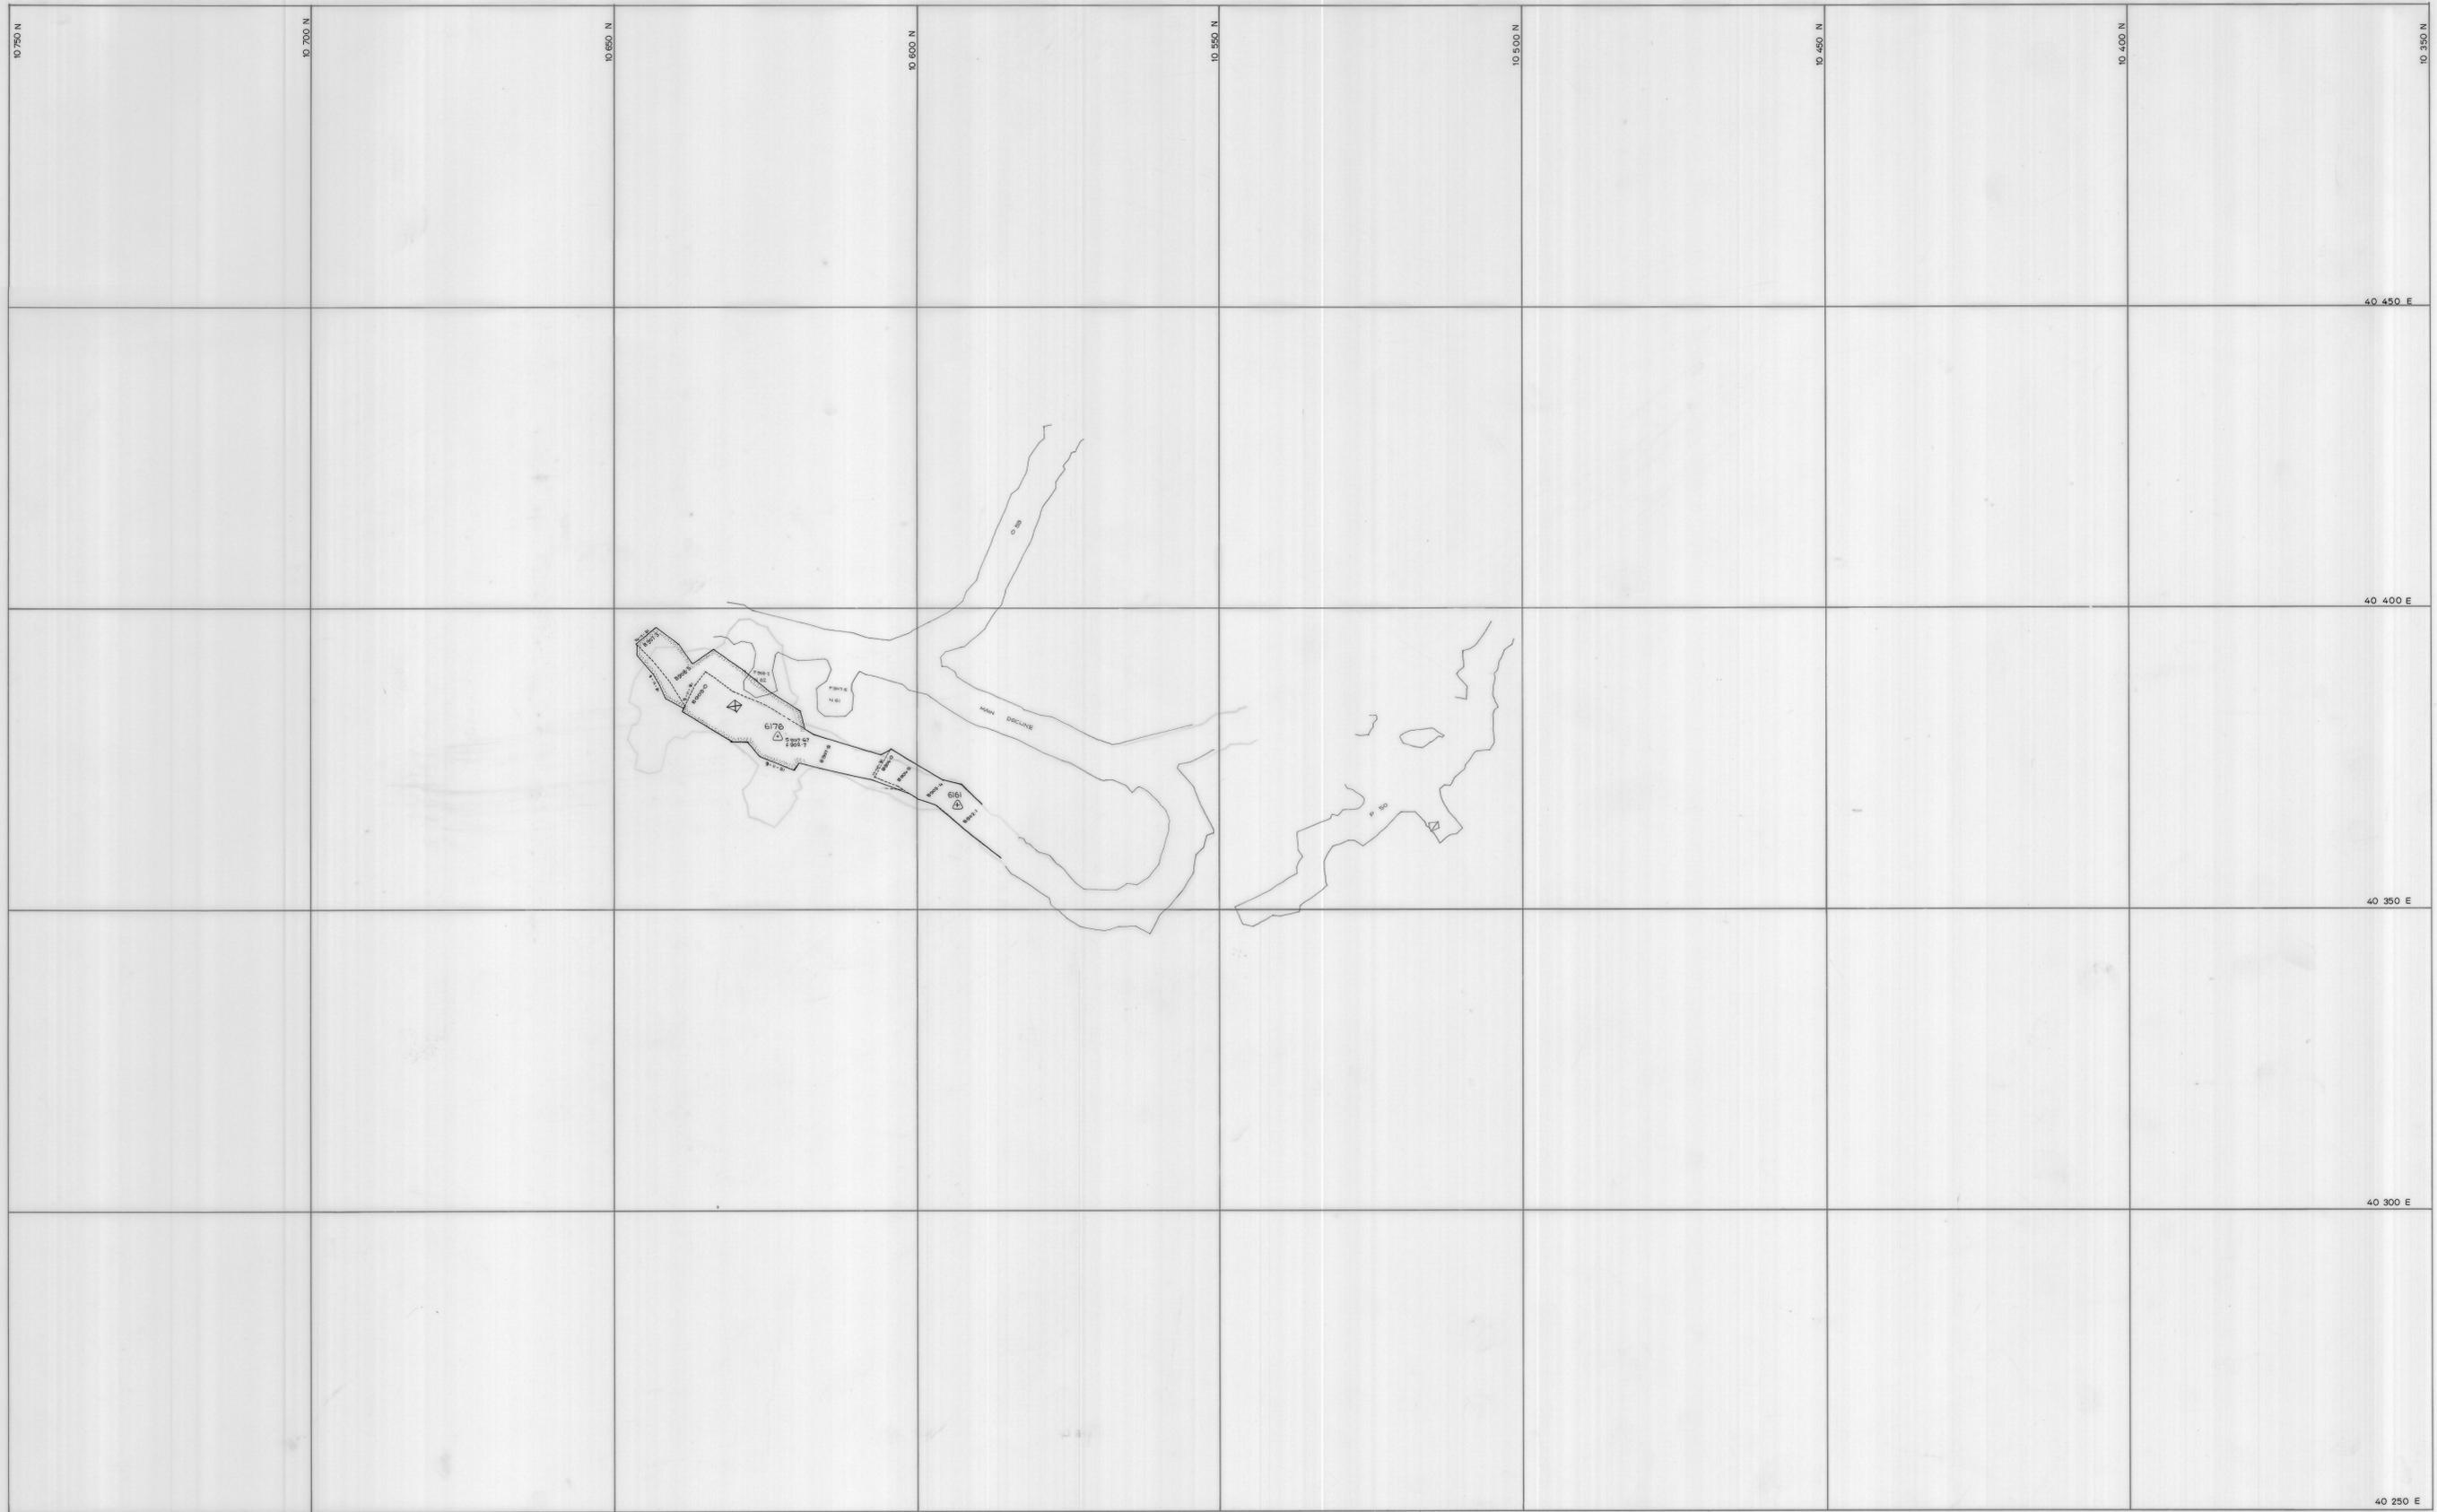

LOCATION  
BOLD HEAD MINE

SUBJECT  
D LENS  
K 57 2 lift

**KIS** KING ISLAND SCHEELITE  
A DIVISION OF WARMAN INTERNATIONAL

GRASSY KING ISLAND

PLAN NUMBER  
04BH15 - 110 - 98