


0374-1214

564050 N

564000 N

563950 N

563900 N

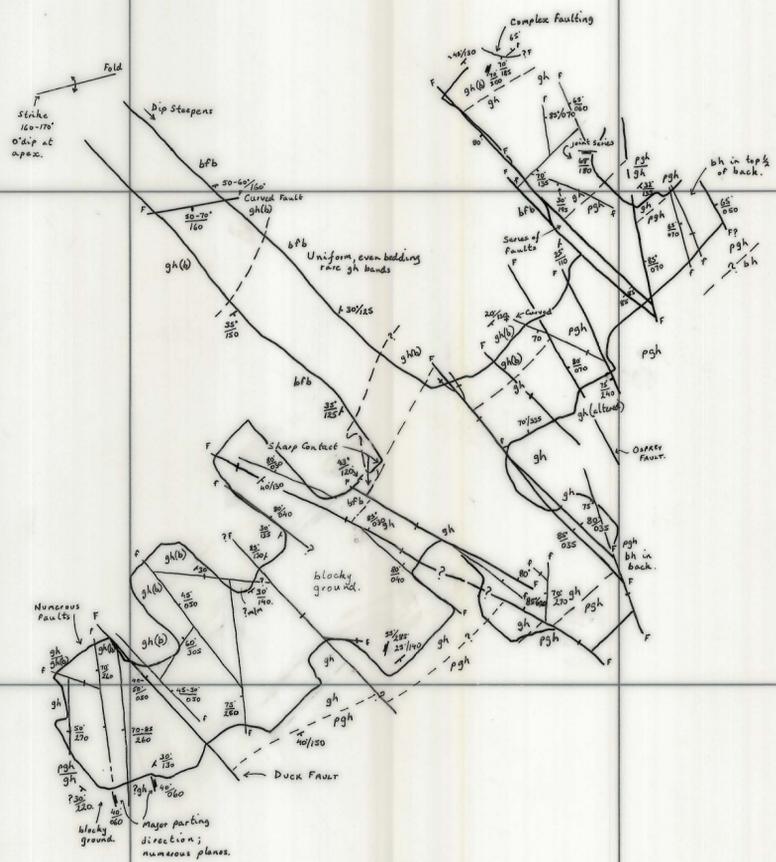

5 cm
0374-1214

1:500
SCALE
DOLPHIN MINE
LOWER PIT STOPE
LIFT 13
GEOLOGY AT 176m RL.