


0374 - 1216

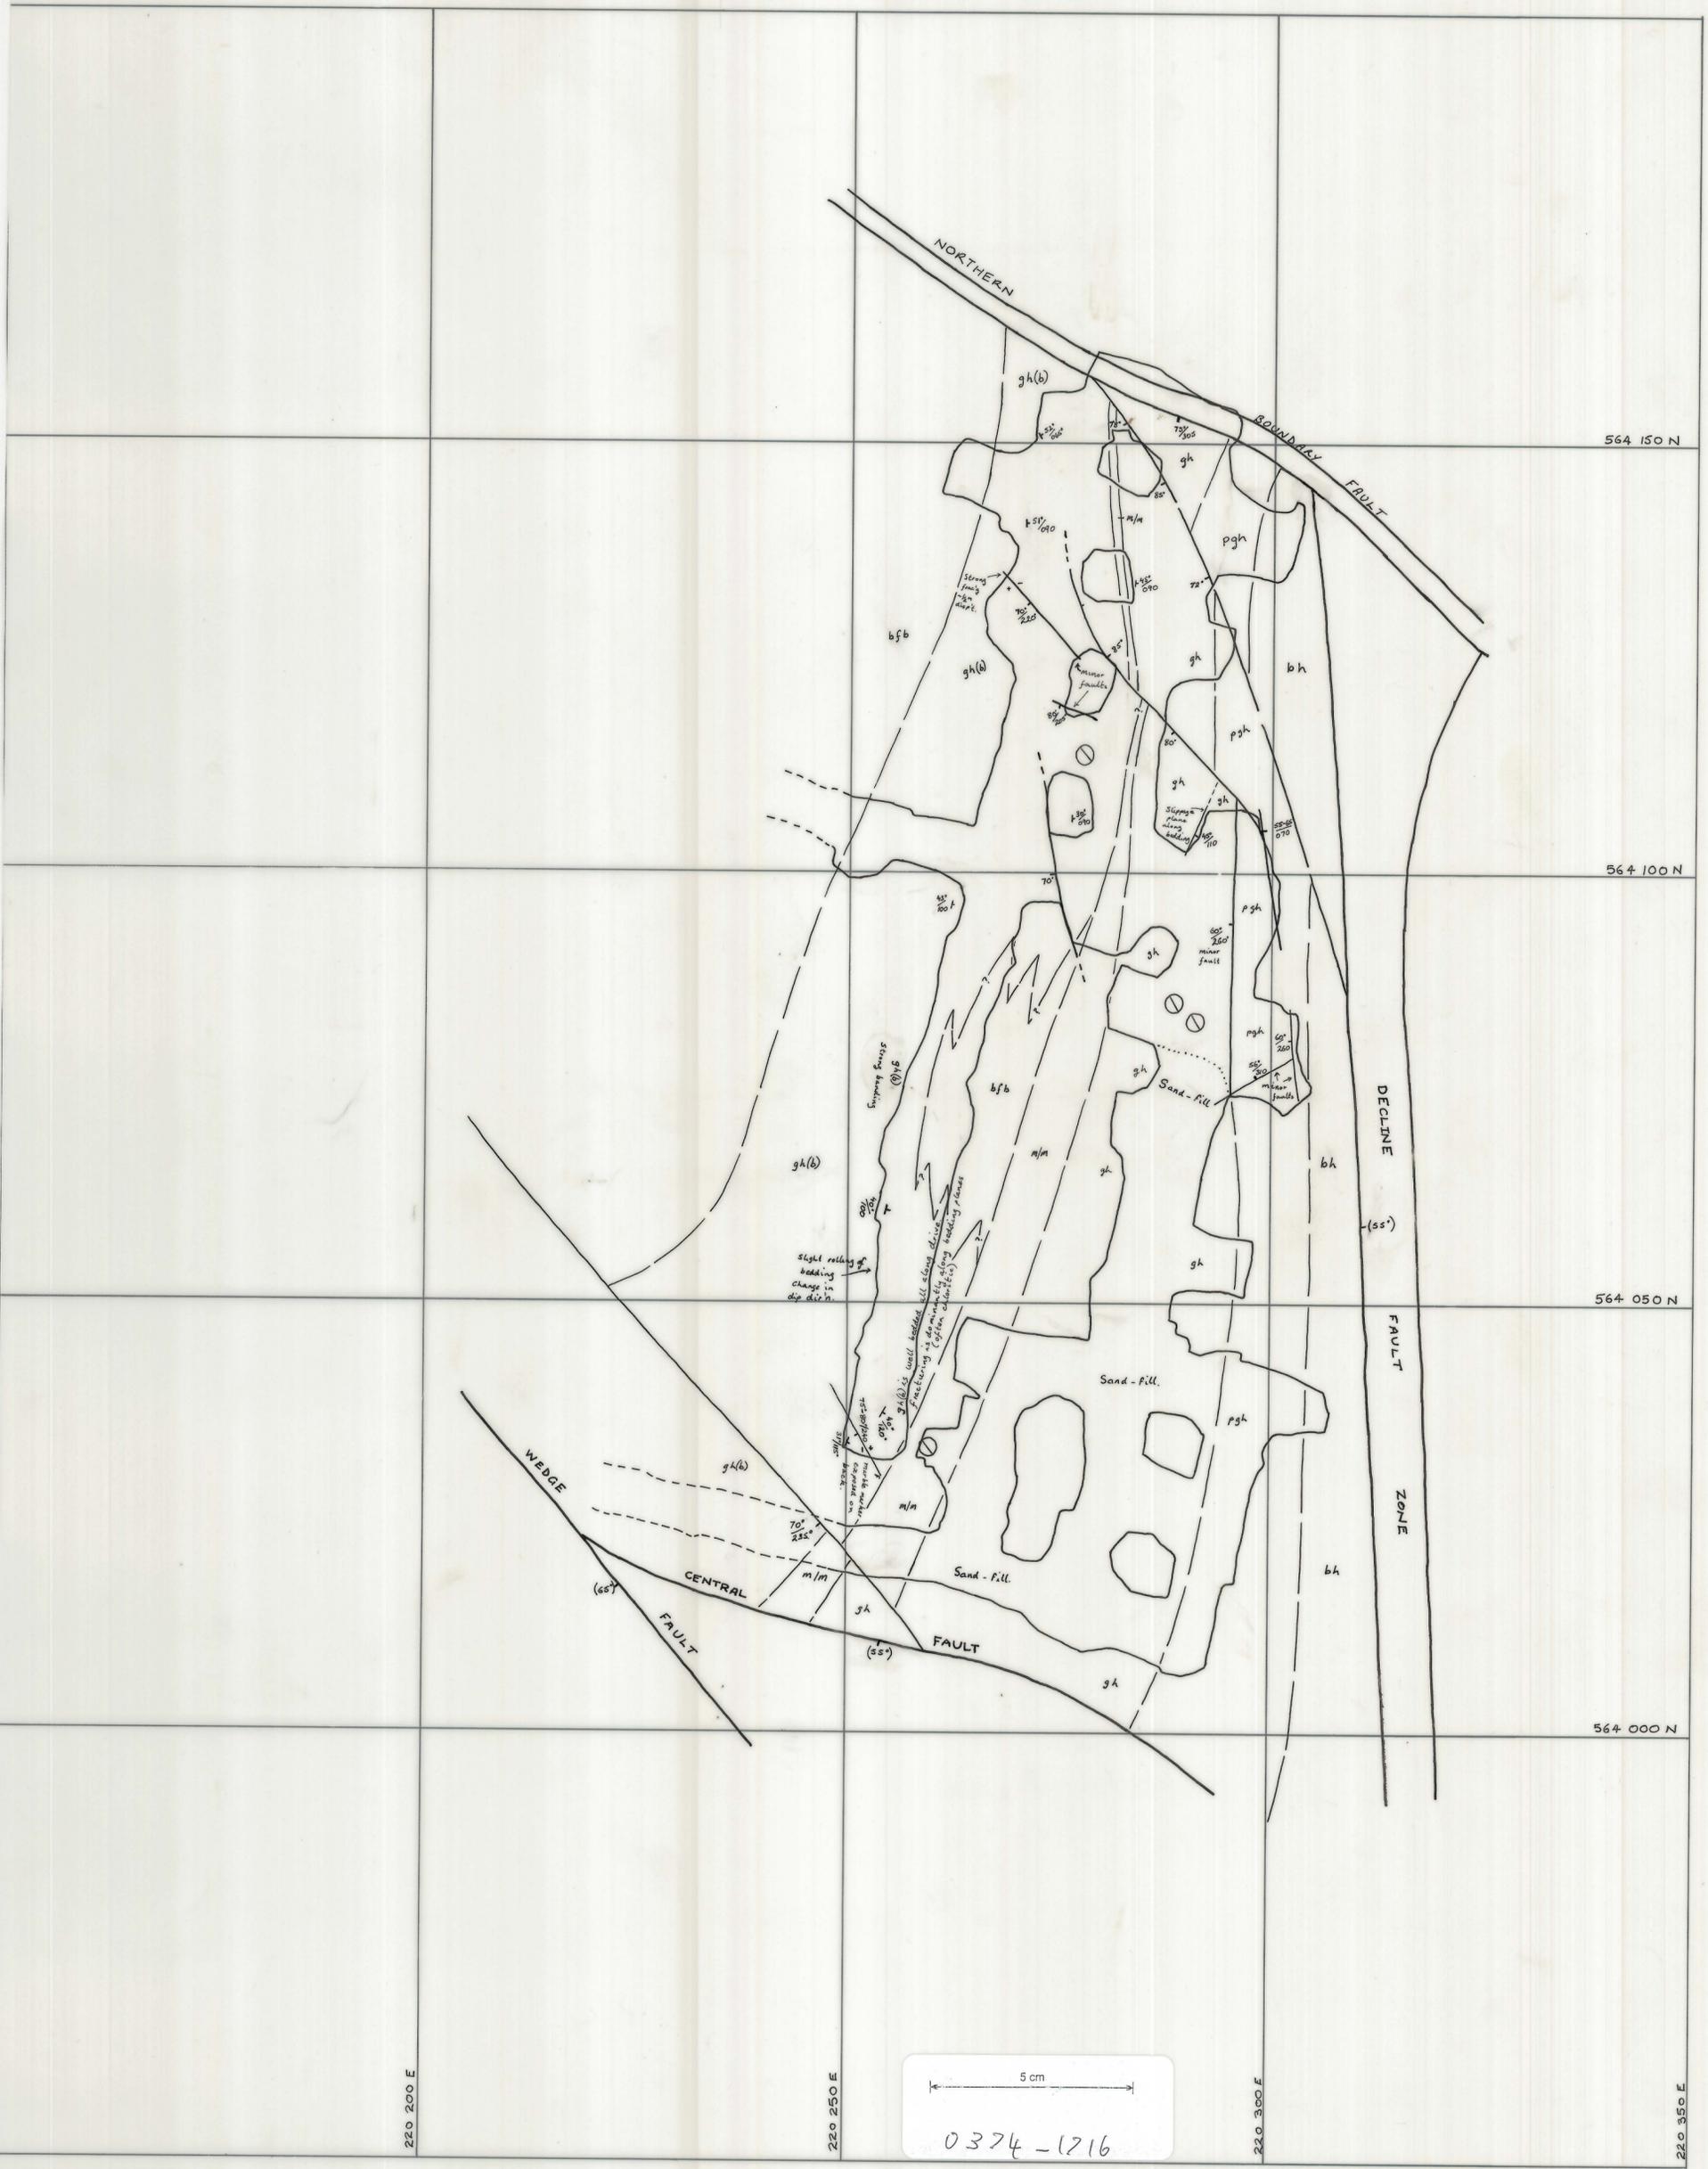

SCALE 1: 500		LOCATION DOLPHIN MINE	
		SUBJECT MID WEDGE STOPE Lift 7	GRASSY KING ISLAND <small>PLAN NUMBER</small>