


0374-1721

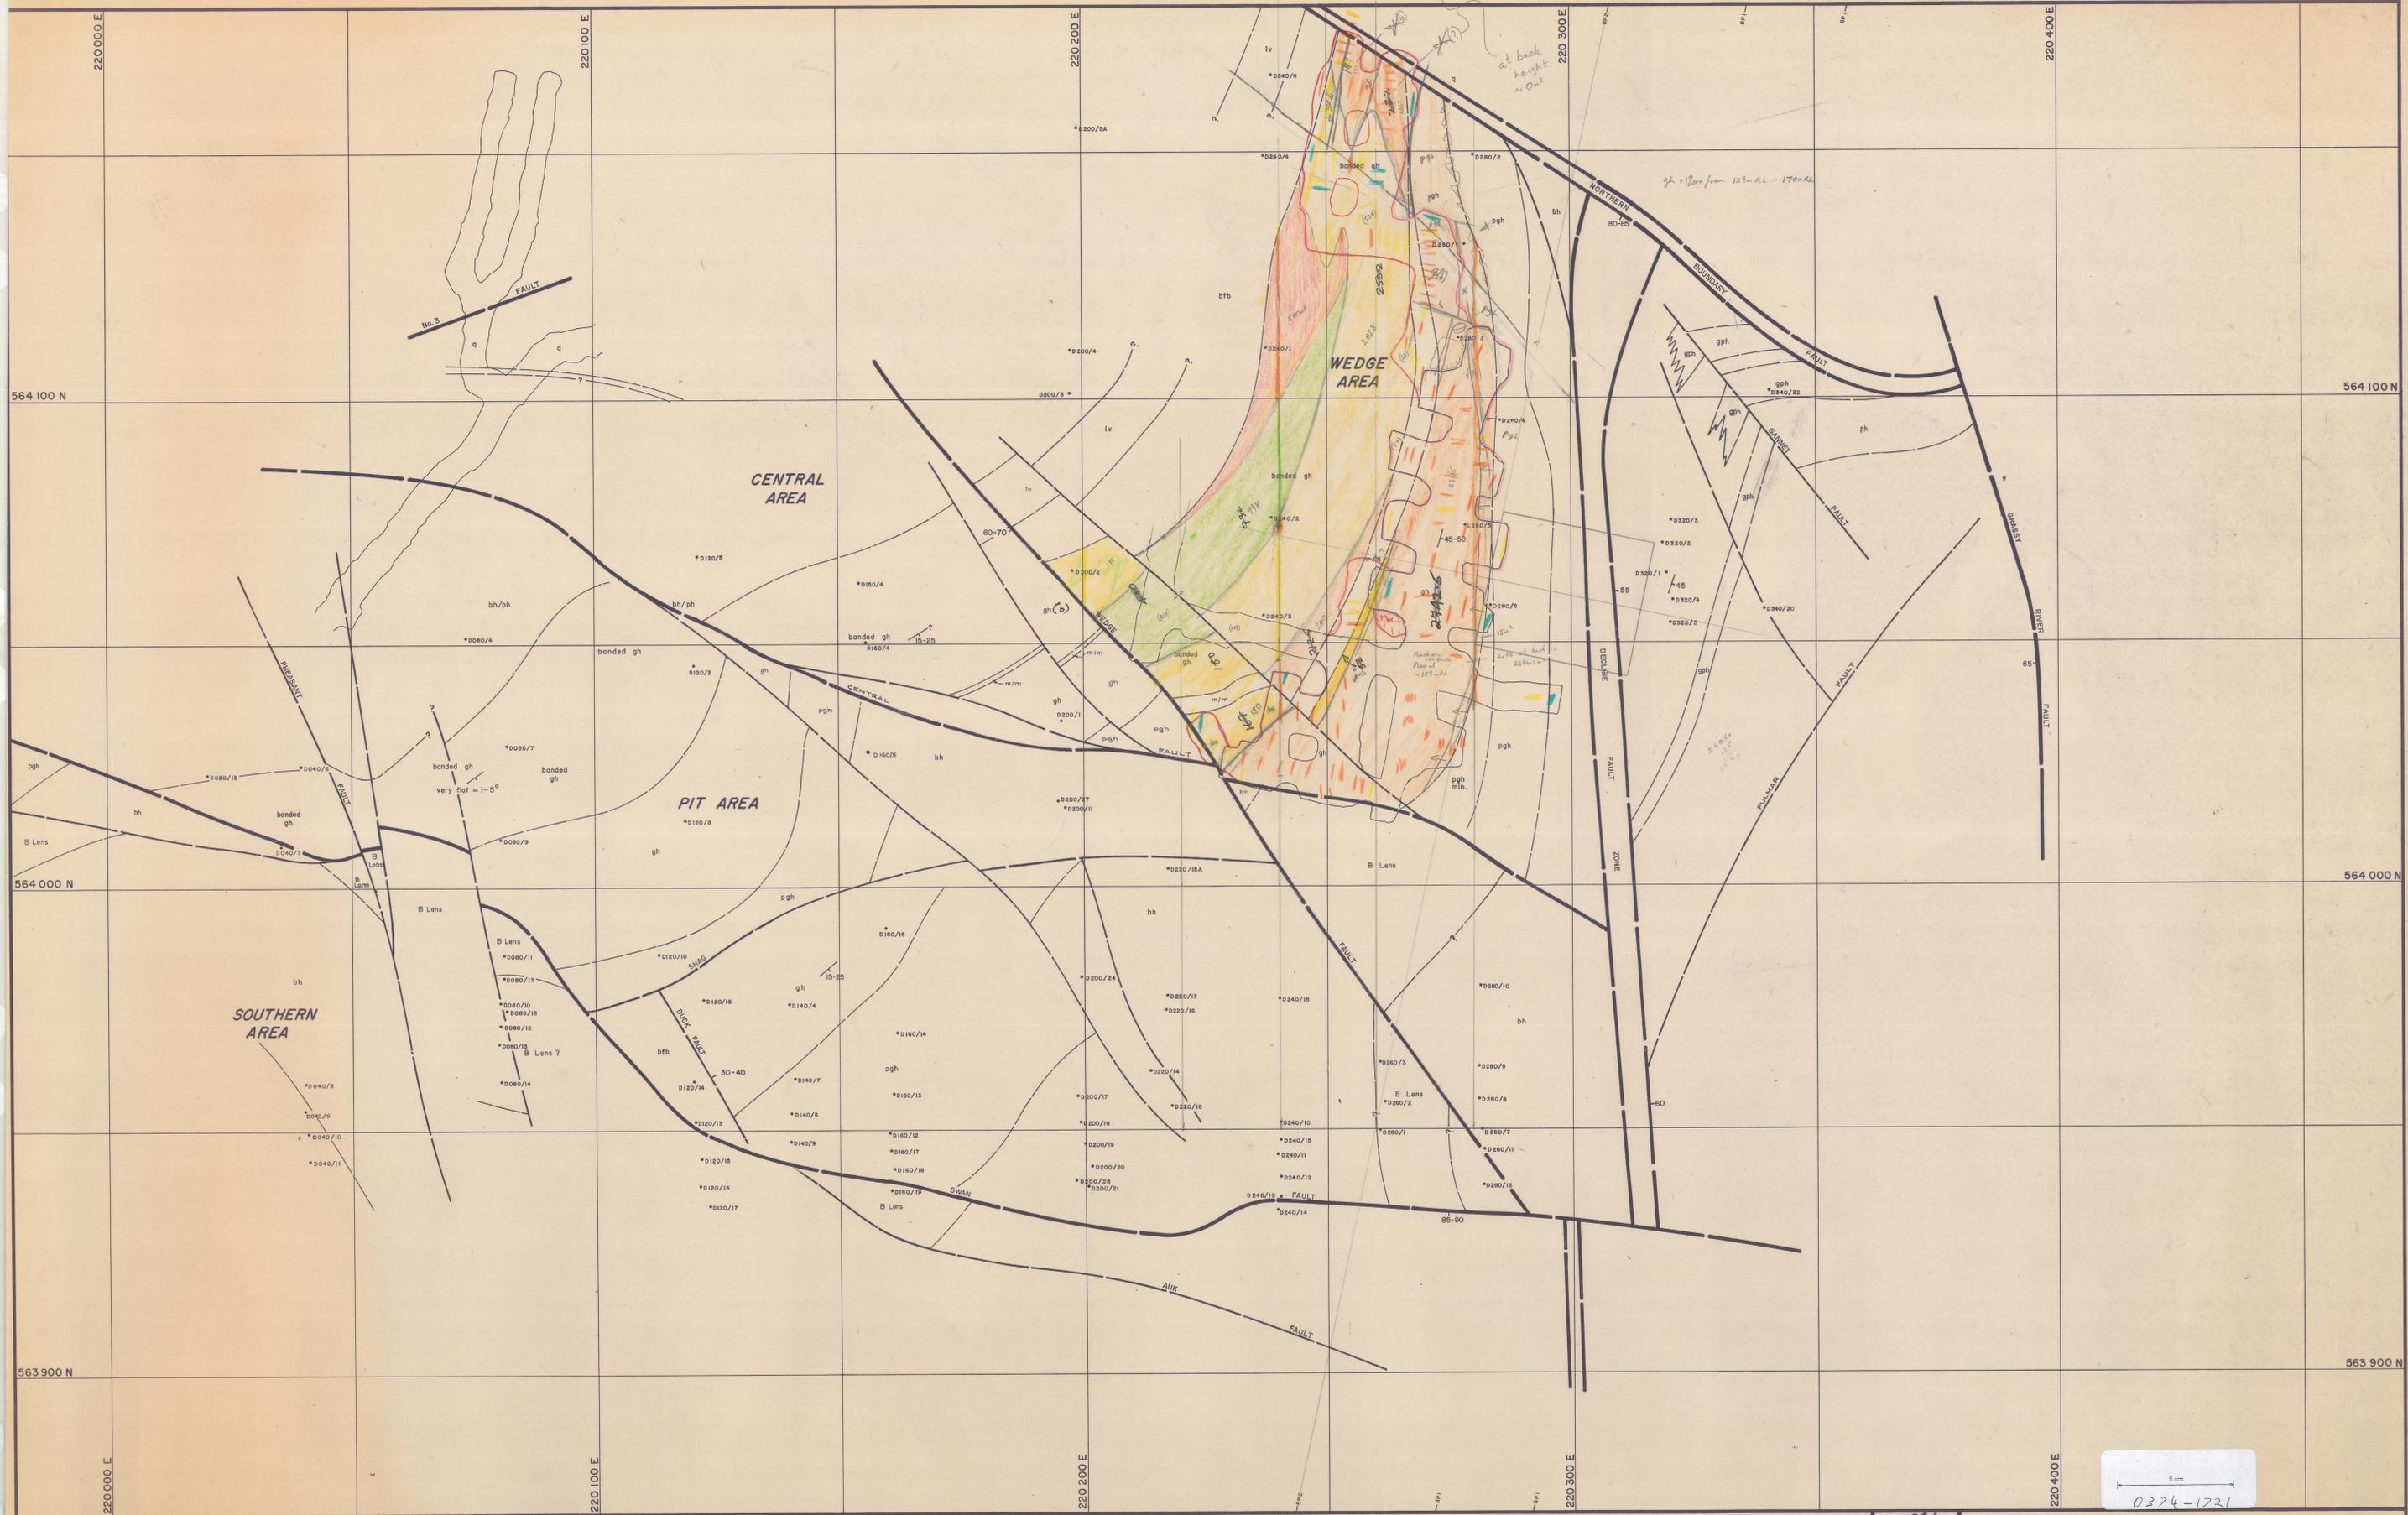

LEGEND:	
v	Upper metavolcanics
bh/ph	Banded hornfels
ch	Marble
bh	Biotite hornfels
pgh	Pyroxene garnet hornfels
gh	Garnet hornfels
bf	Banded footwall beds
bph	Biotite pyroxene hornfels
lv	Lower metavolcanics
q	Quartzite
ap	Aplite
ad	Adamellite
90	Strike and dip
87	Joint, inclined
—	Joint, vertical
—	Fault
R-127.3	Roadway R.L. -127.3m.

  
 DATE: 20th MAY 1967  
 GEOLOGIST: S.G.B.  
 DRAWN: [Signature]  
 CHECKED: [Signature]

KING ISLAND SCHEELITE  
 No. K62-06-160E  
 DOLPHIN MINE  
 GEOLOGICAL LEVEL PLAN  
 - 160m R.L.

