


0374 - 175

04BH15 - 111 - 98

M37 etape  
lift 2

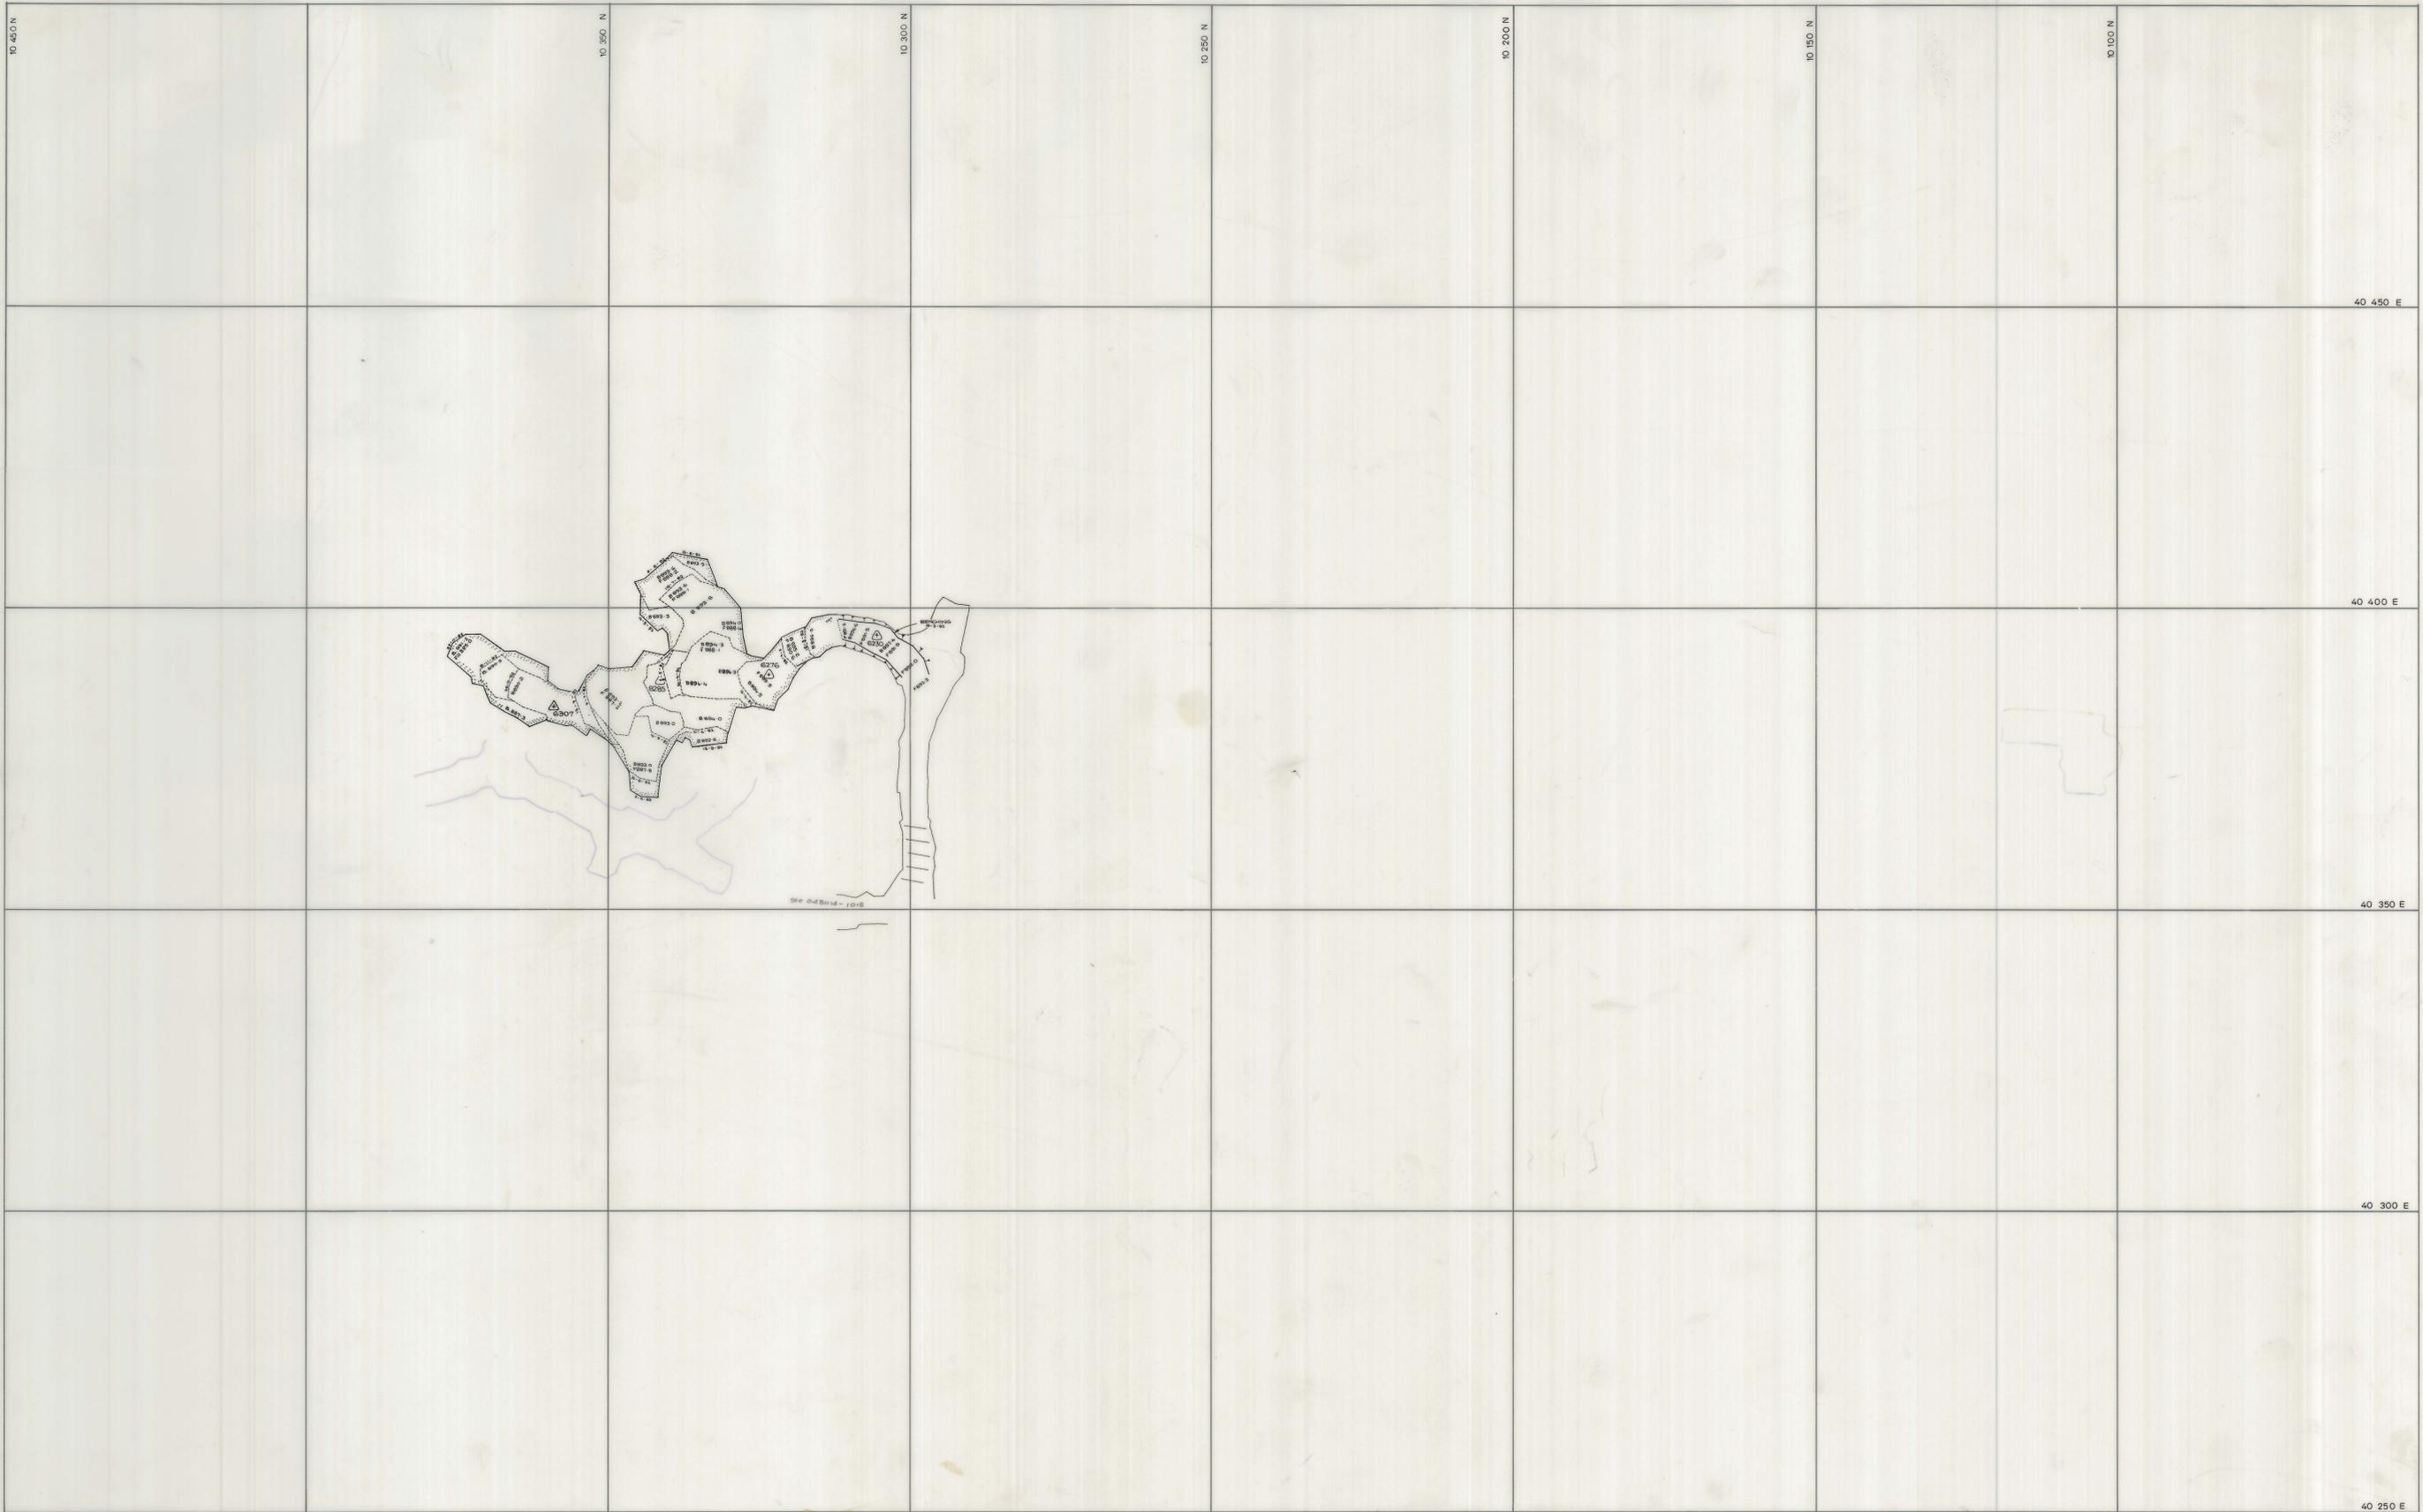

SCALE 1:500		LOCATION BOLD HEAD MINE	
		SUBJECT M37 2nd Lift	