



0374_1754

9th LIFT
WEDGE

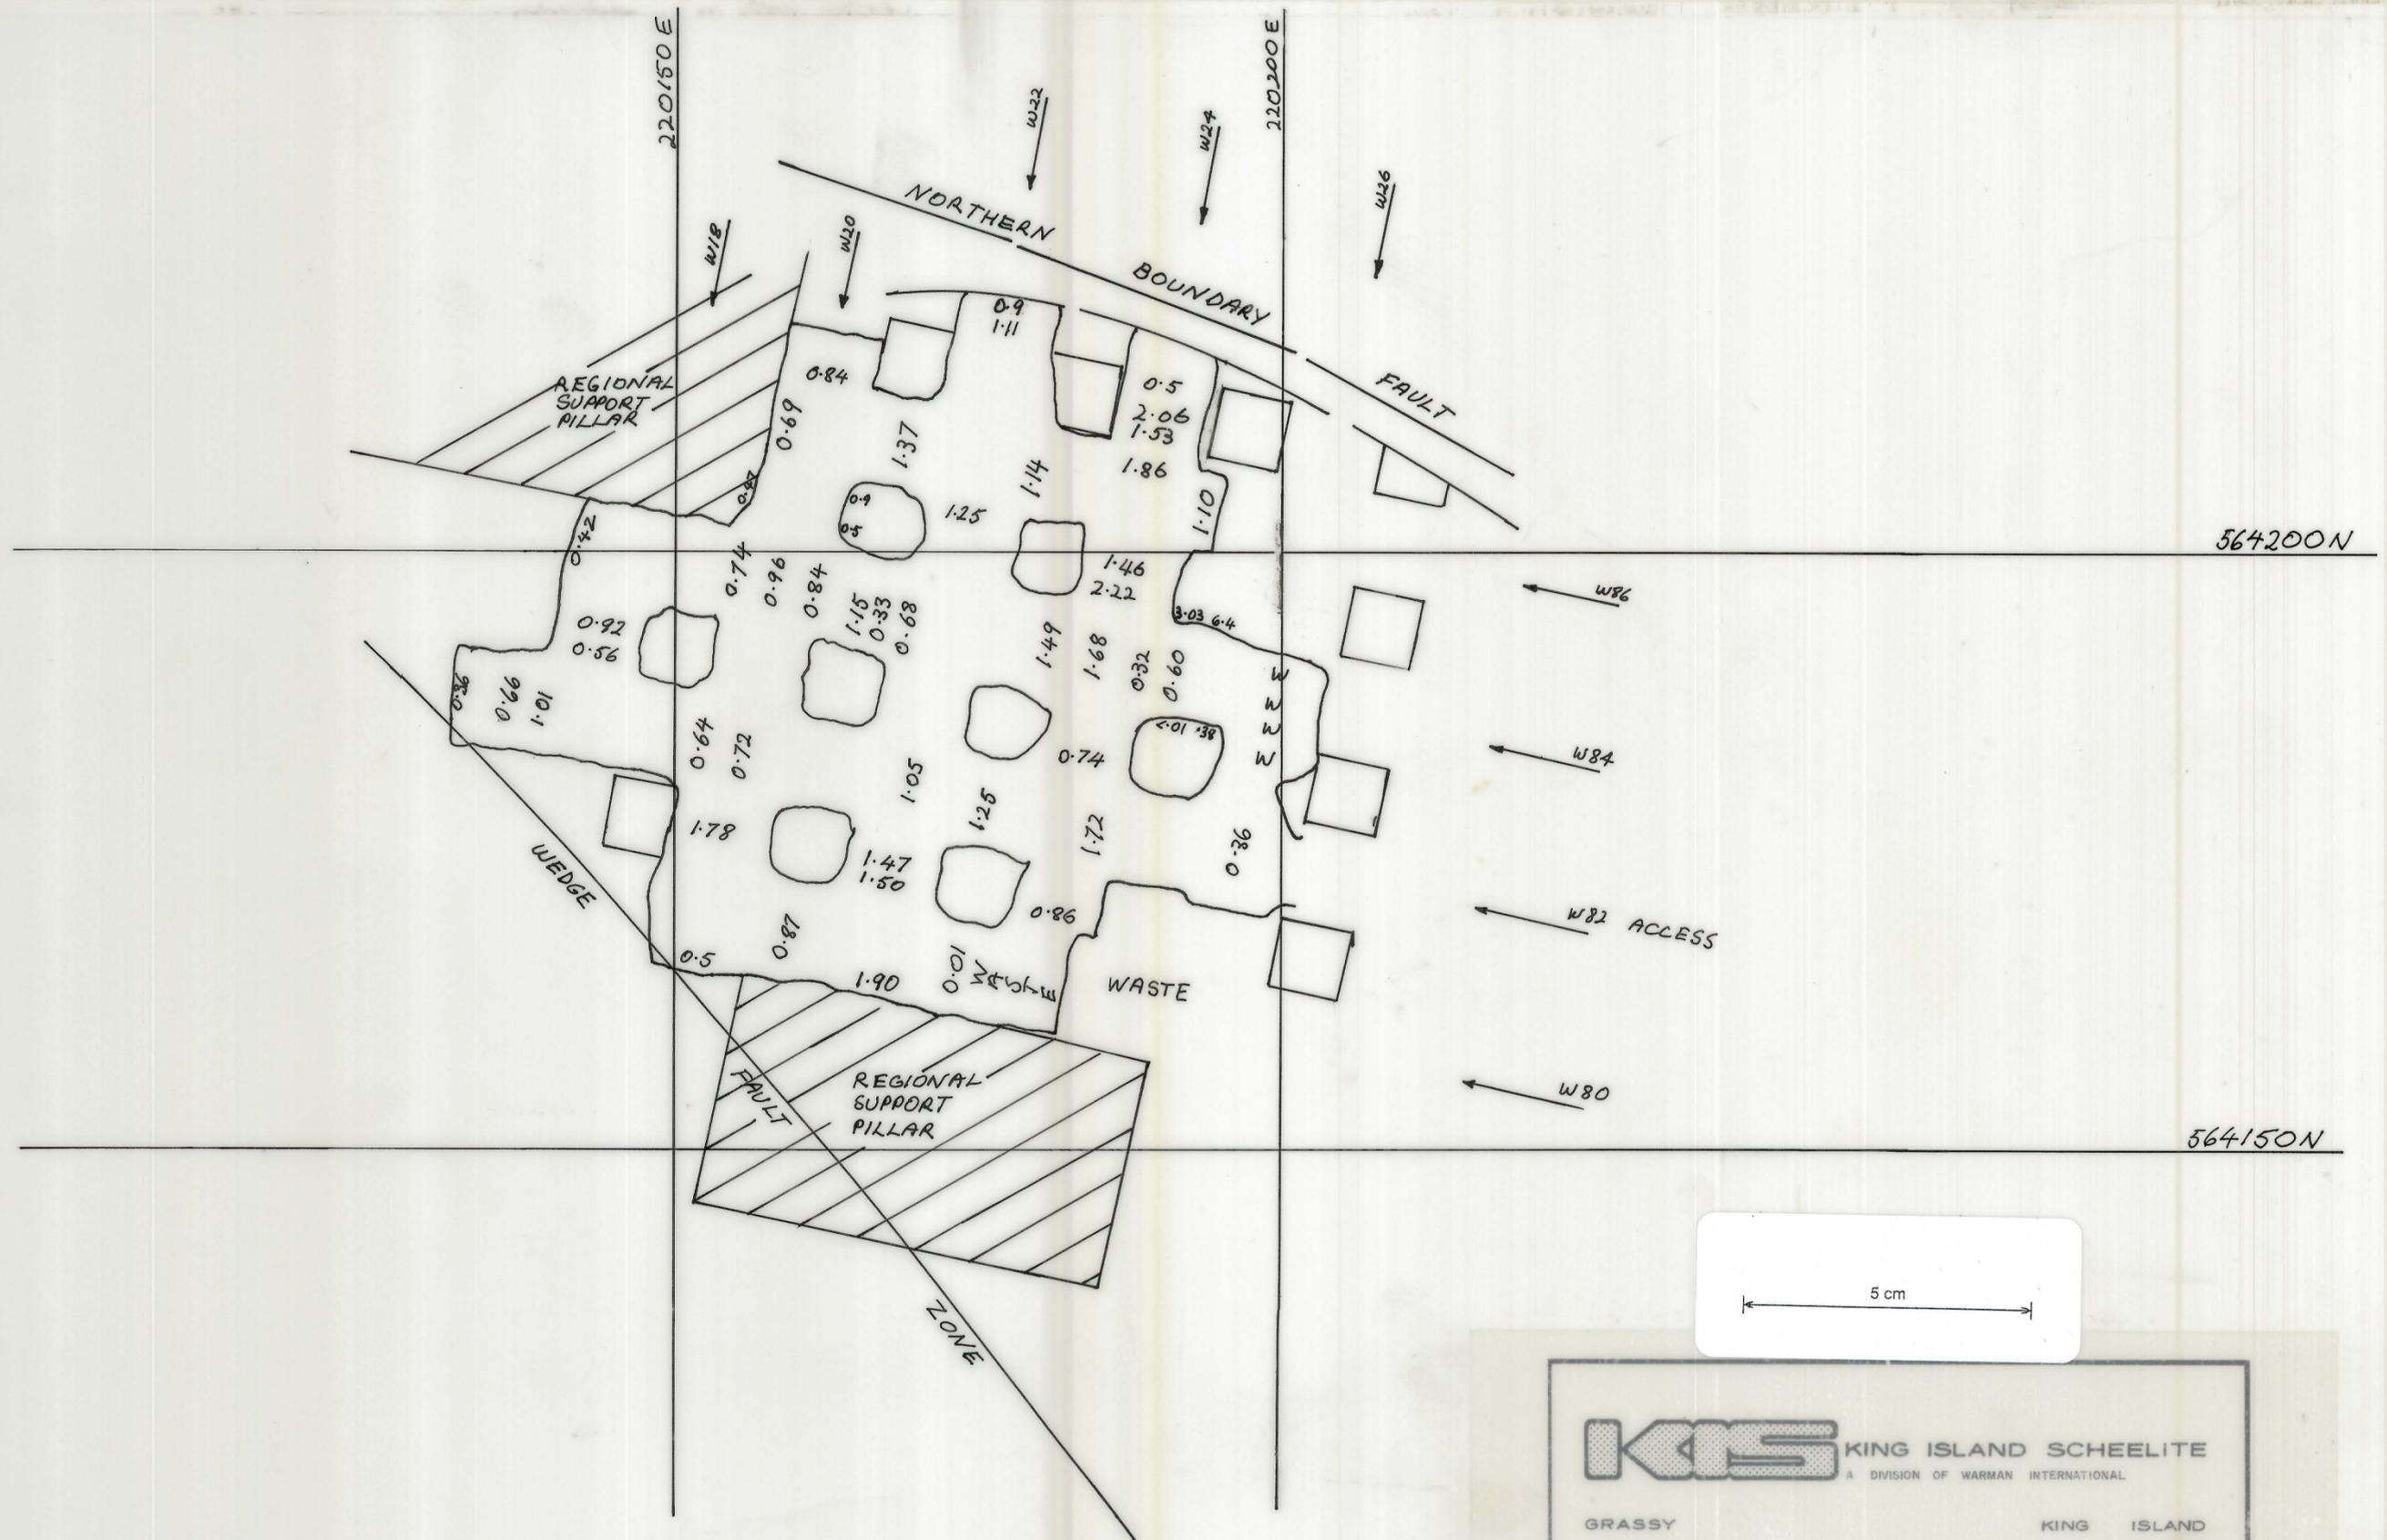

0374_1754

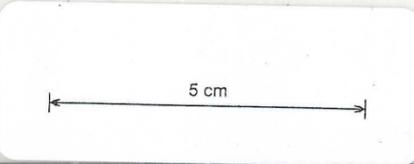

KIS KING ISLAND SCHEELITE
A DIVISION OF WARMAN INTERNATIONAL

GRASSY KING ISLAND

PLAN NUMBER **FINAL PLAN - GRAB SAMPLES**
9th LIFT. C-WEDGE -101 to -98m R.L.
SAMPLES FROM -99m APPROX