


0374\_1755

-104 to -101

ASSAYS  
8<sup>TH</sup> L

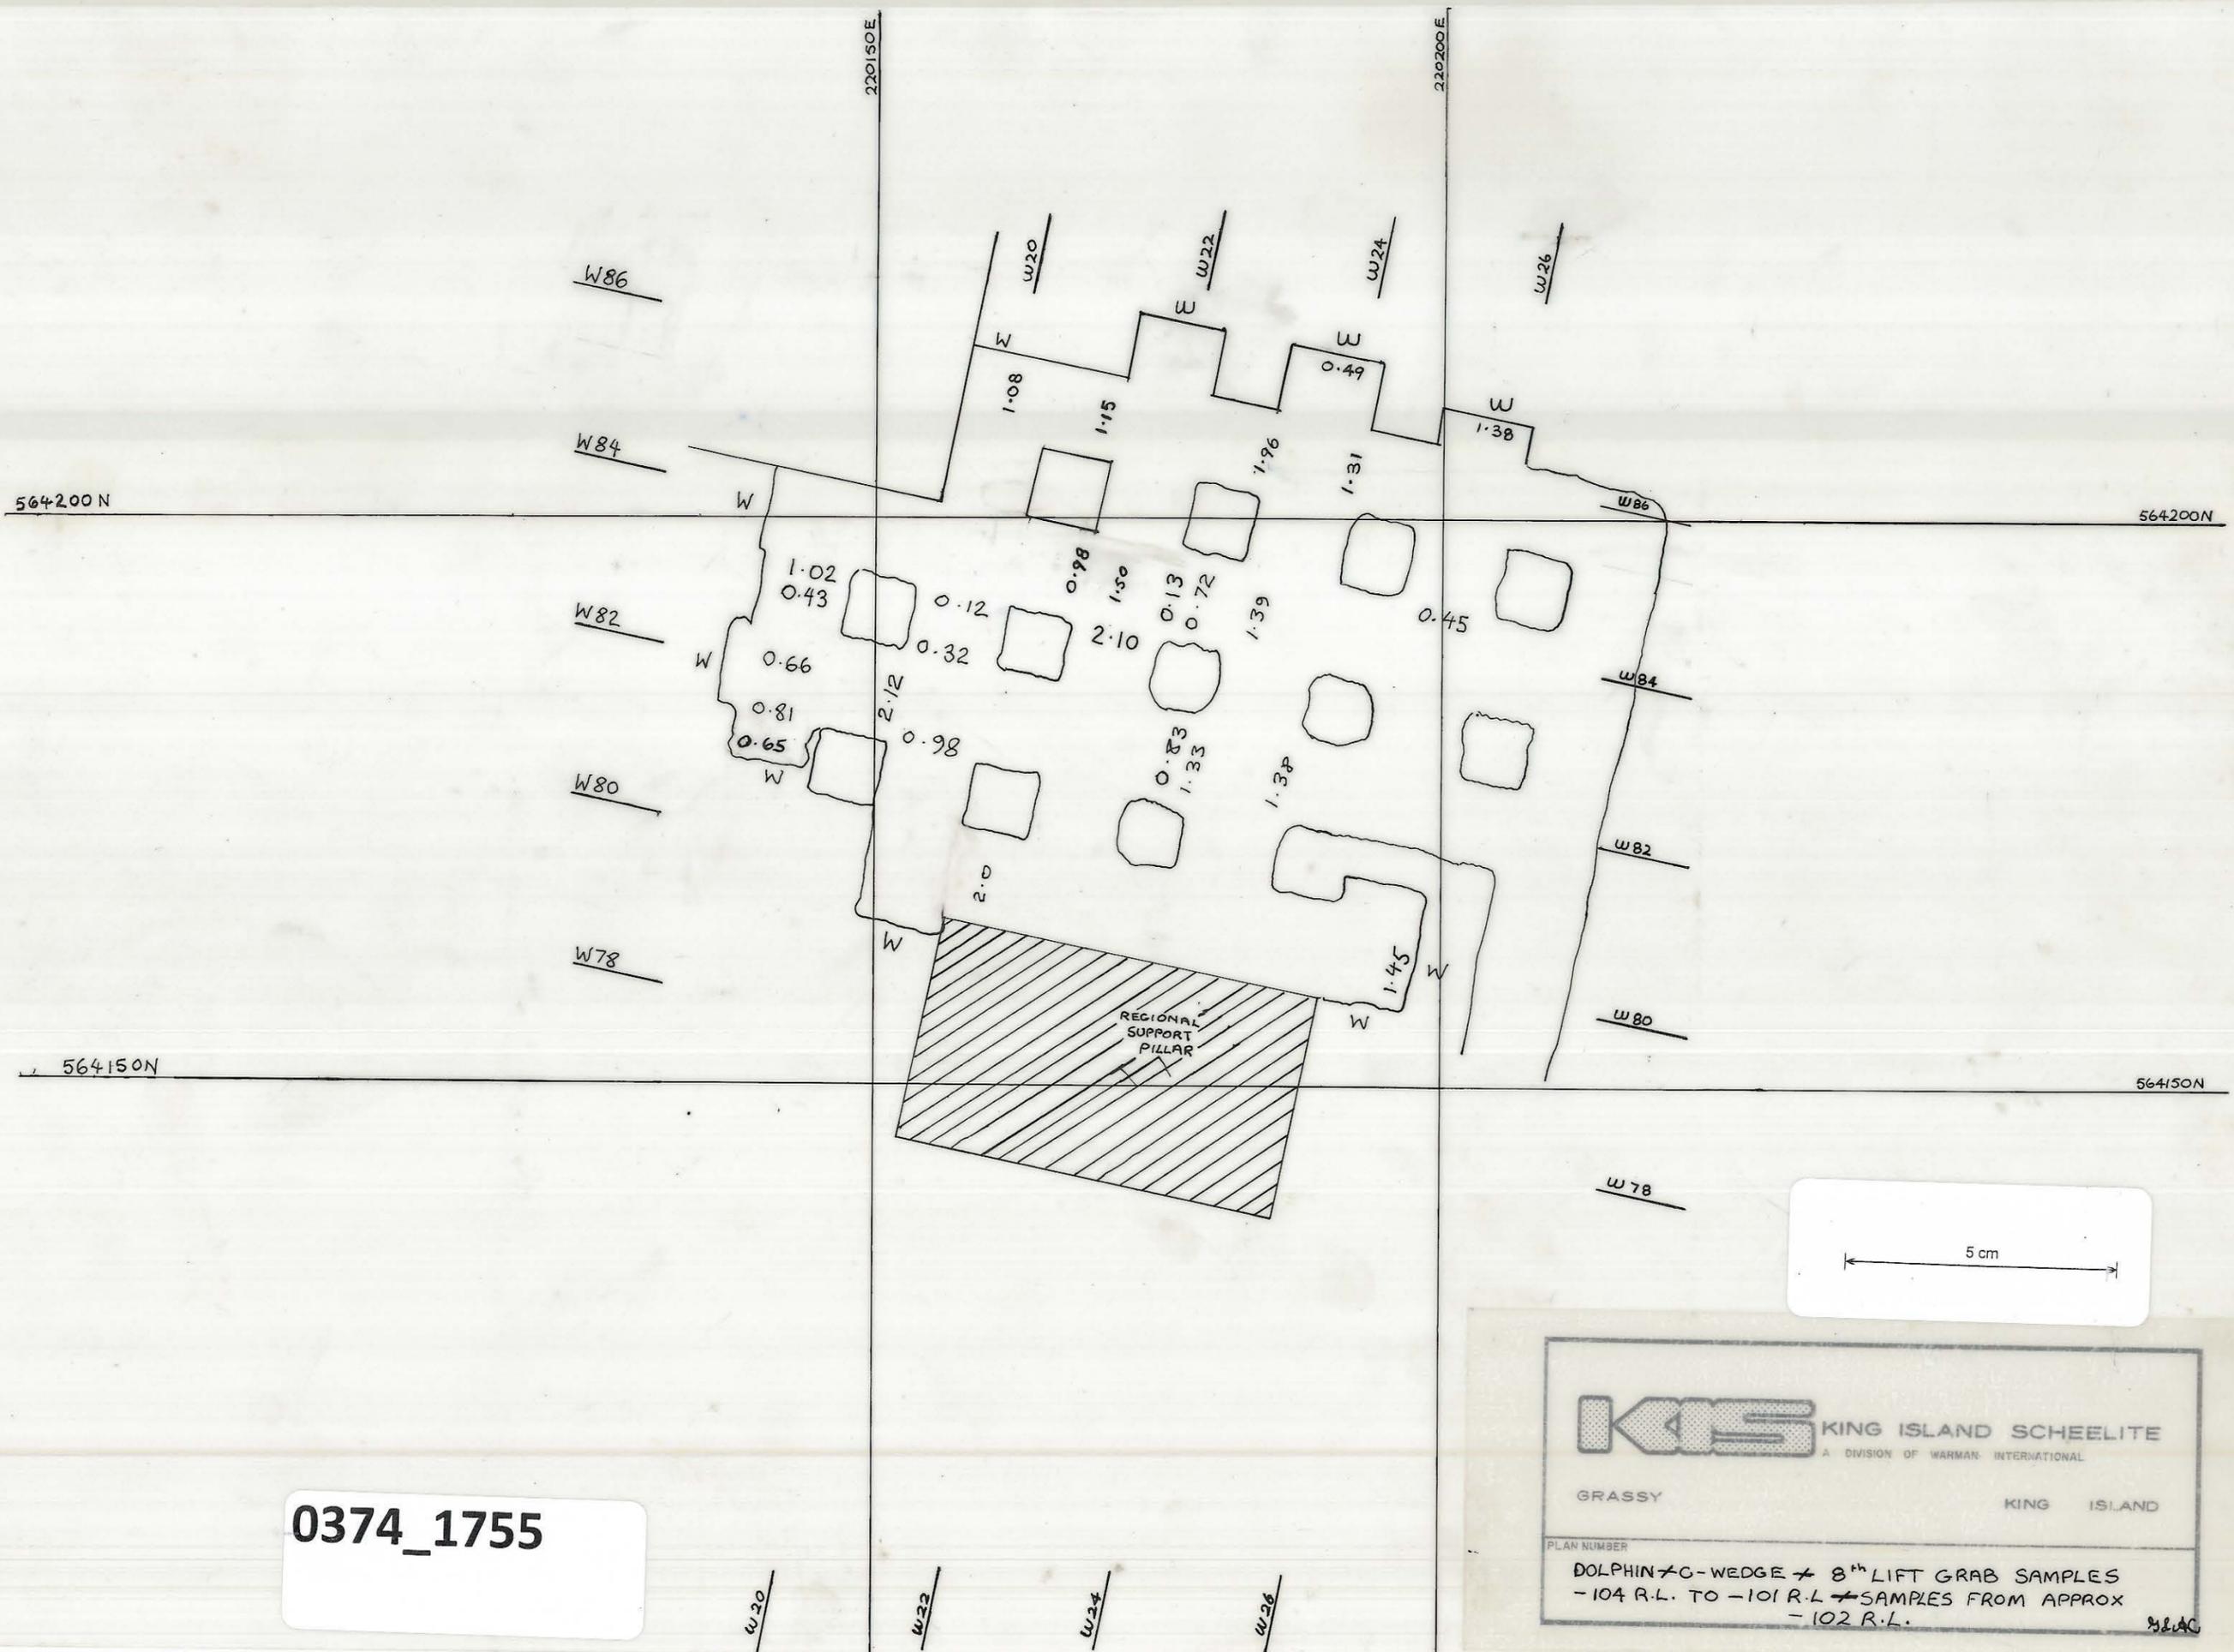

0374\_1755

**KIS KING ISLAND SCHEELITE**  
A DIVISION OF WARMAN INTERNATIONAL  
GRASSY KING ISLAND  
PLAN NUMBER  
DOLPHIN + C-WEDGE + 8<sup>TH</sup> LIFT GRAB SAMPLES  
- 104 R.L. TO - 101 R.L. + SAMPLES FROM APPROX  
- 102 R.L.