


0374_1756

UPPER
WEDGE
14th lift



- * LAMP VALUE
- //// MINING LIMIT
- WASTE MINED DISCARDED
- WASTE MINED

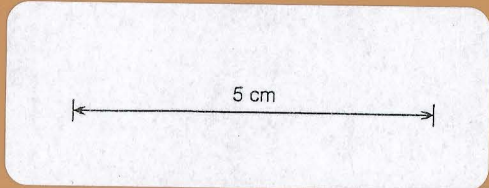

0374_1756

KIS KING ISLAND SCHEELITE A DIVISION OF WARMAN INTERNATIONAL	
GRASSY	KING ISLAND
GRAB SAMPLES WEDGE	
PLAN NUMBER	
LIFT	DATE
R.L.	* LAMPED VALUE