

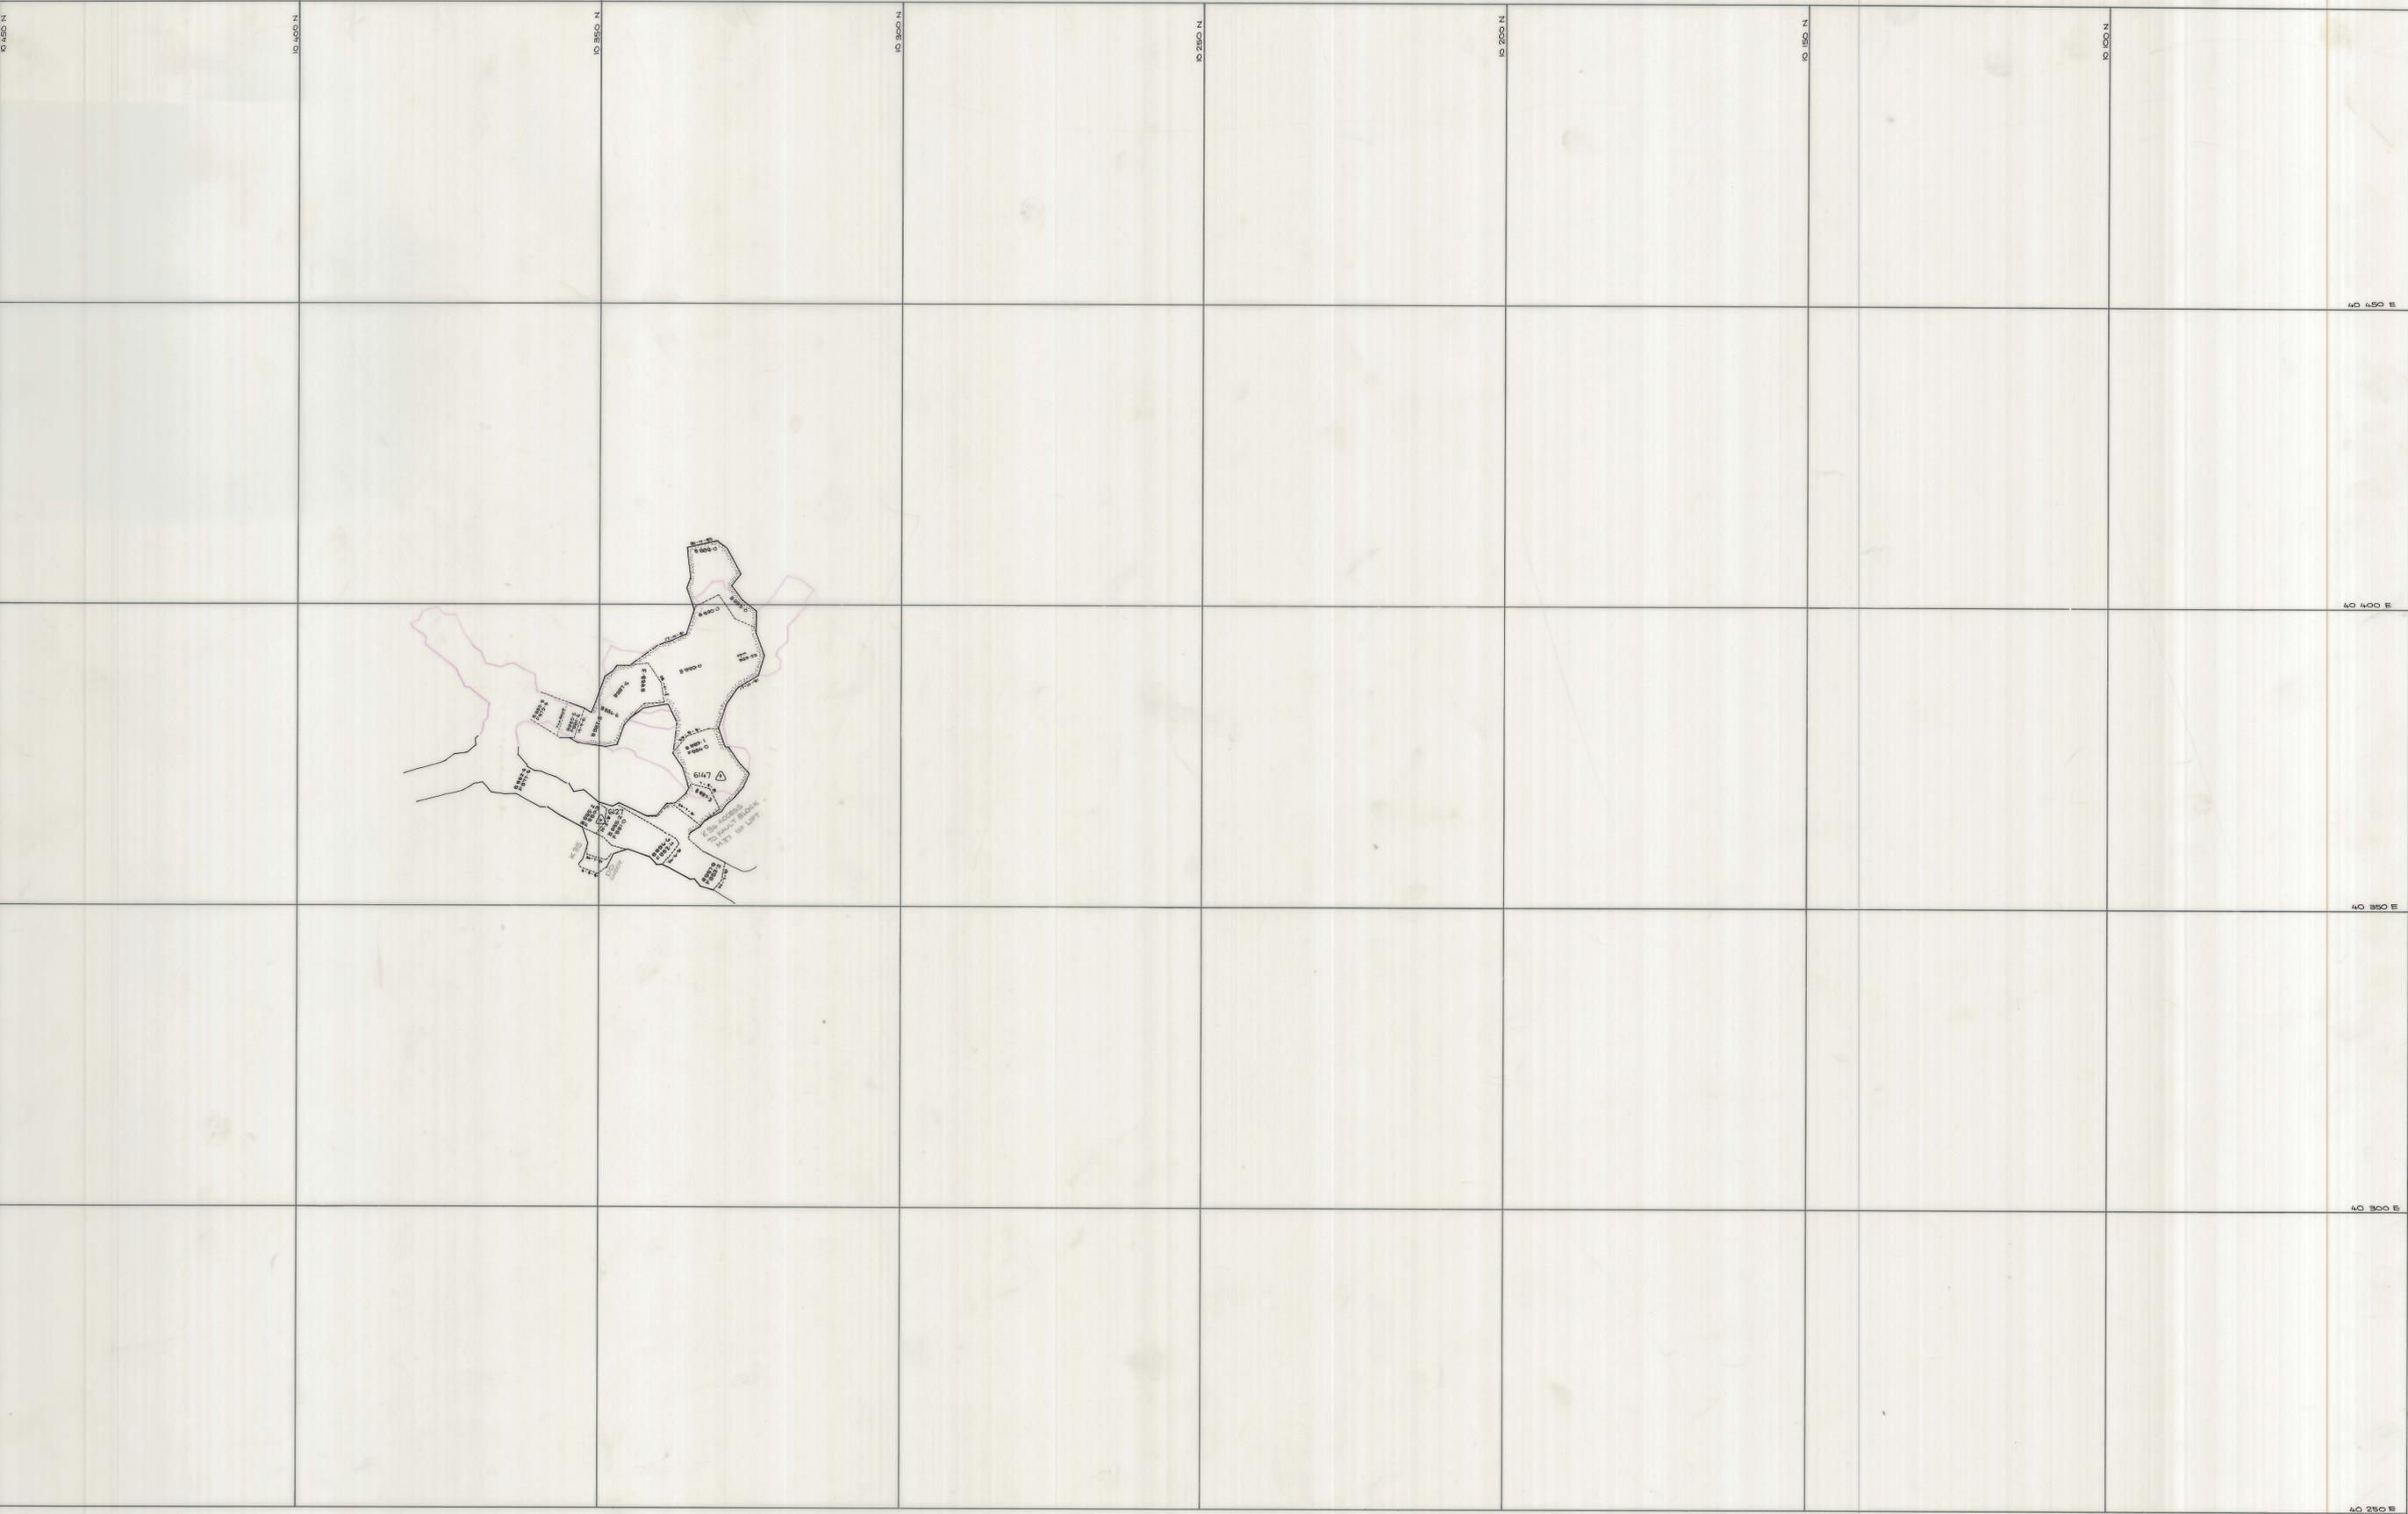
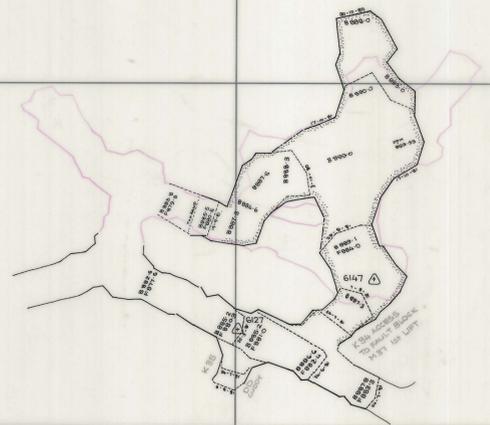


0324 - 176

04BH15-111-99

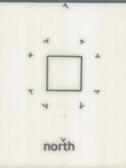

SCALE 1:500

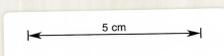

LOCATION	BOLD HEAD MINE
SUBJECT	FAULT BLOCK

KIS KING ISLAND SCHEELITE
A DIVISION OF WARMAN INTERNATIONAL

GRASSY KING ISLAND

PLAN NUMBER 04BH15 - 111 - 99