

0374_1760

564200N

564150N

564100N


564100

220150E

0374_1760

220200E

220250E

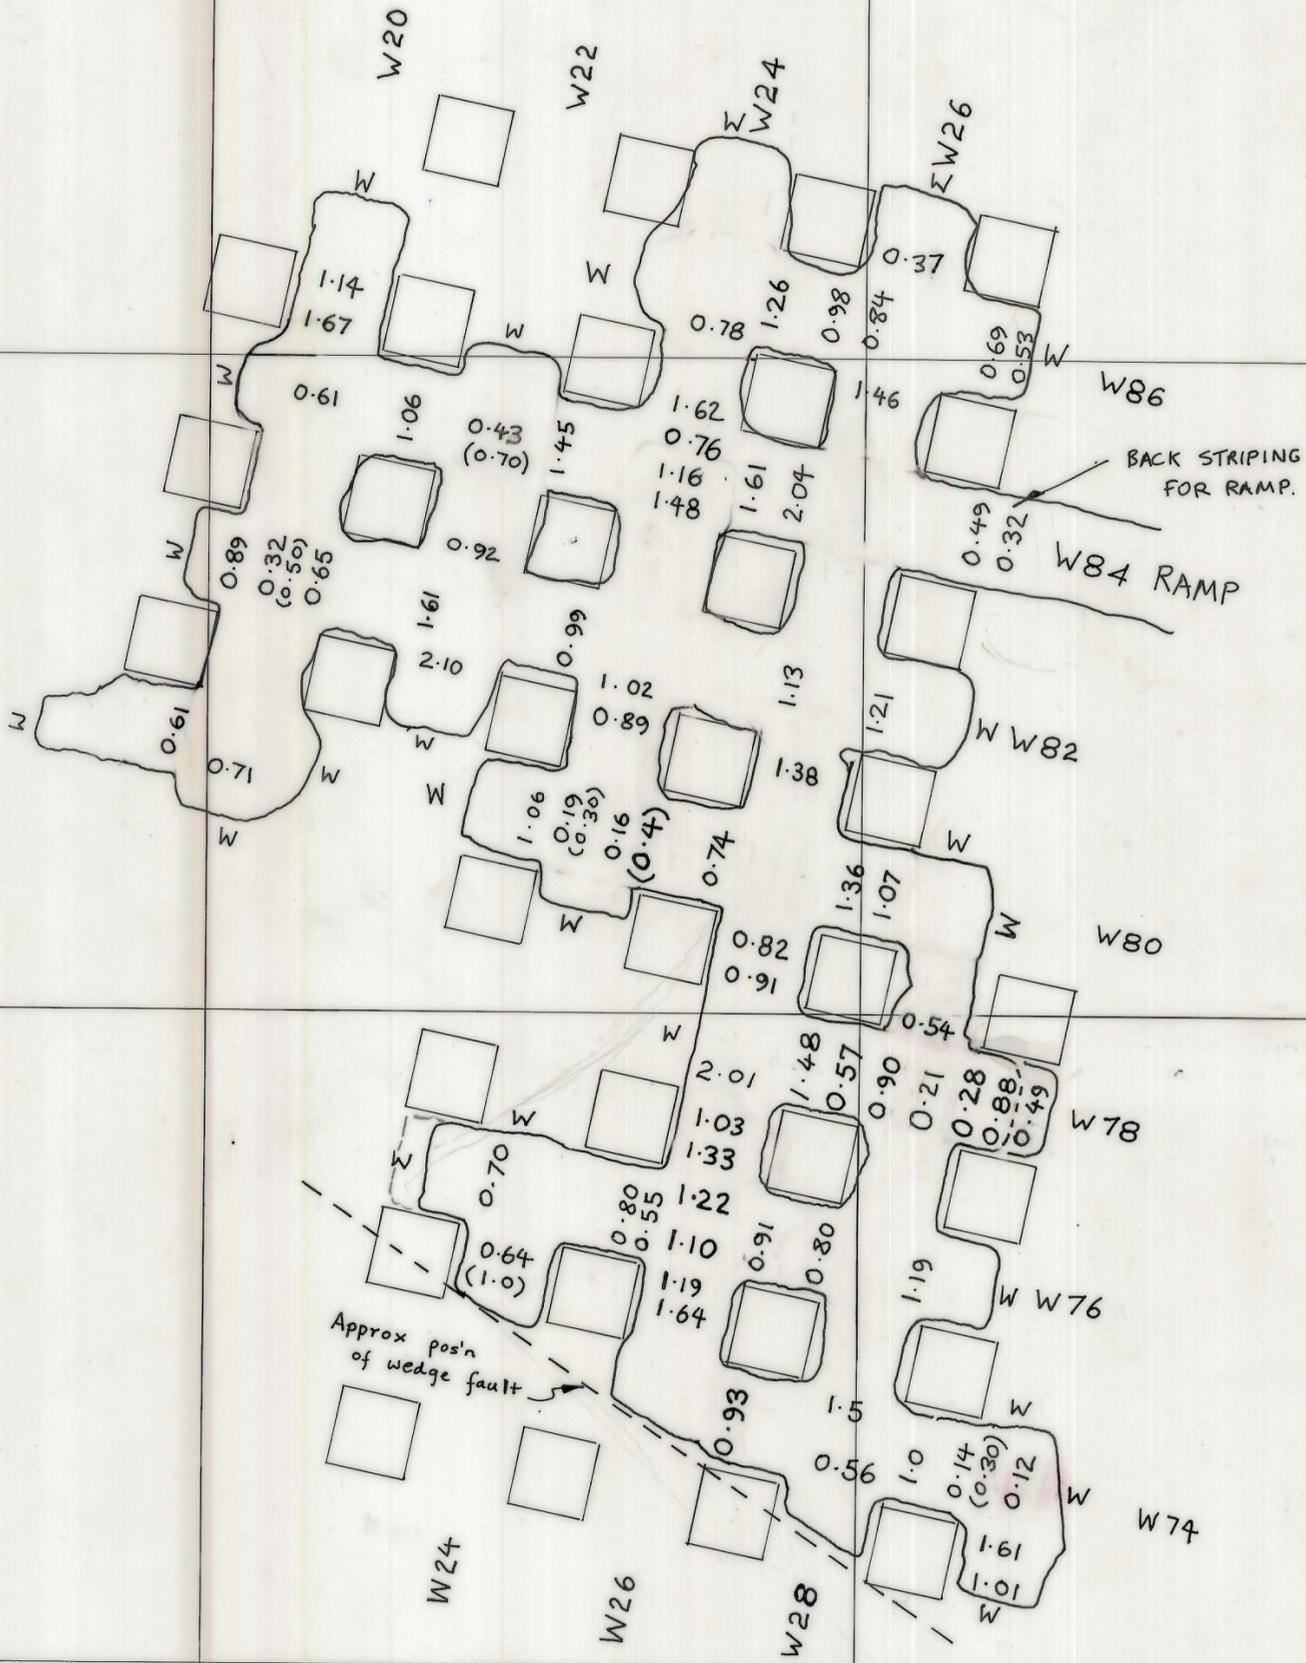

5 cm

KING ISLAND SCHEELITE

DATE: SCALE: 1:500

MINE: DOLPHIN DWG/NO.:

C - WEDGE 5TH LIFT
-113 m RL. to -110 m RL.
GRAB SAMPLE ASSAYS.

PRELIMINARY FINAL