


0374_1766

0374_1766

5 cm

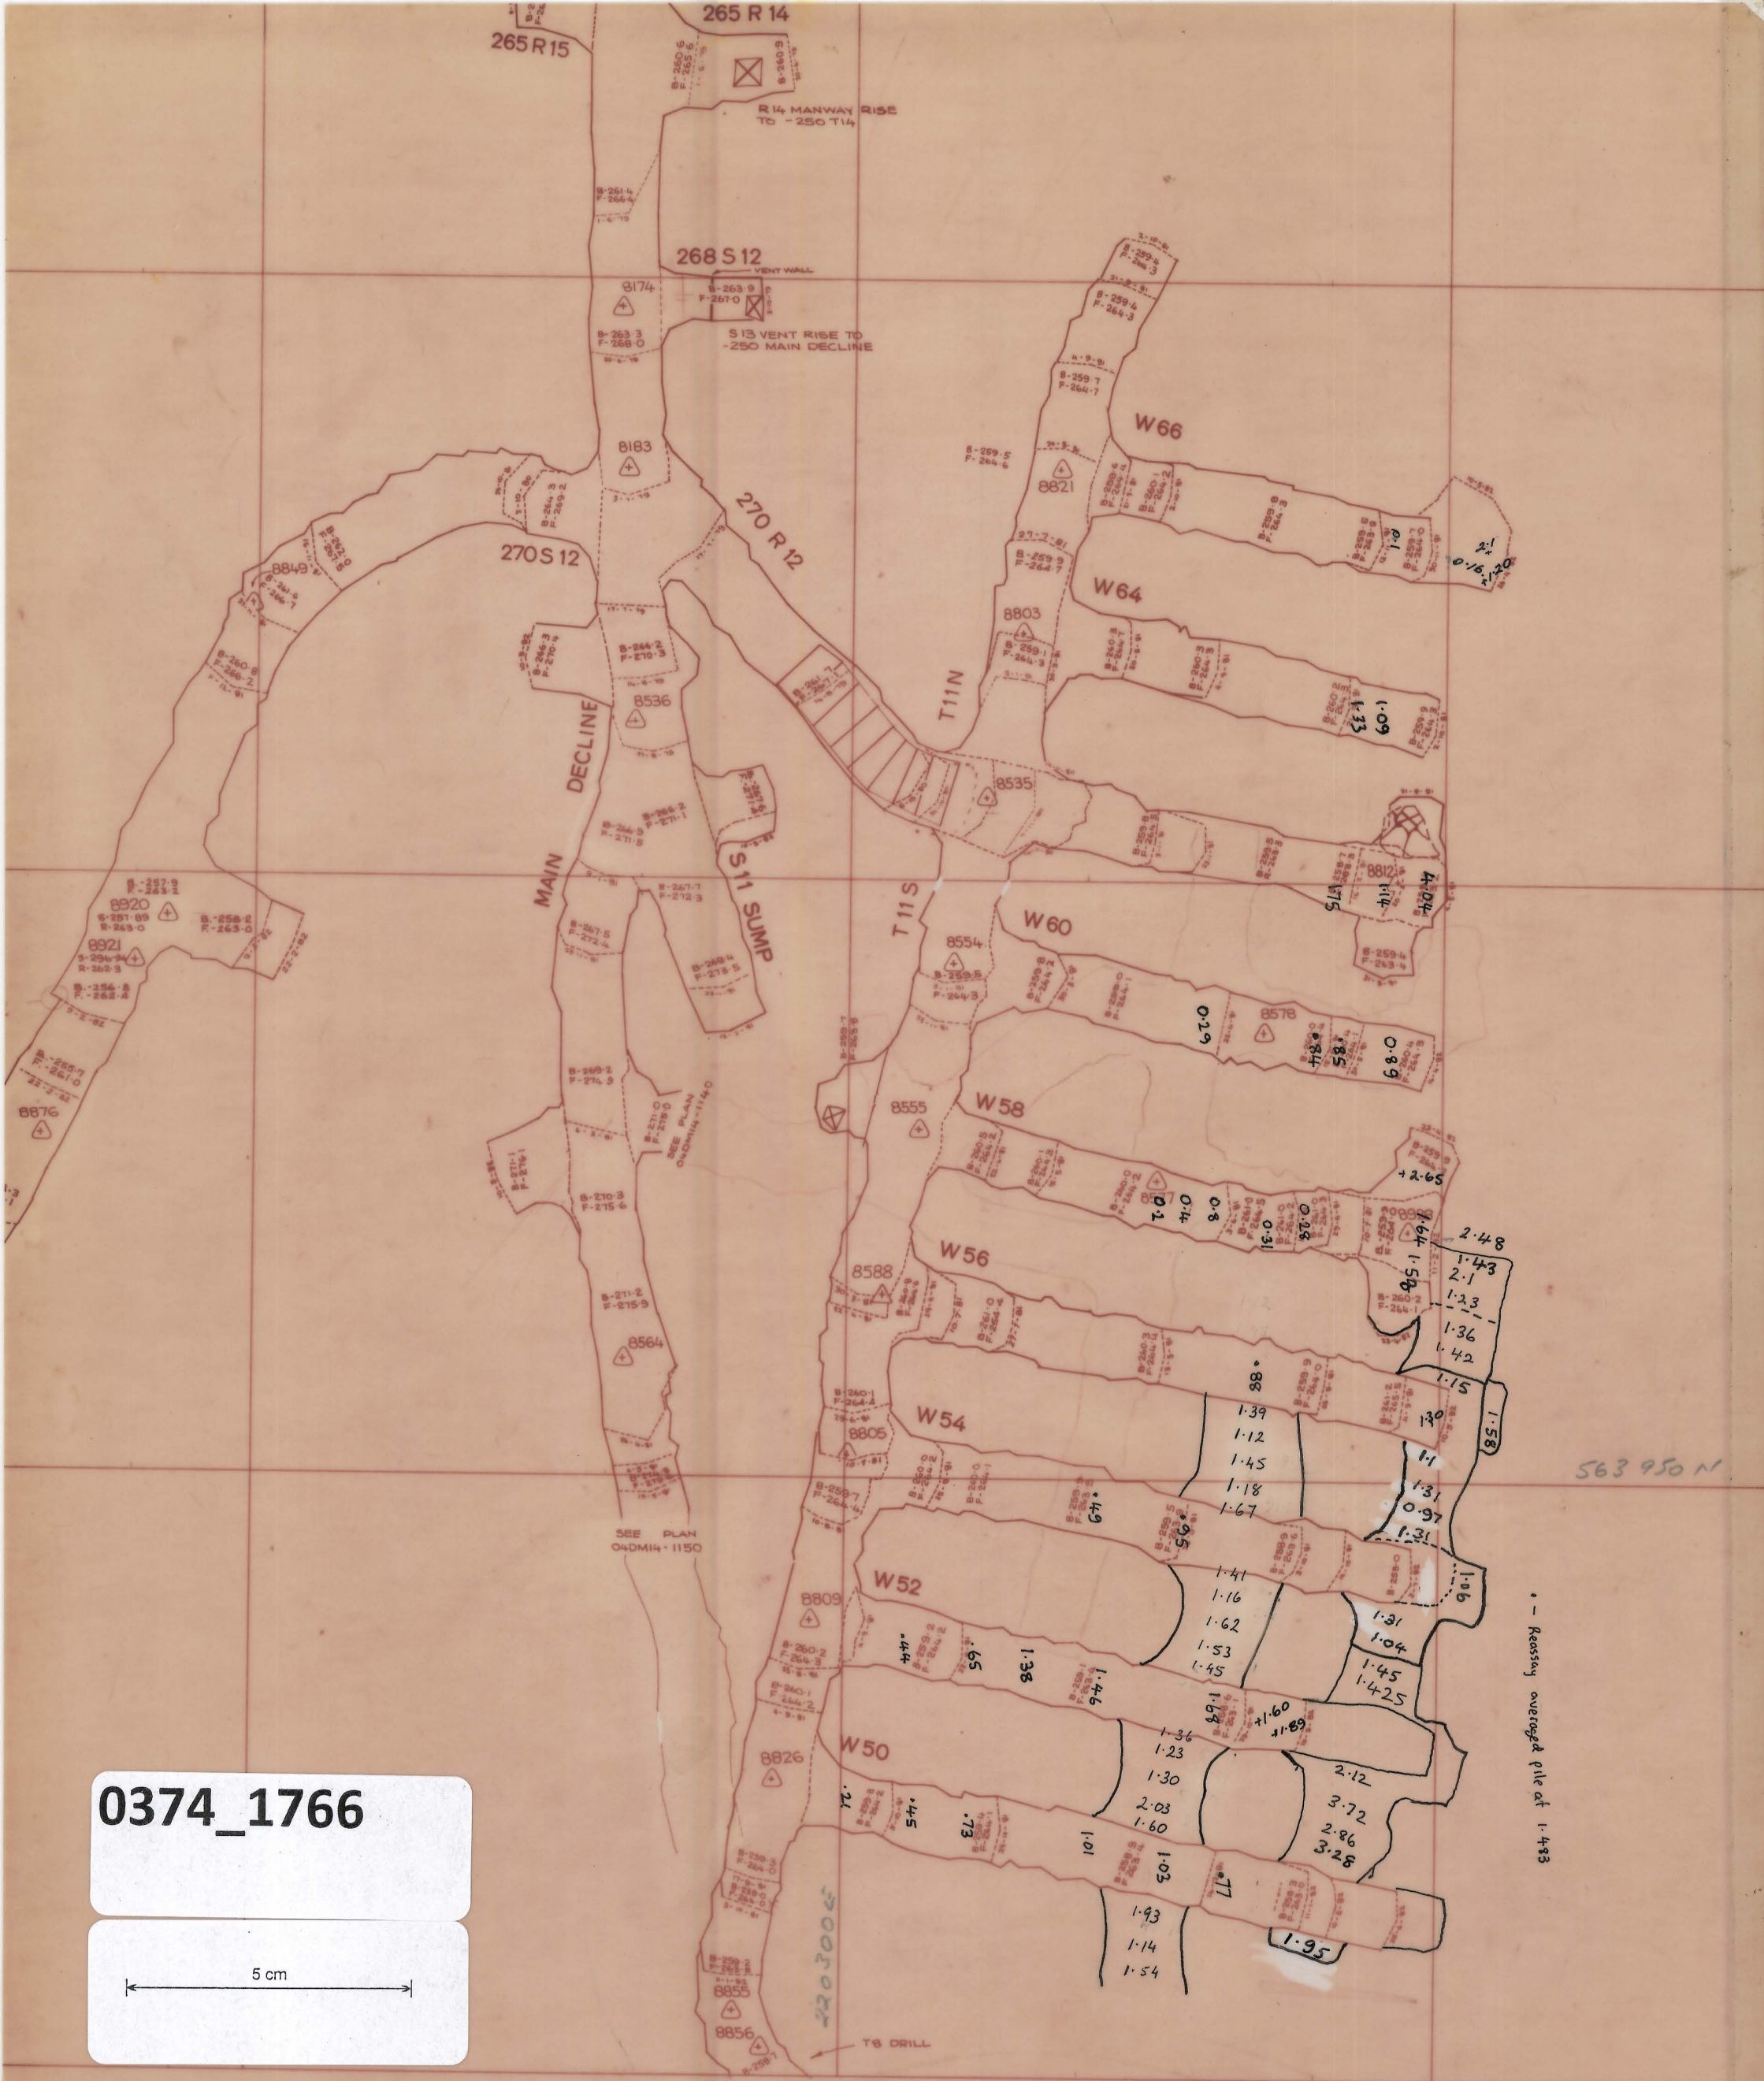

O4DM14 - 1131 ADJOINS

1:500

LOCATION

DOLPHIN MINE

SUBJECT

-275 m ZONE

north

KIS KING ISLAND

A DIVISION OF WARM

GRASSY

PLAN NUMBER

O4DM14 - 11