


0374\_1795

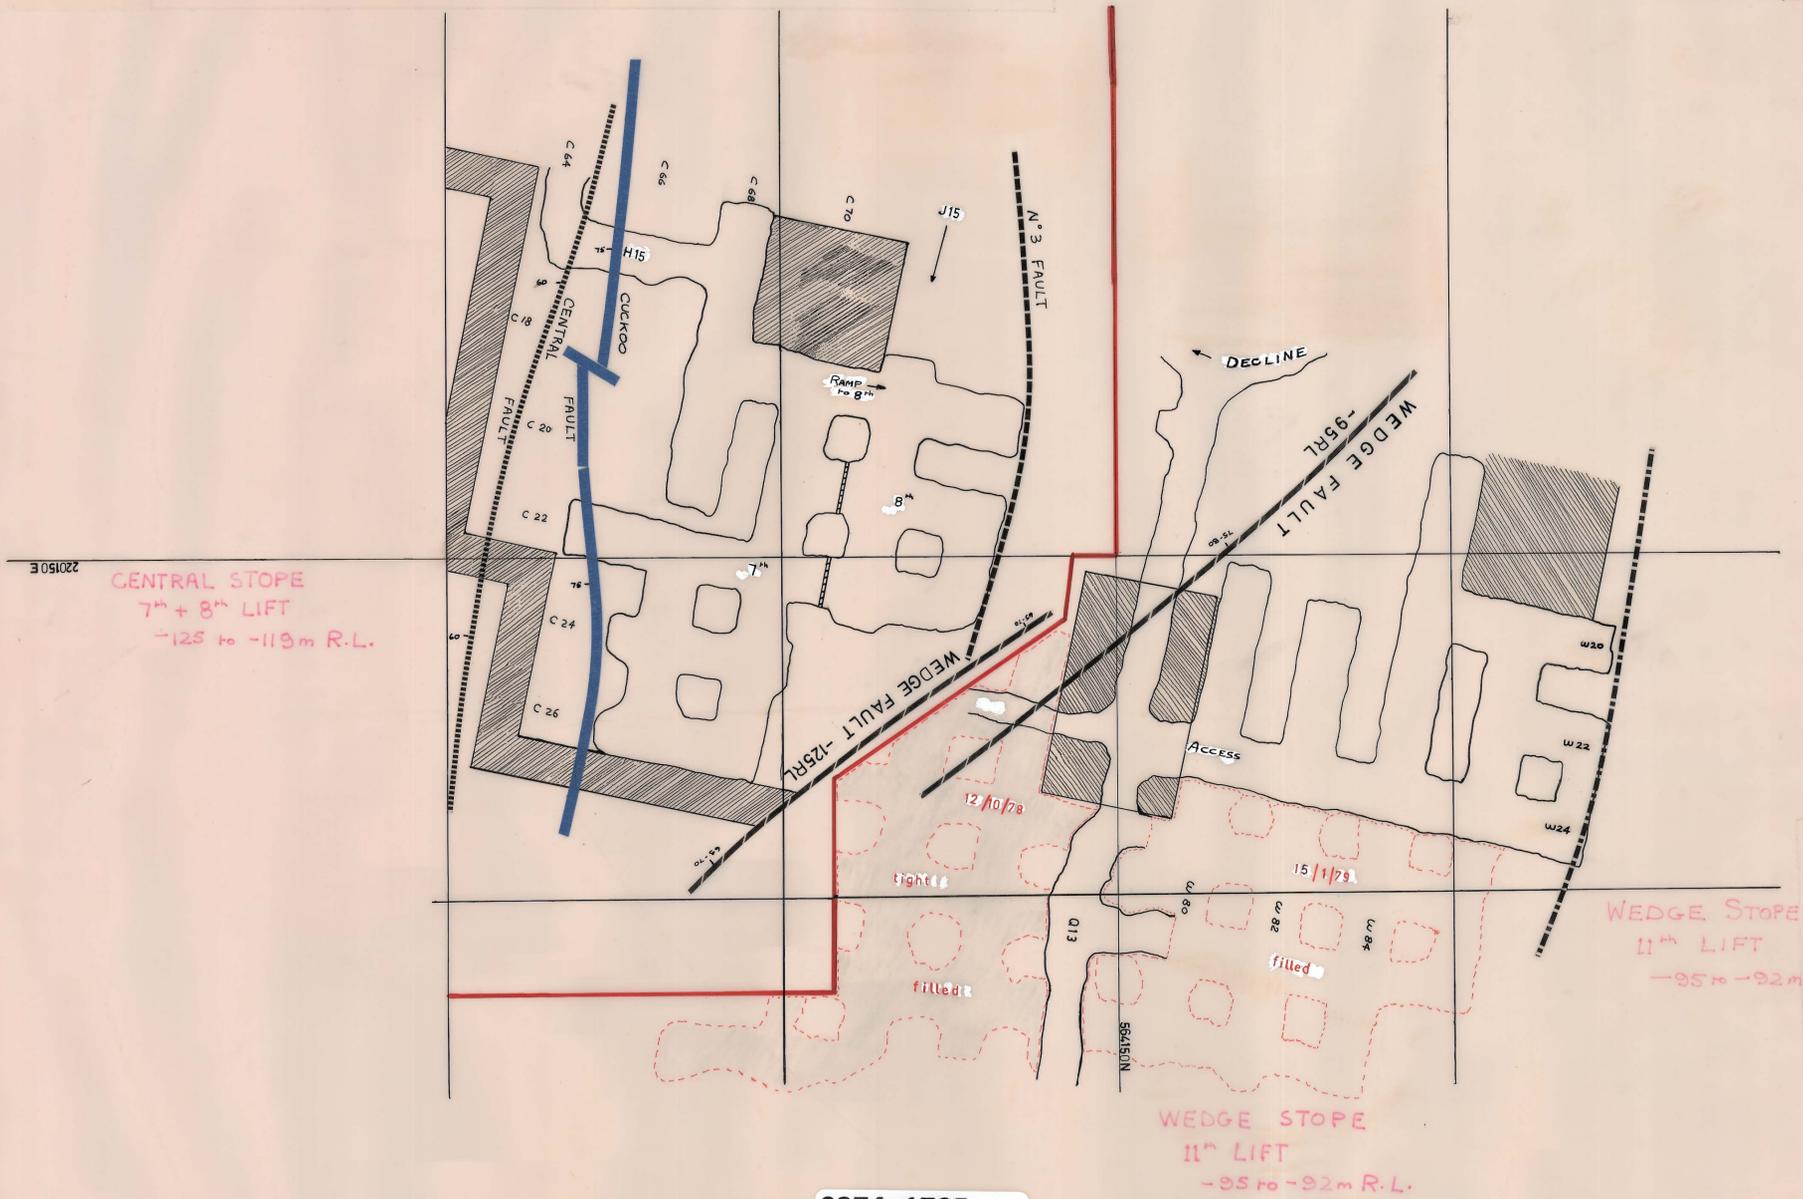

0374\_1795

5 cm