



0374-180

04BH15 - 112 - 99

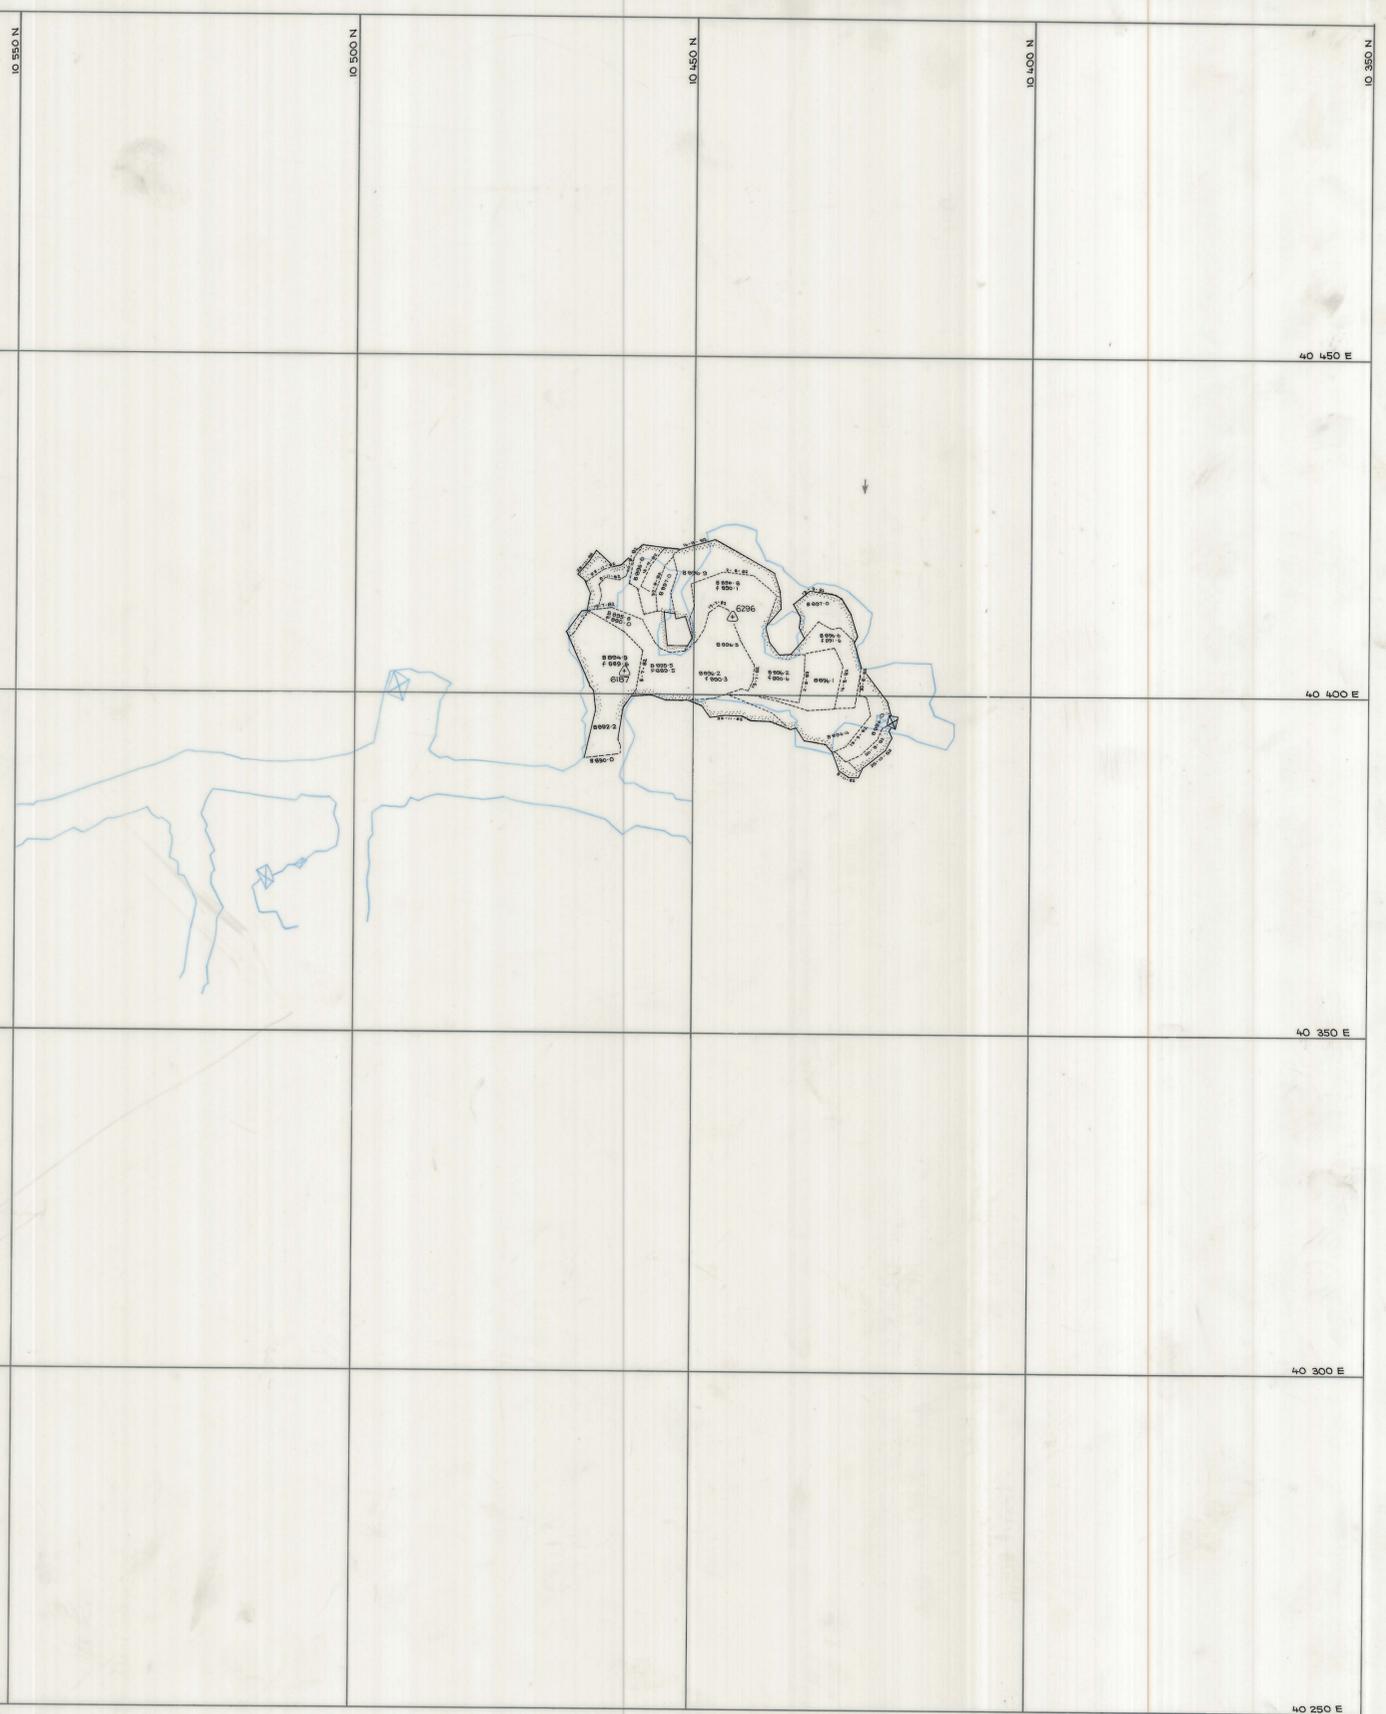

SCALE 1: 500

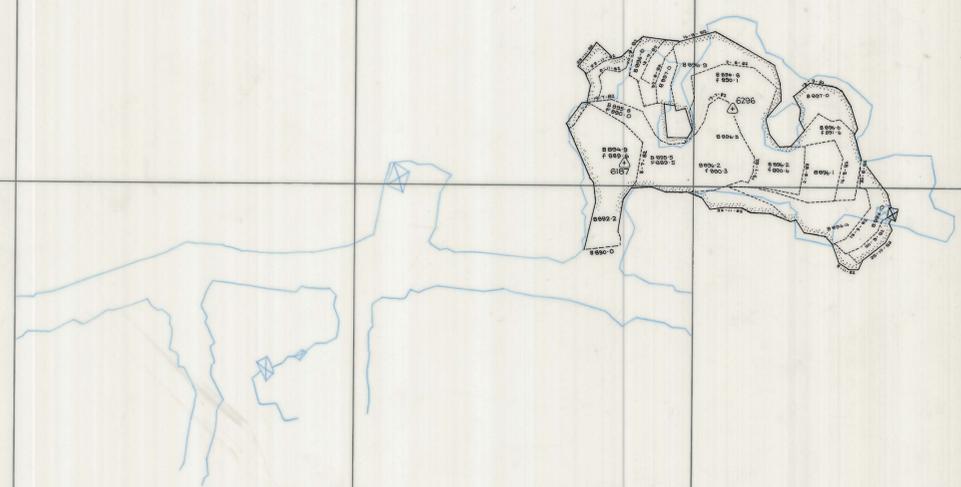

LOCATION  
BOLD HEAD MINE

SUBJECT  
P 43 STOPE  
1st lift

**KIS** KING ISLAND SCHEELITE  
A DIVISION OF WARMAN INTERNATIONAL

GRASSY KING ISLAND

PLAN NUMBER

04BH15 - 112 - 99