



0374\_1807

GRAB SAMPLES  
C-WEDGE 12" LIFT  
-92m to -89m

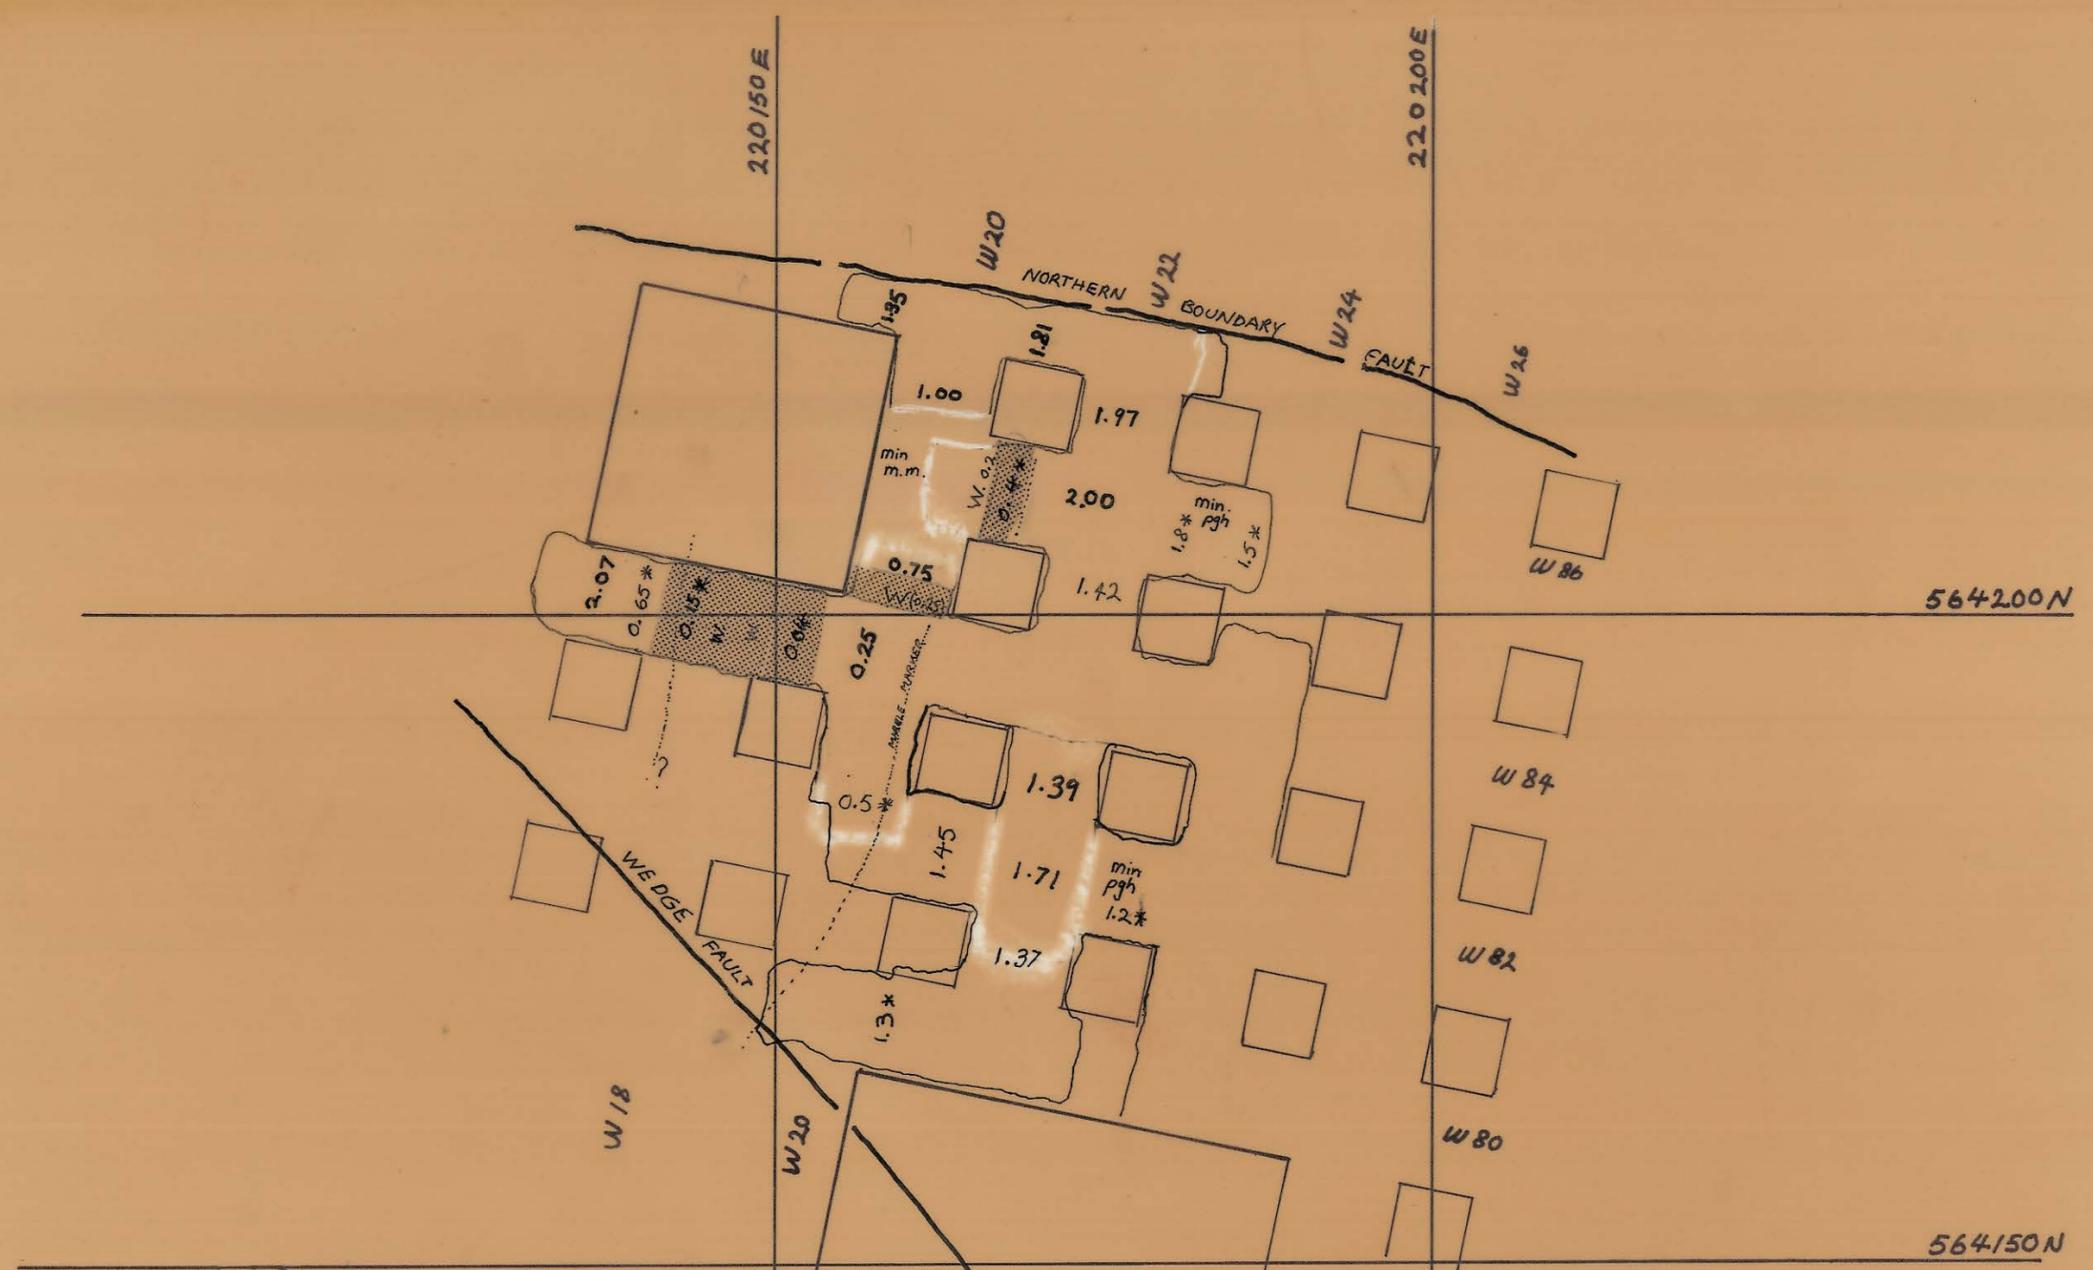

0374\_1807

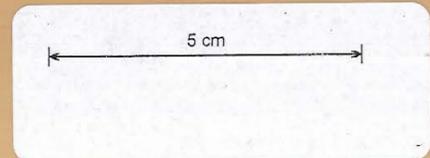

**KIS** KING ISLAND SCHEELITE  
A DIVISION OF WARMAN INTERNATIONAL

GRASSY KING ISLAND

**GRAB SAMPLES WEDGE**

PLAN NUMBER

LIFT 12 DATE 28.6.79

R.L. -92 to -89 \* LAMPED VALUE.