

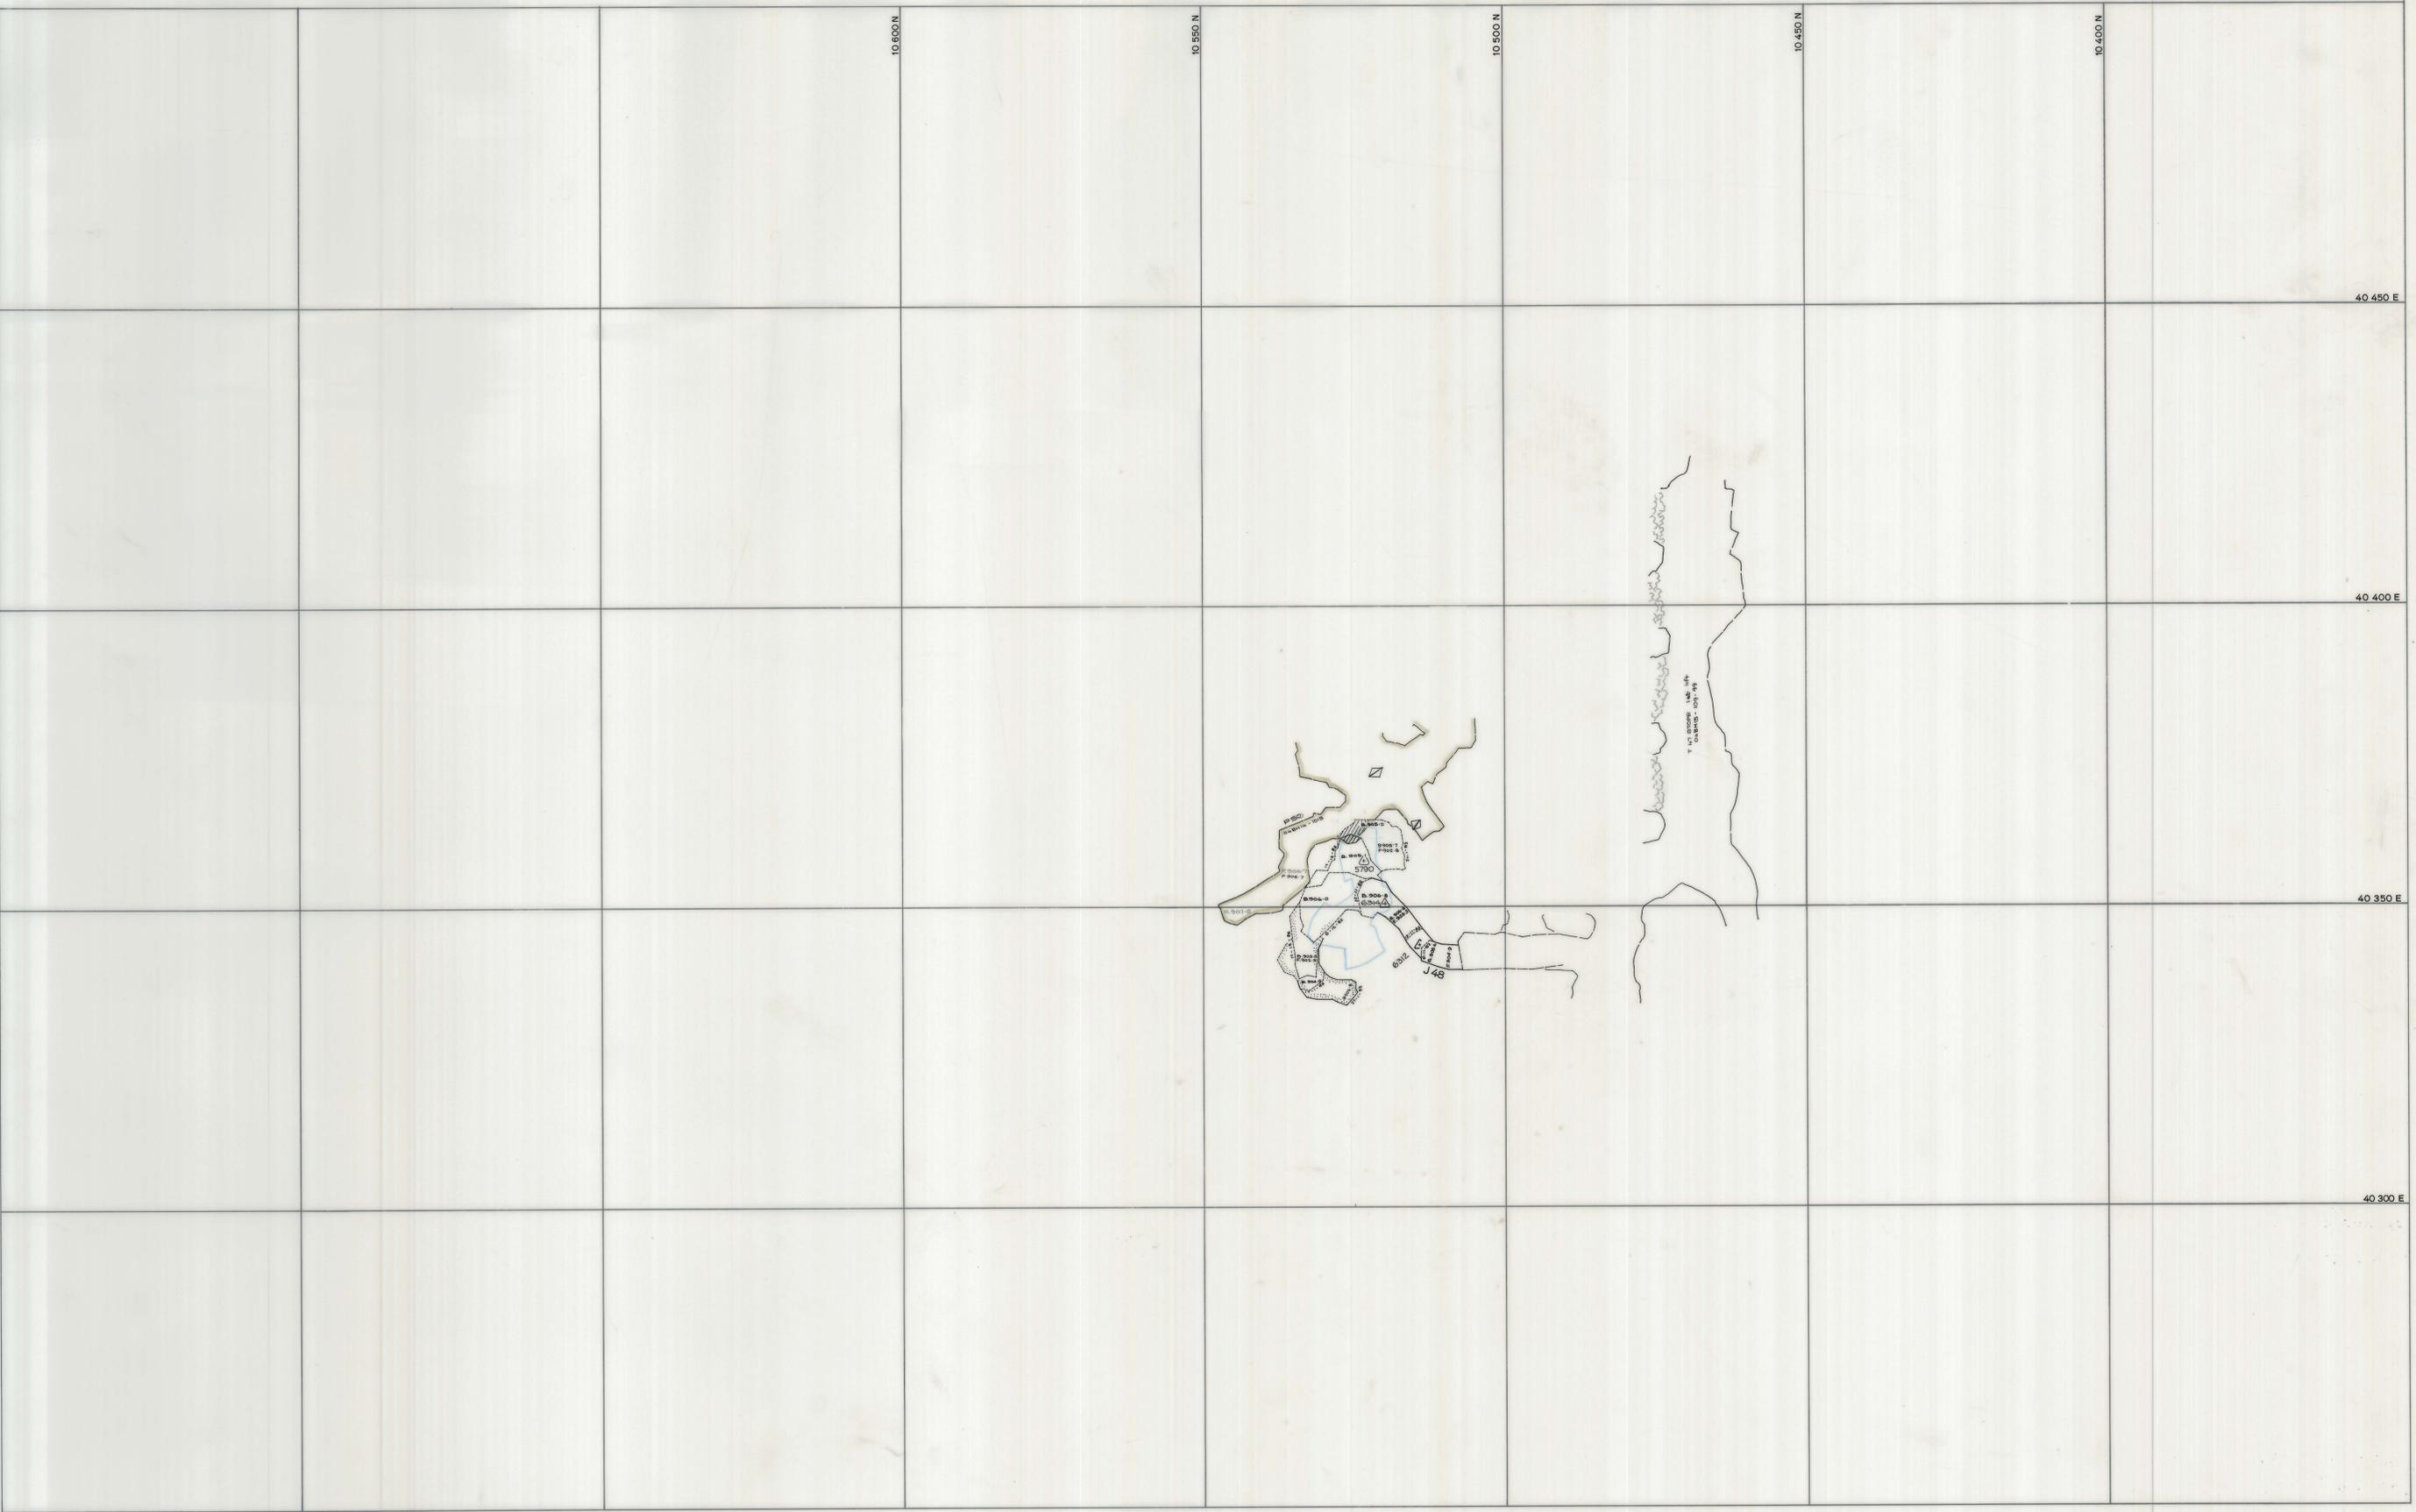


0374-181

04 BH 15 - 113 - 98

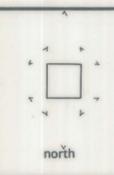

SCALE 1: 500

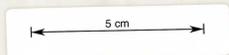

LOCATION

BOLD HEAD MINE

SUBJECT

N 51
2nd Lift



GRASSY KING ISLAND

PLAN NUMBER

04 BH 15 - 113 - 98