


0374_1810

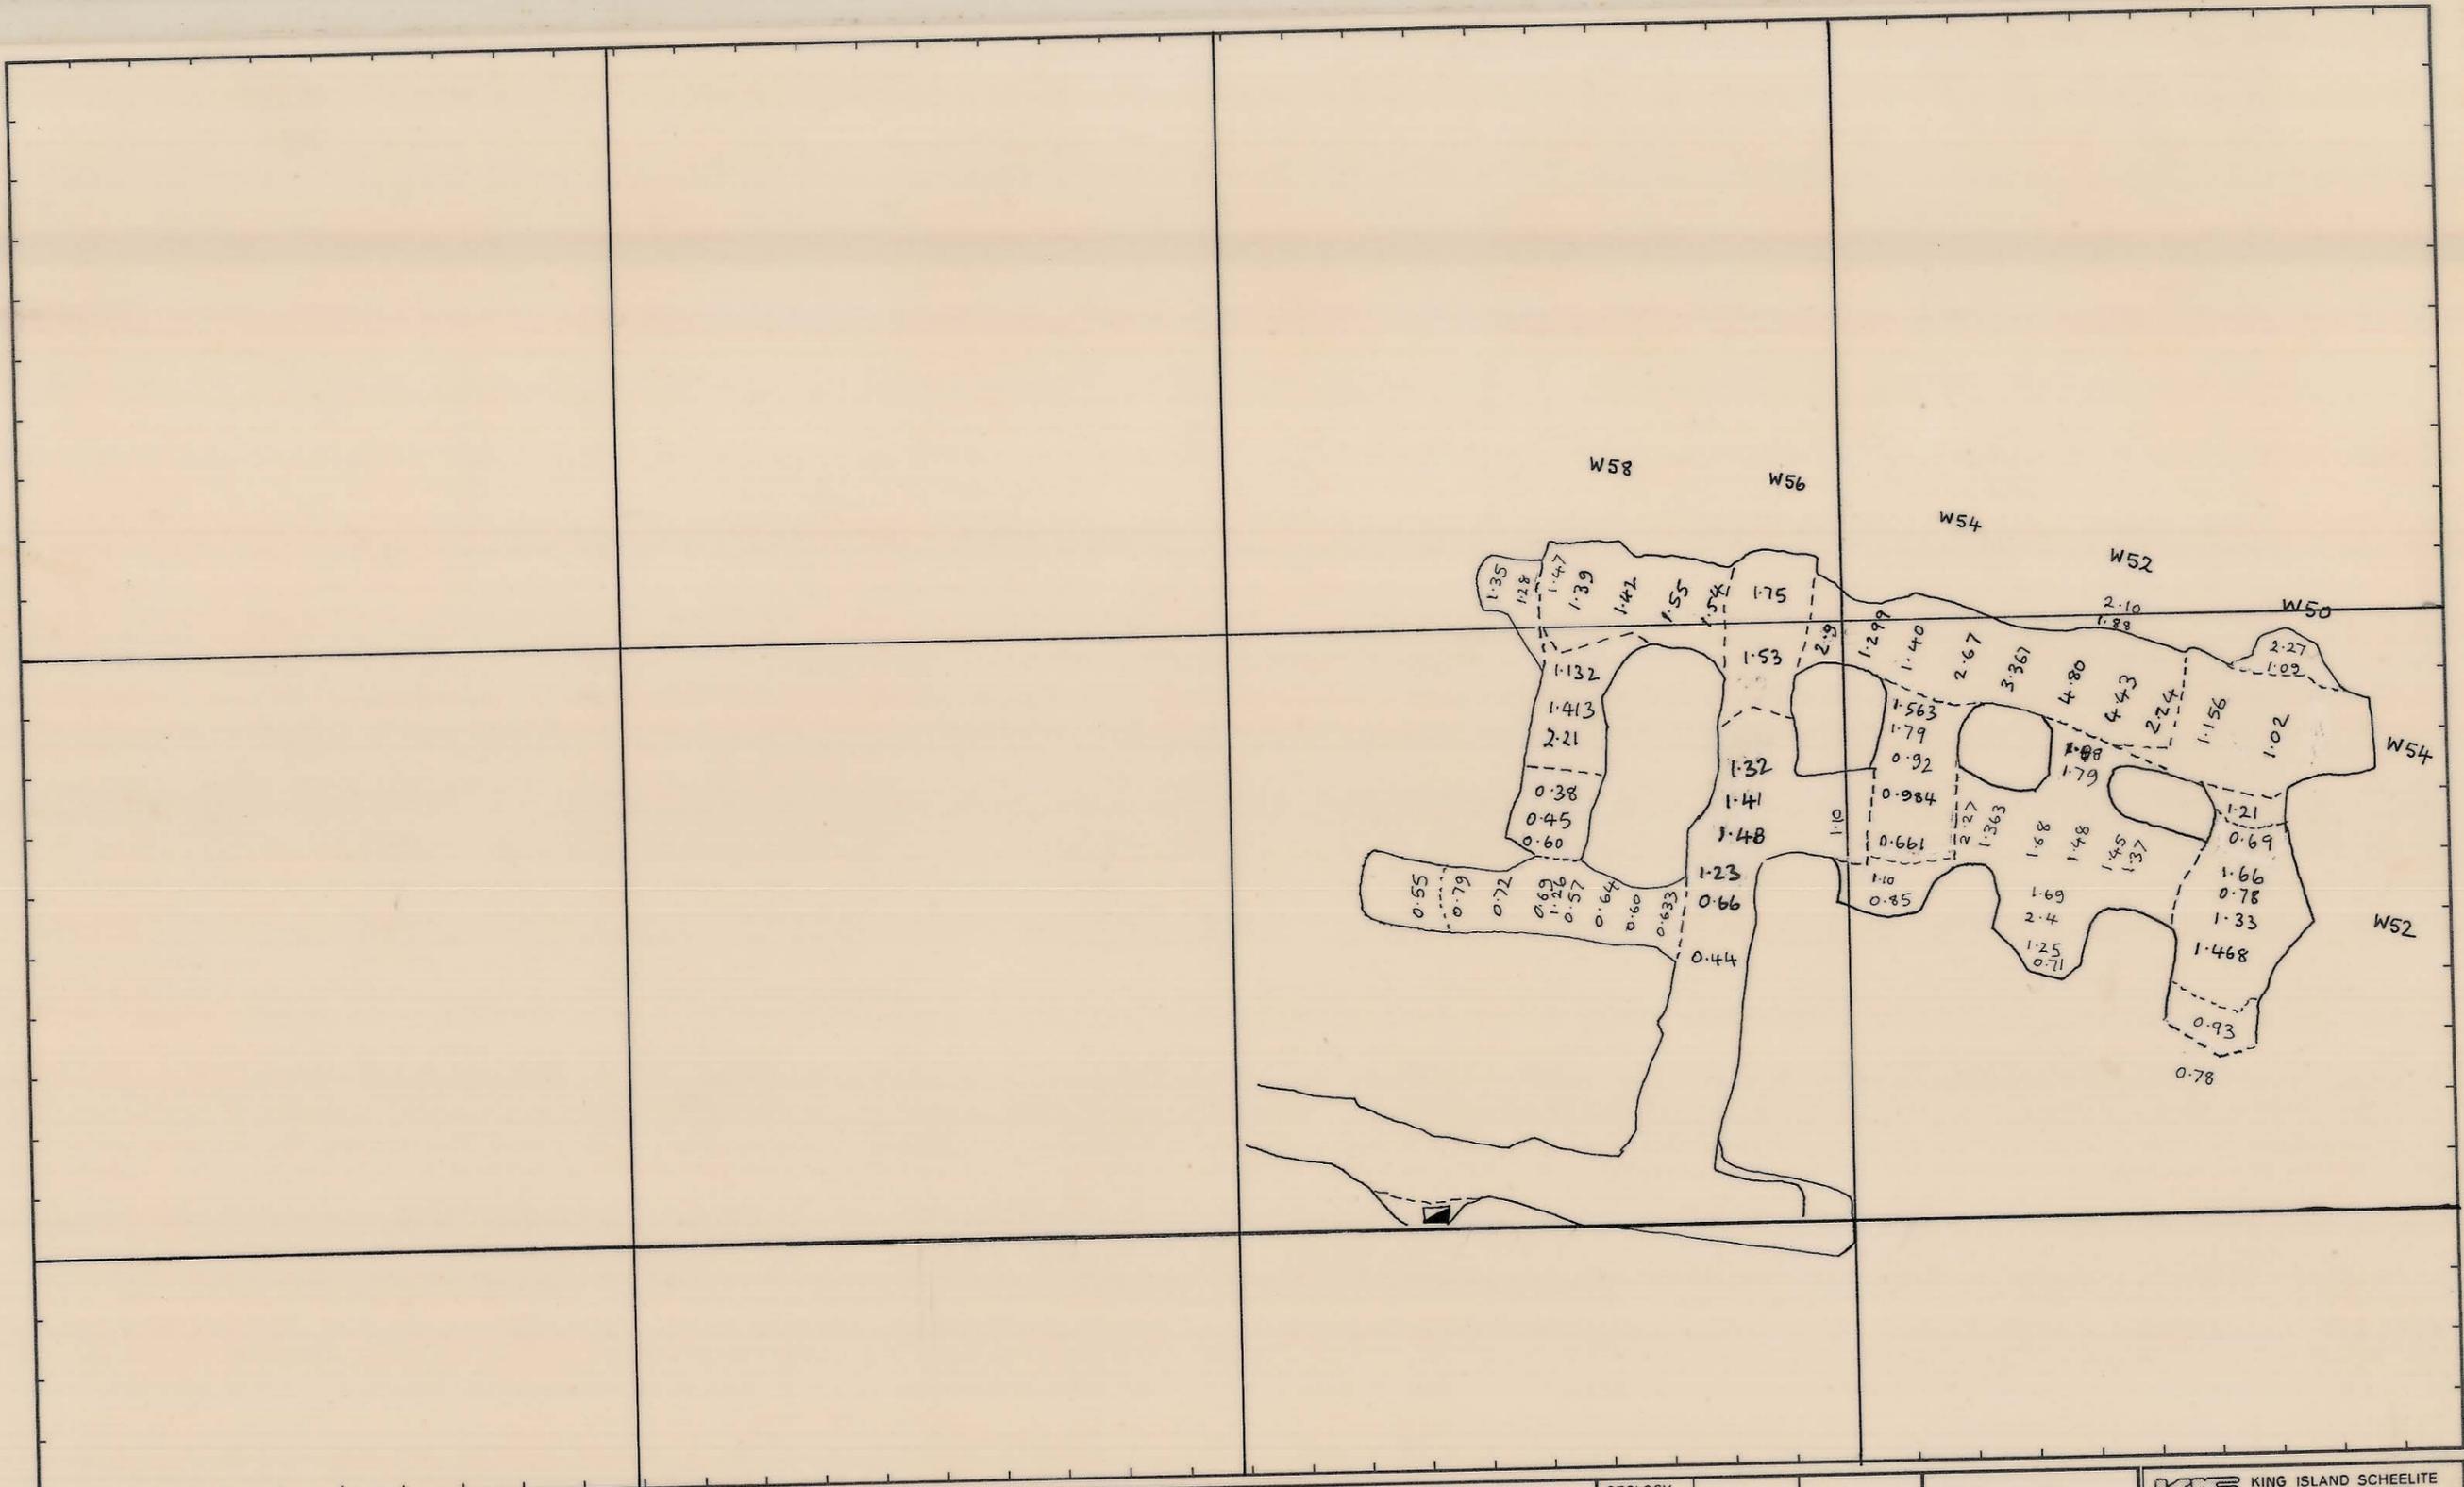

0374_1810

5 cm

REF. PLAN

GEOLOGY

SURVEY

PLANNING

AD7

ROCK MEC.

GRADE CON.

DRAFTING

T.S.S.

SCALE 1: 500

KIS KING ISLAND SCHEELITE GRASSY KING ISLAND

LOWER WEDGE 260 STOPE
LIFT 01

DRAWING NUMBER