


0374_1813

Wedge Remnant Lift 1

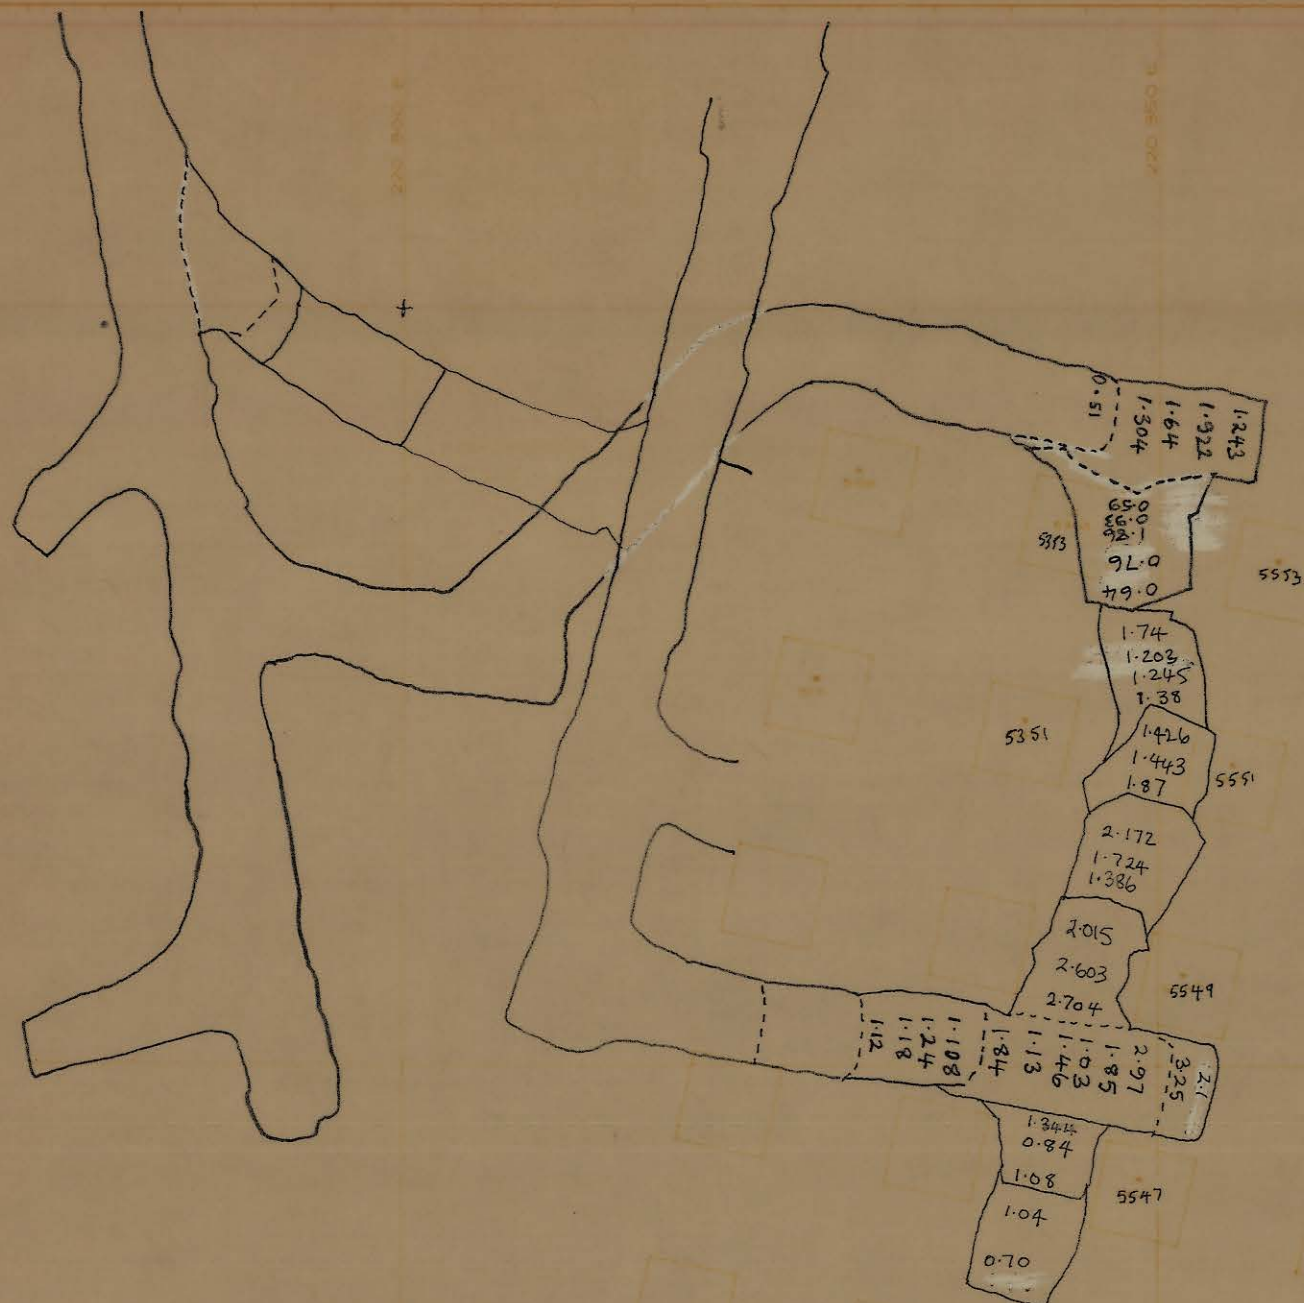

0374_1813

5 cm

REF PLAN

NOTE * PILLARS MOVED 5m EAST
OF ORIGINAL POSITION.

Back - 282.0

Floor - 286.0

GEOLOGY

SURVEY

PLANNING

ROCK MEC.

GRADE CON

DRAFTING

T.S.S.

ADJUDGE 1987

SCALE 1:500

KIS KING ISLAND SCHEELITE
GRASSY KING ISLAND

WEDGE REMNANT STOPE

LIFT 01

DRAWING NUMBER