


0374_1814

Wedge Remnant
Undercut



0374_1814

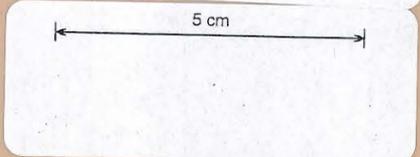

REF PLAN NOTE * PILLARS MOVED 5m EAST OF ORIGINAL POSITION. Back - 286.0 Floor - 291.0	GEOLOGY		SCALE 1: 500	KIS KING ISLAND SCHEELITE GRASSY KING ISLAND
	SURVEY			
	PLANNING		WEDGE REMNANT STOPE Undercut	
	ROCK MEC.			
	GRADE CON.	AD Judge 1986	DRAWING NUMBER	
	DRAFTING			
	T.S.S.			