


0374_1823

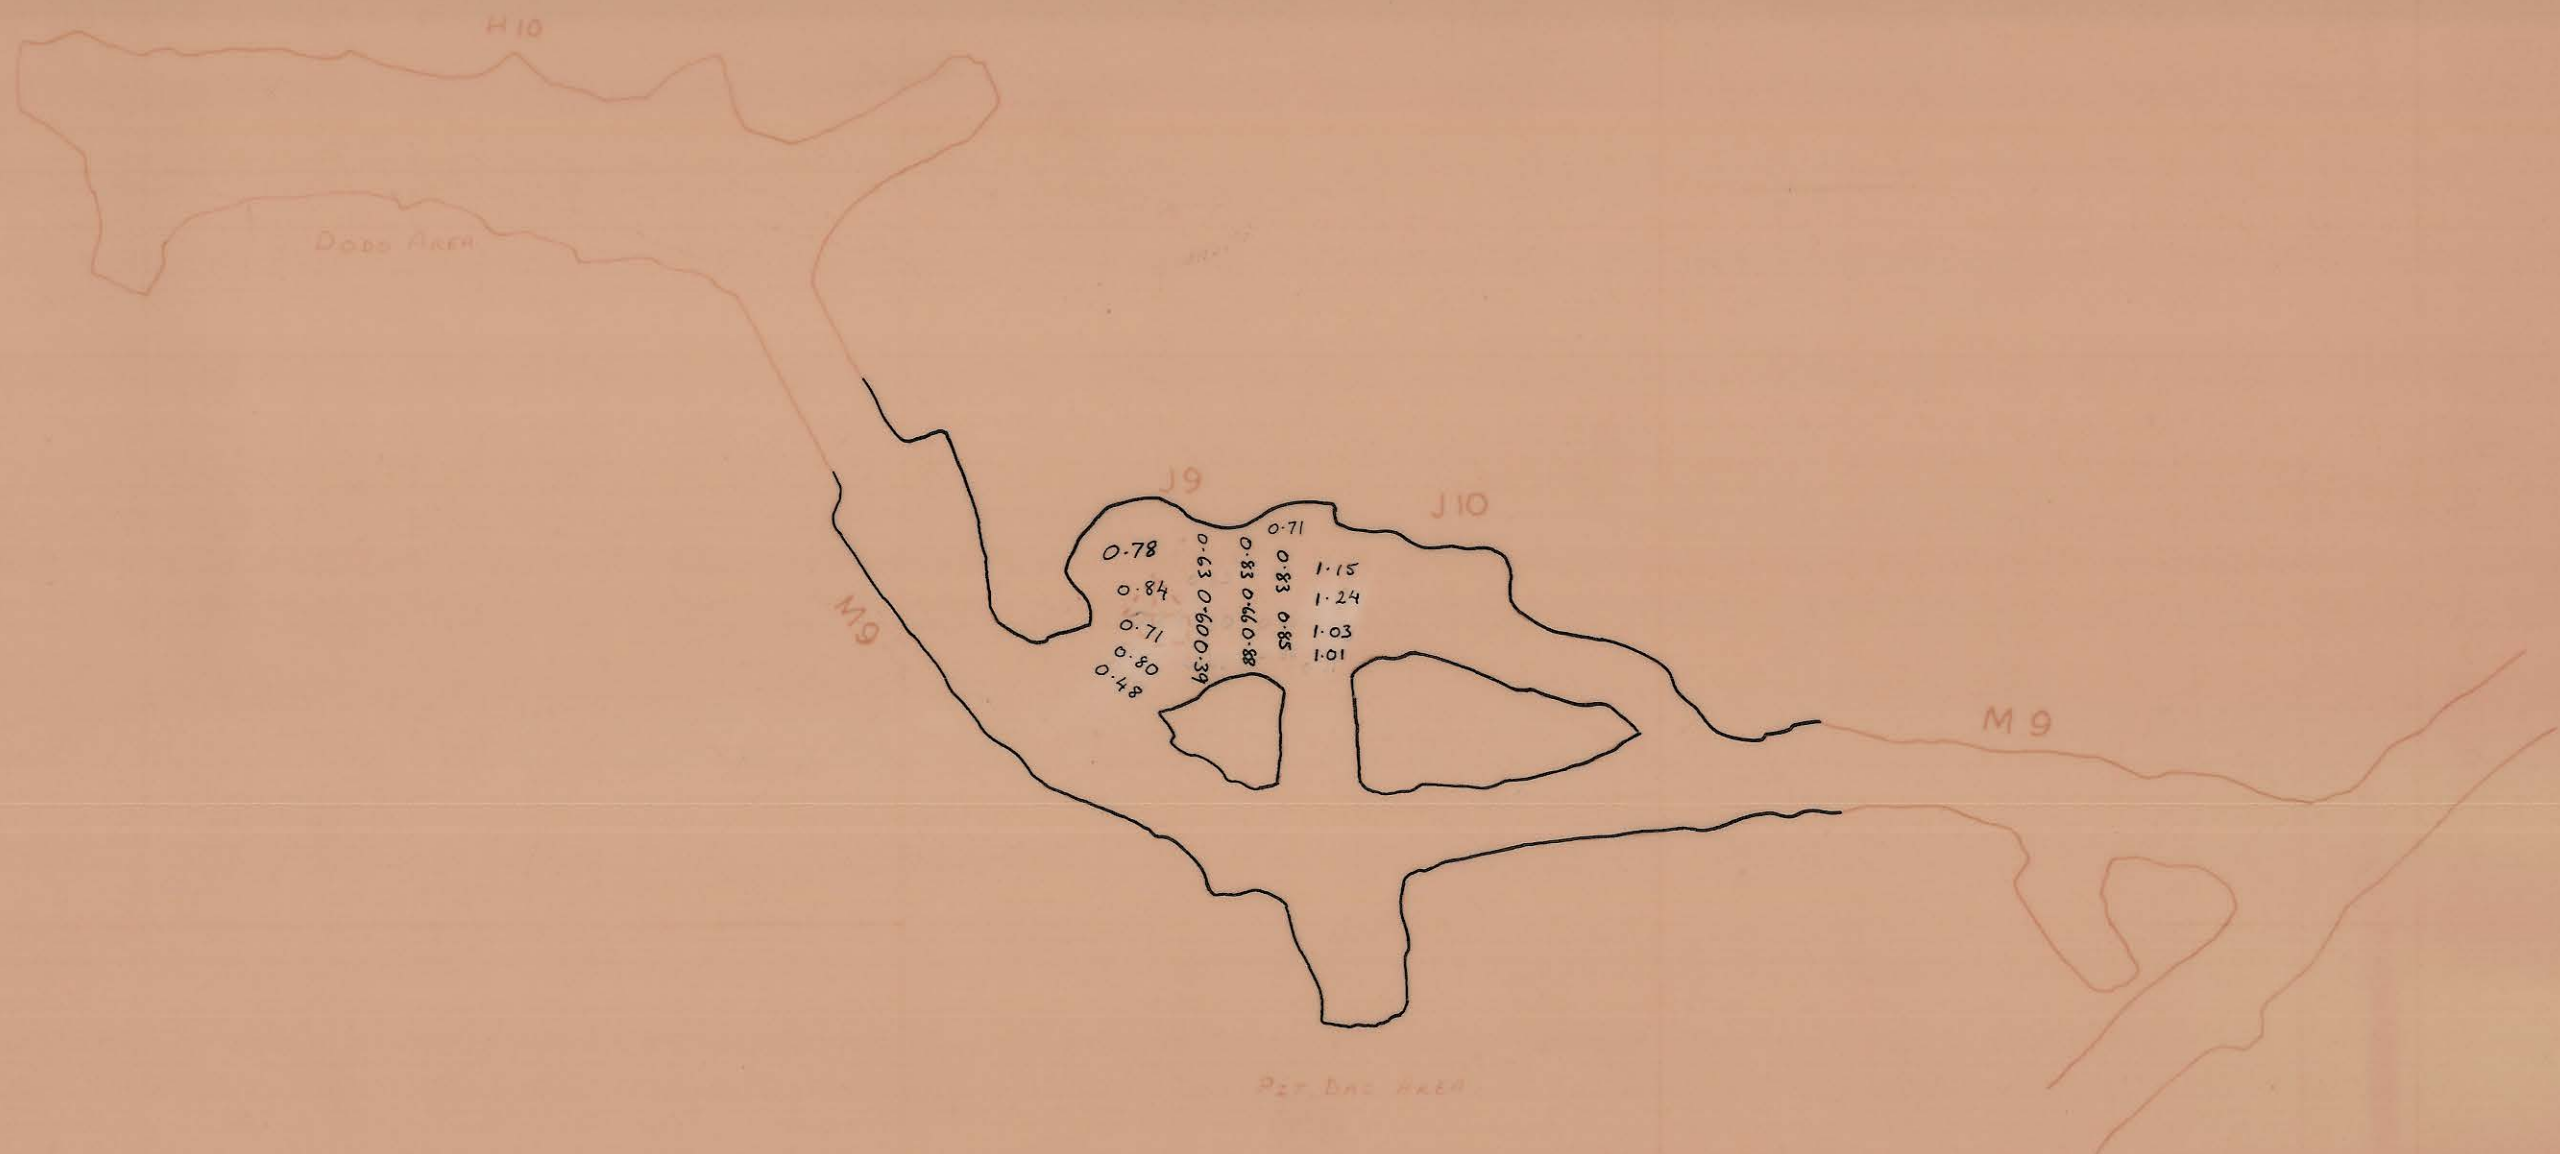

Pit Dag Area
- outline at approx 145 m 84

0374_1823

5 cm

REF PLAN
June - Sept 1989.

GEOLOGY	PAD
SURVEY	
PLANNING	
ROCK MECL	
GRADE CON	
DRAFTING	
FILE	

SCALE 1:500

KIS KING ISLAND SCHEELITE
GRASSY KING ISLAND

PIT DAG AREA

OPEN STOPE.

REF PLAN