


0374_1836

3rd Lift
C. Wedge
-63.5m

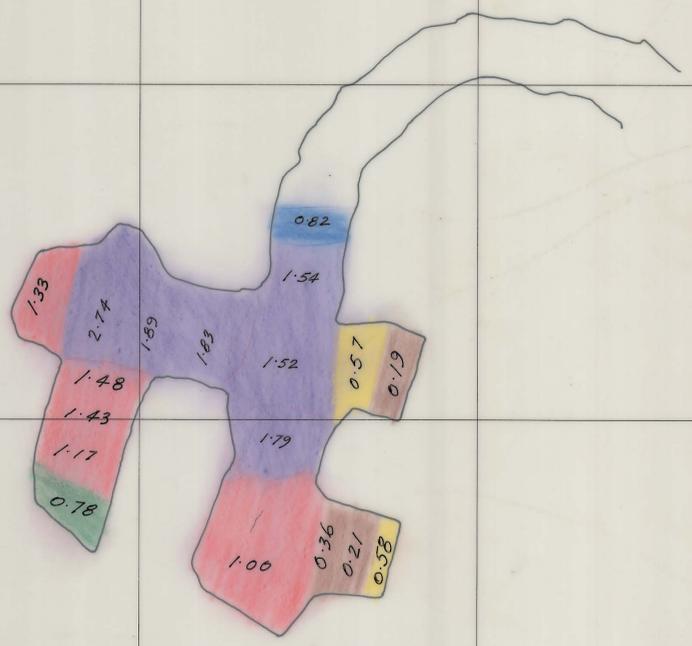

564250N

564200N

220100E

220150E

220200E

0374_1836

5 cm

	KING ISLAND SCHEELITE LTD.	
	No 1-	
	3rd Lift C Wedge	
	Floor RL - 63.5	
	DATE SURVEYED	
DRAWN		
TRACED		
CHECKED		