


0374_1837

2nd Lift WEDGE
-66.5m RL

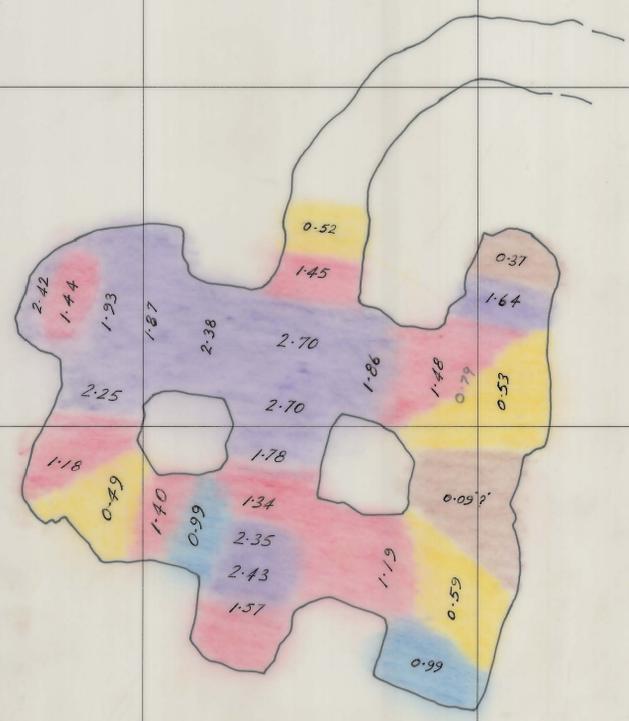

564250 N


564200 N

220100 E

220150 E

220200 E

0374_1837

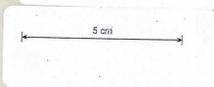

	KING ISLAND SCHEELITE LTD.	
	Scale	No 1-
DATE	2 nd Lift C Wedge	
SURVEYED	Floor RL -66.5	
DRAWN		
TRACED		
CHECKED		