


0374_1848

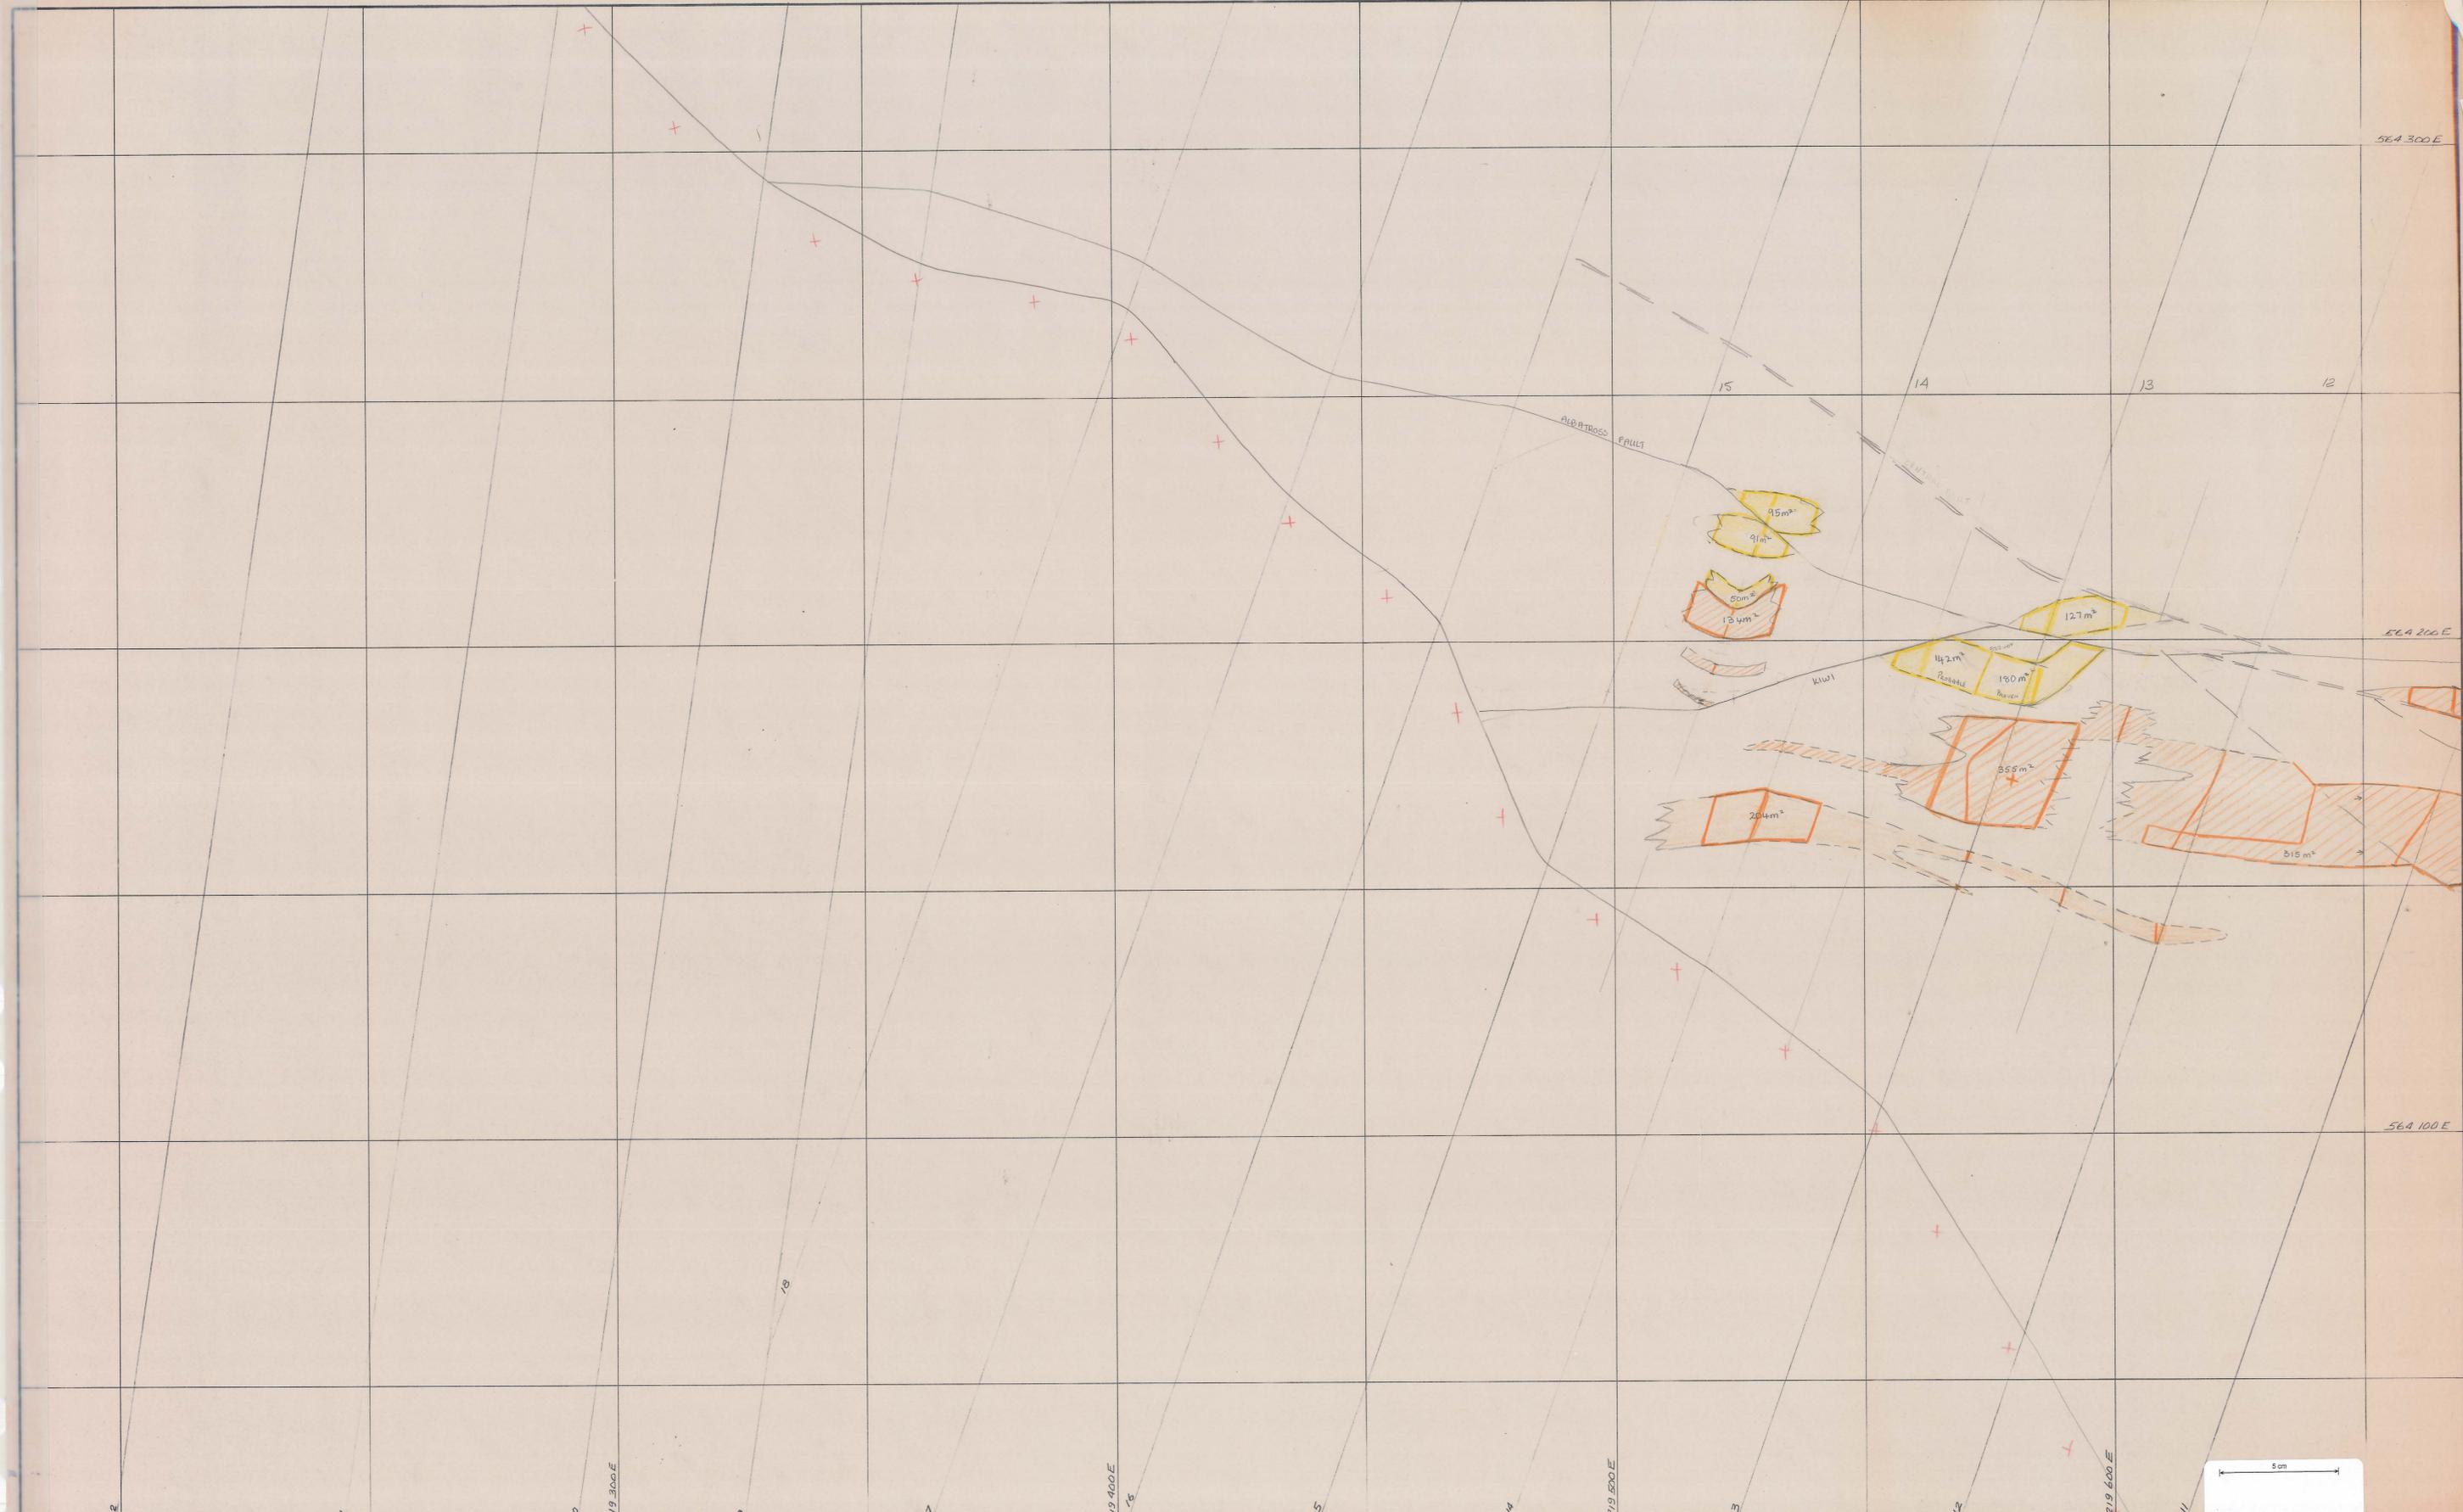

v/c 204 m²
 H/c 670 m²
 b/c 685 m²

0374_1848

R.F.D.

DATE:
GEOLOGIST:
DRAWN:
CHECKED:

GEOPEKO LIMITED
KING ISLAND GROUP

SCALE:

No. K

OPEN CUT
MINERALIZATION OUTLINES
-40- m.R.L. LEVEL PLAN

WEST