

0374-188

04BH15-106-95


10 1000 N
 10 850 N
 10 700 N
 10 550 N
 10 400 N
 10 250 N
 10 100 N

40 450 E

40 400 E

40 350 E

40 300 E

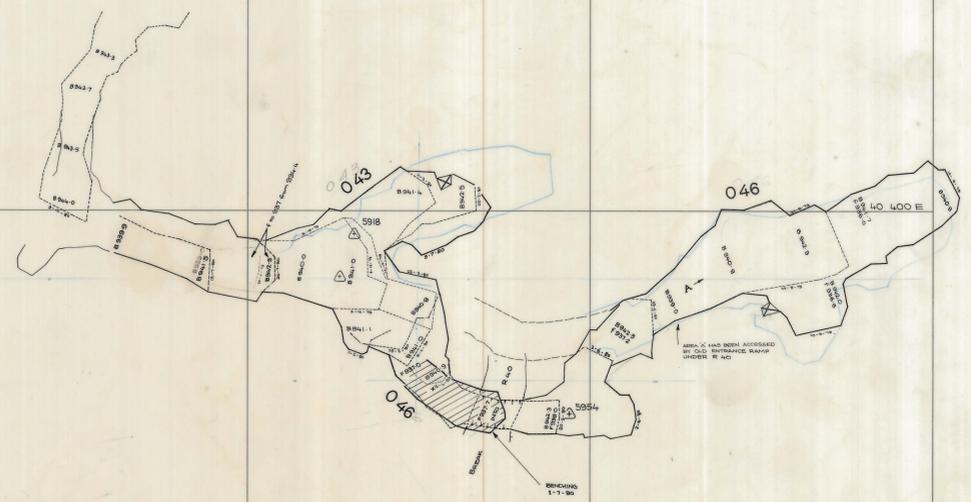

SCALE 1:500



north

LOCATION
 BOLD HEAD MINE
 SUBJECT
 0 37 & 043 STOPES
 5th lift

KIS KING ISLAND SCHEELITE
 A DIVISION OF WARRAN INTERNATIONAL
 GRASSY KING ISLAND
 PLAN NUMBER
 04BH15 - 106 - 95