



0374 - 189

04BH15-106-96

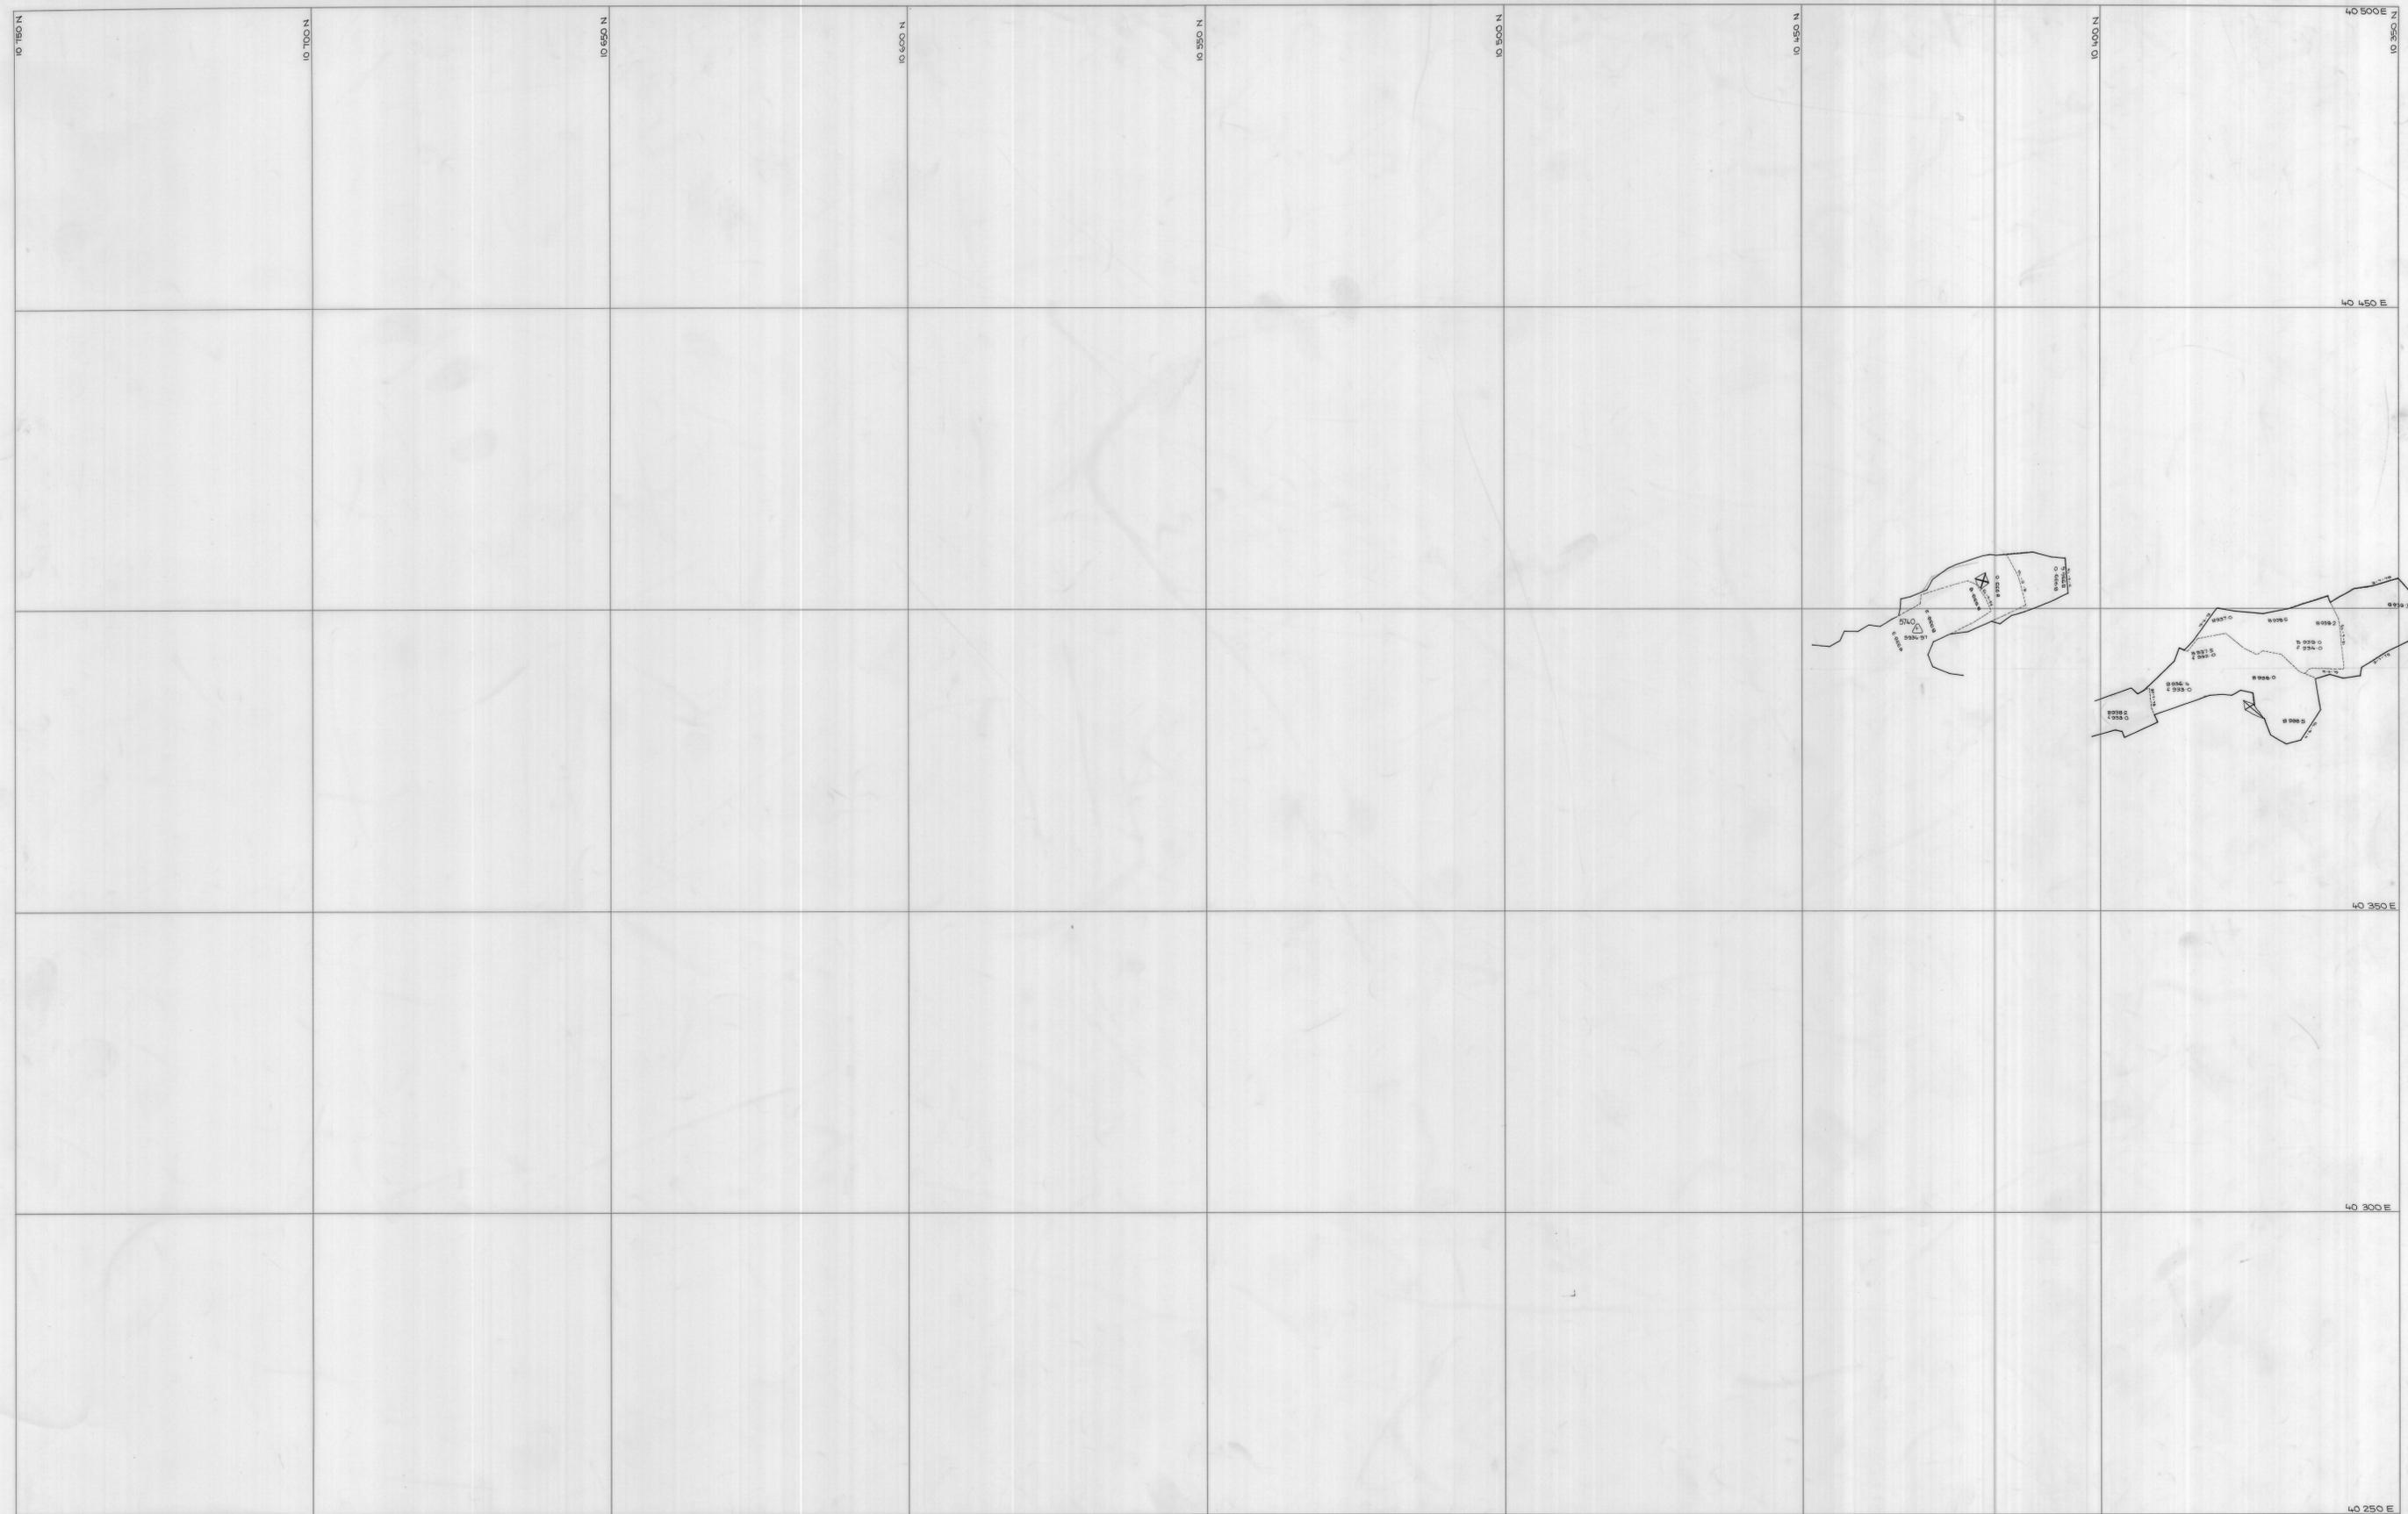

SCALE 1:500

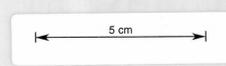

north

LOCATION BOLD HEAD MINE

SUBJECT 043 & 037 STOPES
4th lift

KIS KING ISLAND SCHEELITE
A DIVISION OF WARMAN INTERNATIONAL

GRASSY KING ISLAND
106-96

PLAN NUMBER 04BH15 - 106 - 96