
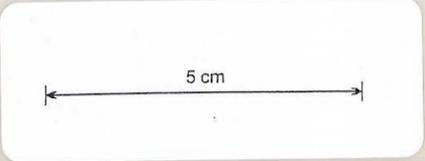


0374-1904

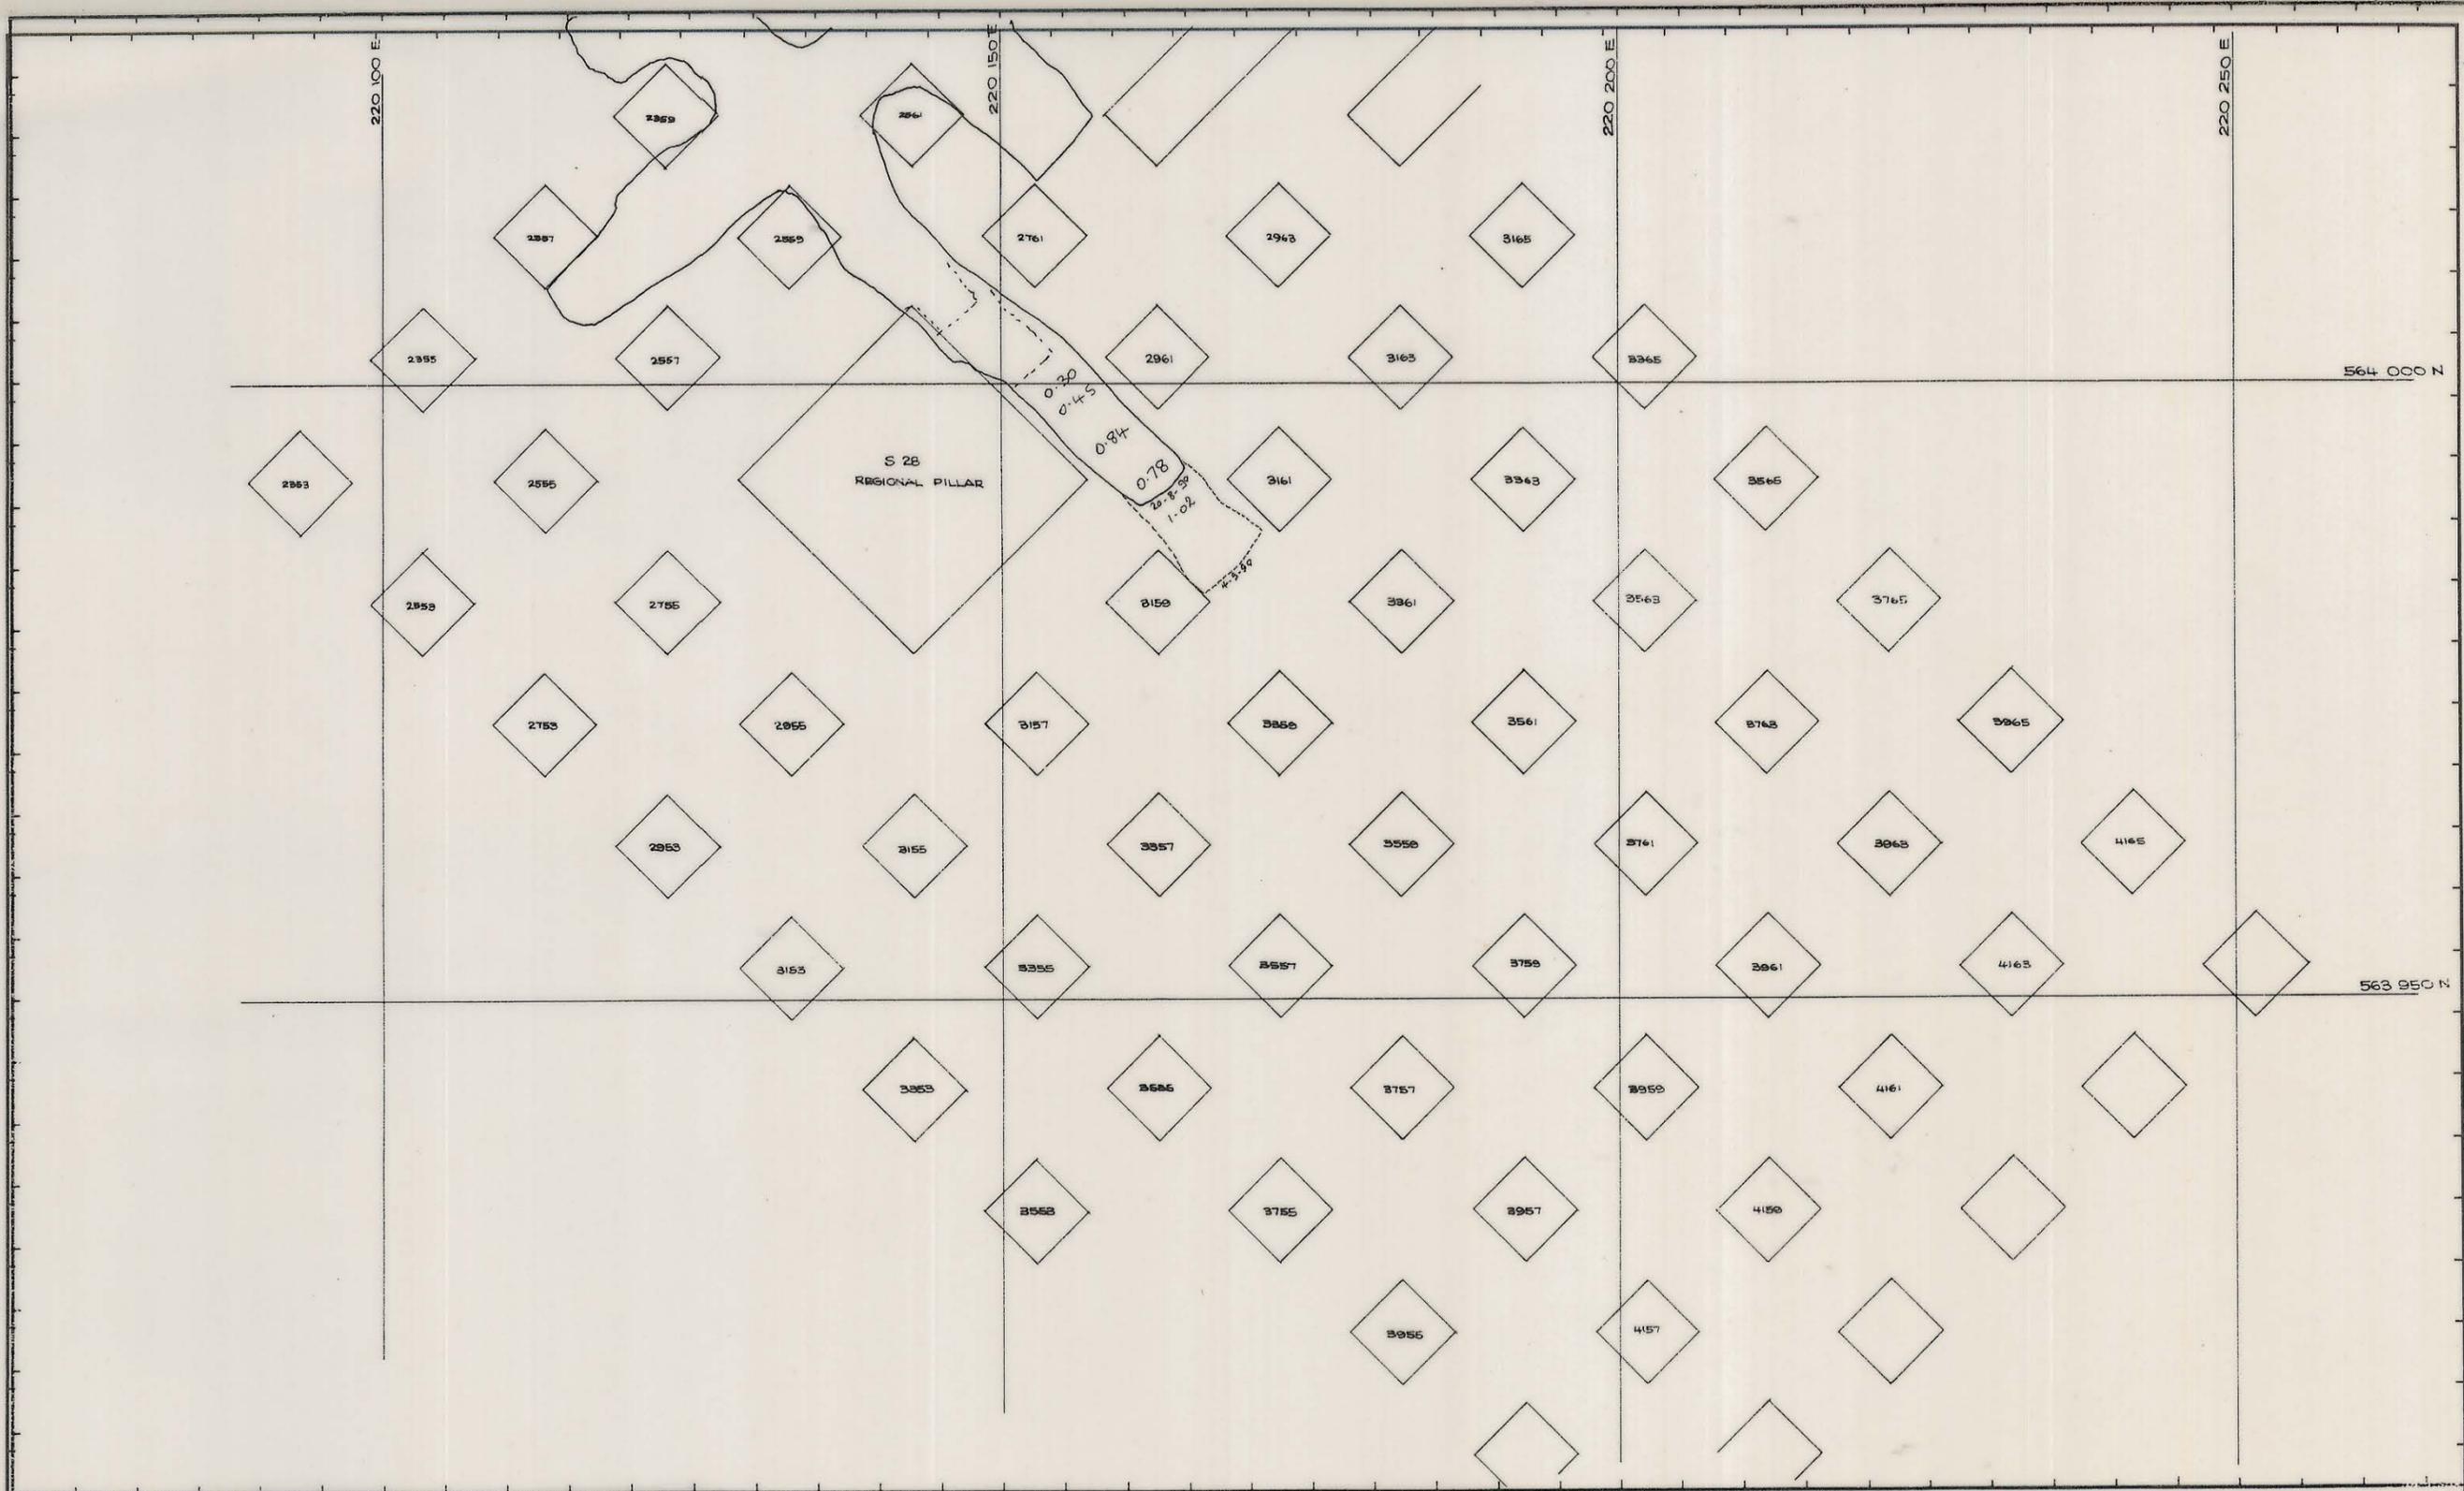

REF PLAN	GEOLOGY	SCALE 1: 500 SCALE 1:	
REF PLAN	GEOLOGY SURVEY		
	SURVEY PLANNING		
	PLANNING		
	ROCK MEC.		
	ROCK MEC. GRADE CON.		
	GRADE CON.		
	DRAFTING		
	DRAFTING T.S.S.		
	T.S.S.		
		LOWER PIT STOPE LIFT 16	
		DRAWING NUMBER	
		DRAWING NUMBER	