


0374-1906

Lower Central 03

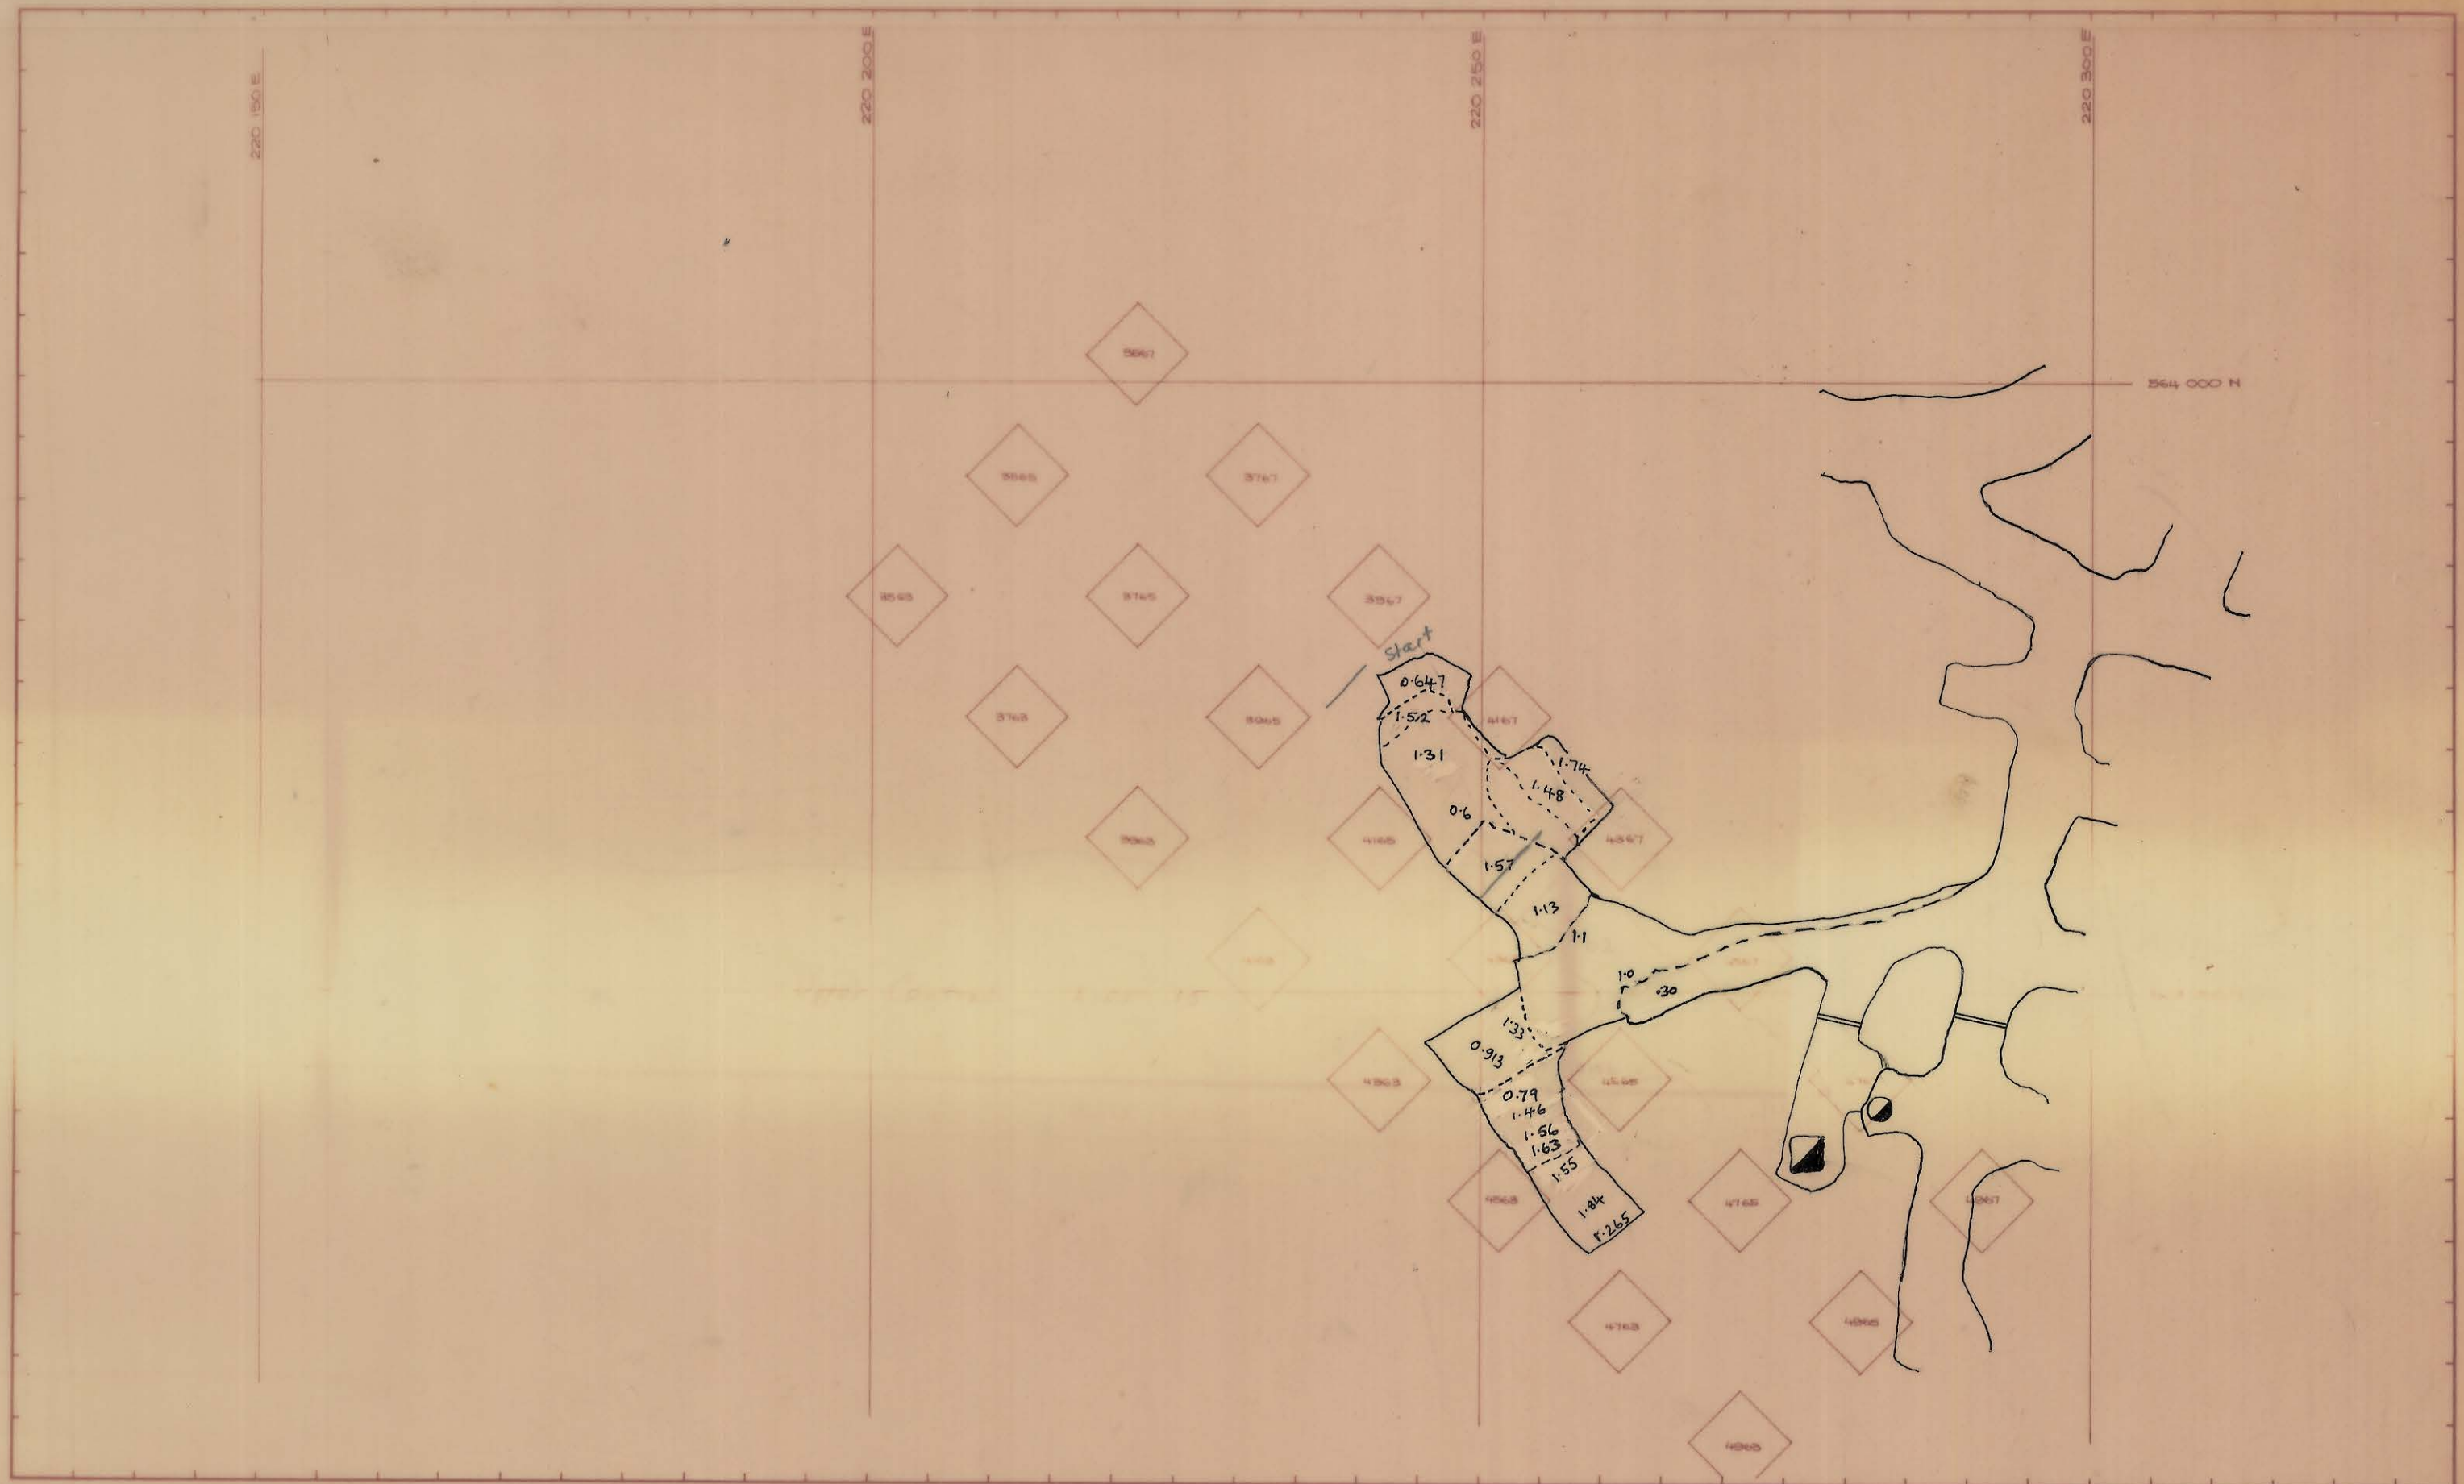

5 cm

0374-1906

REF PLAN

GEOLOGY

SURVEY

PLANNING

ROCK MEC.

GRADE CON

DRAFTING

T.S.S.

SCALE 1: 500

KIS KING ISLAND SCHEELITE  
GRASSY KING ISLAND

LOWER CENTRAL STOPE 03

-240 m level

DRAWING NUMBER