


0374 - 1908

M-Central 01

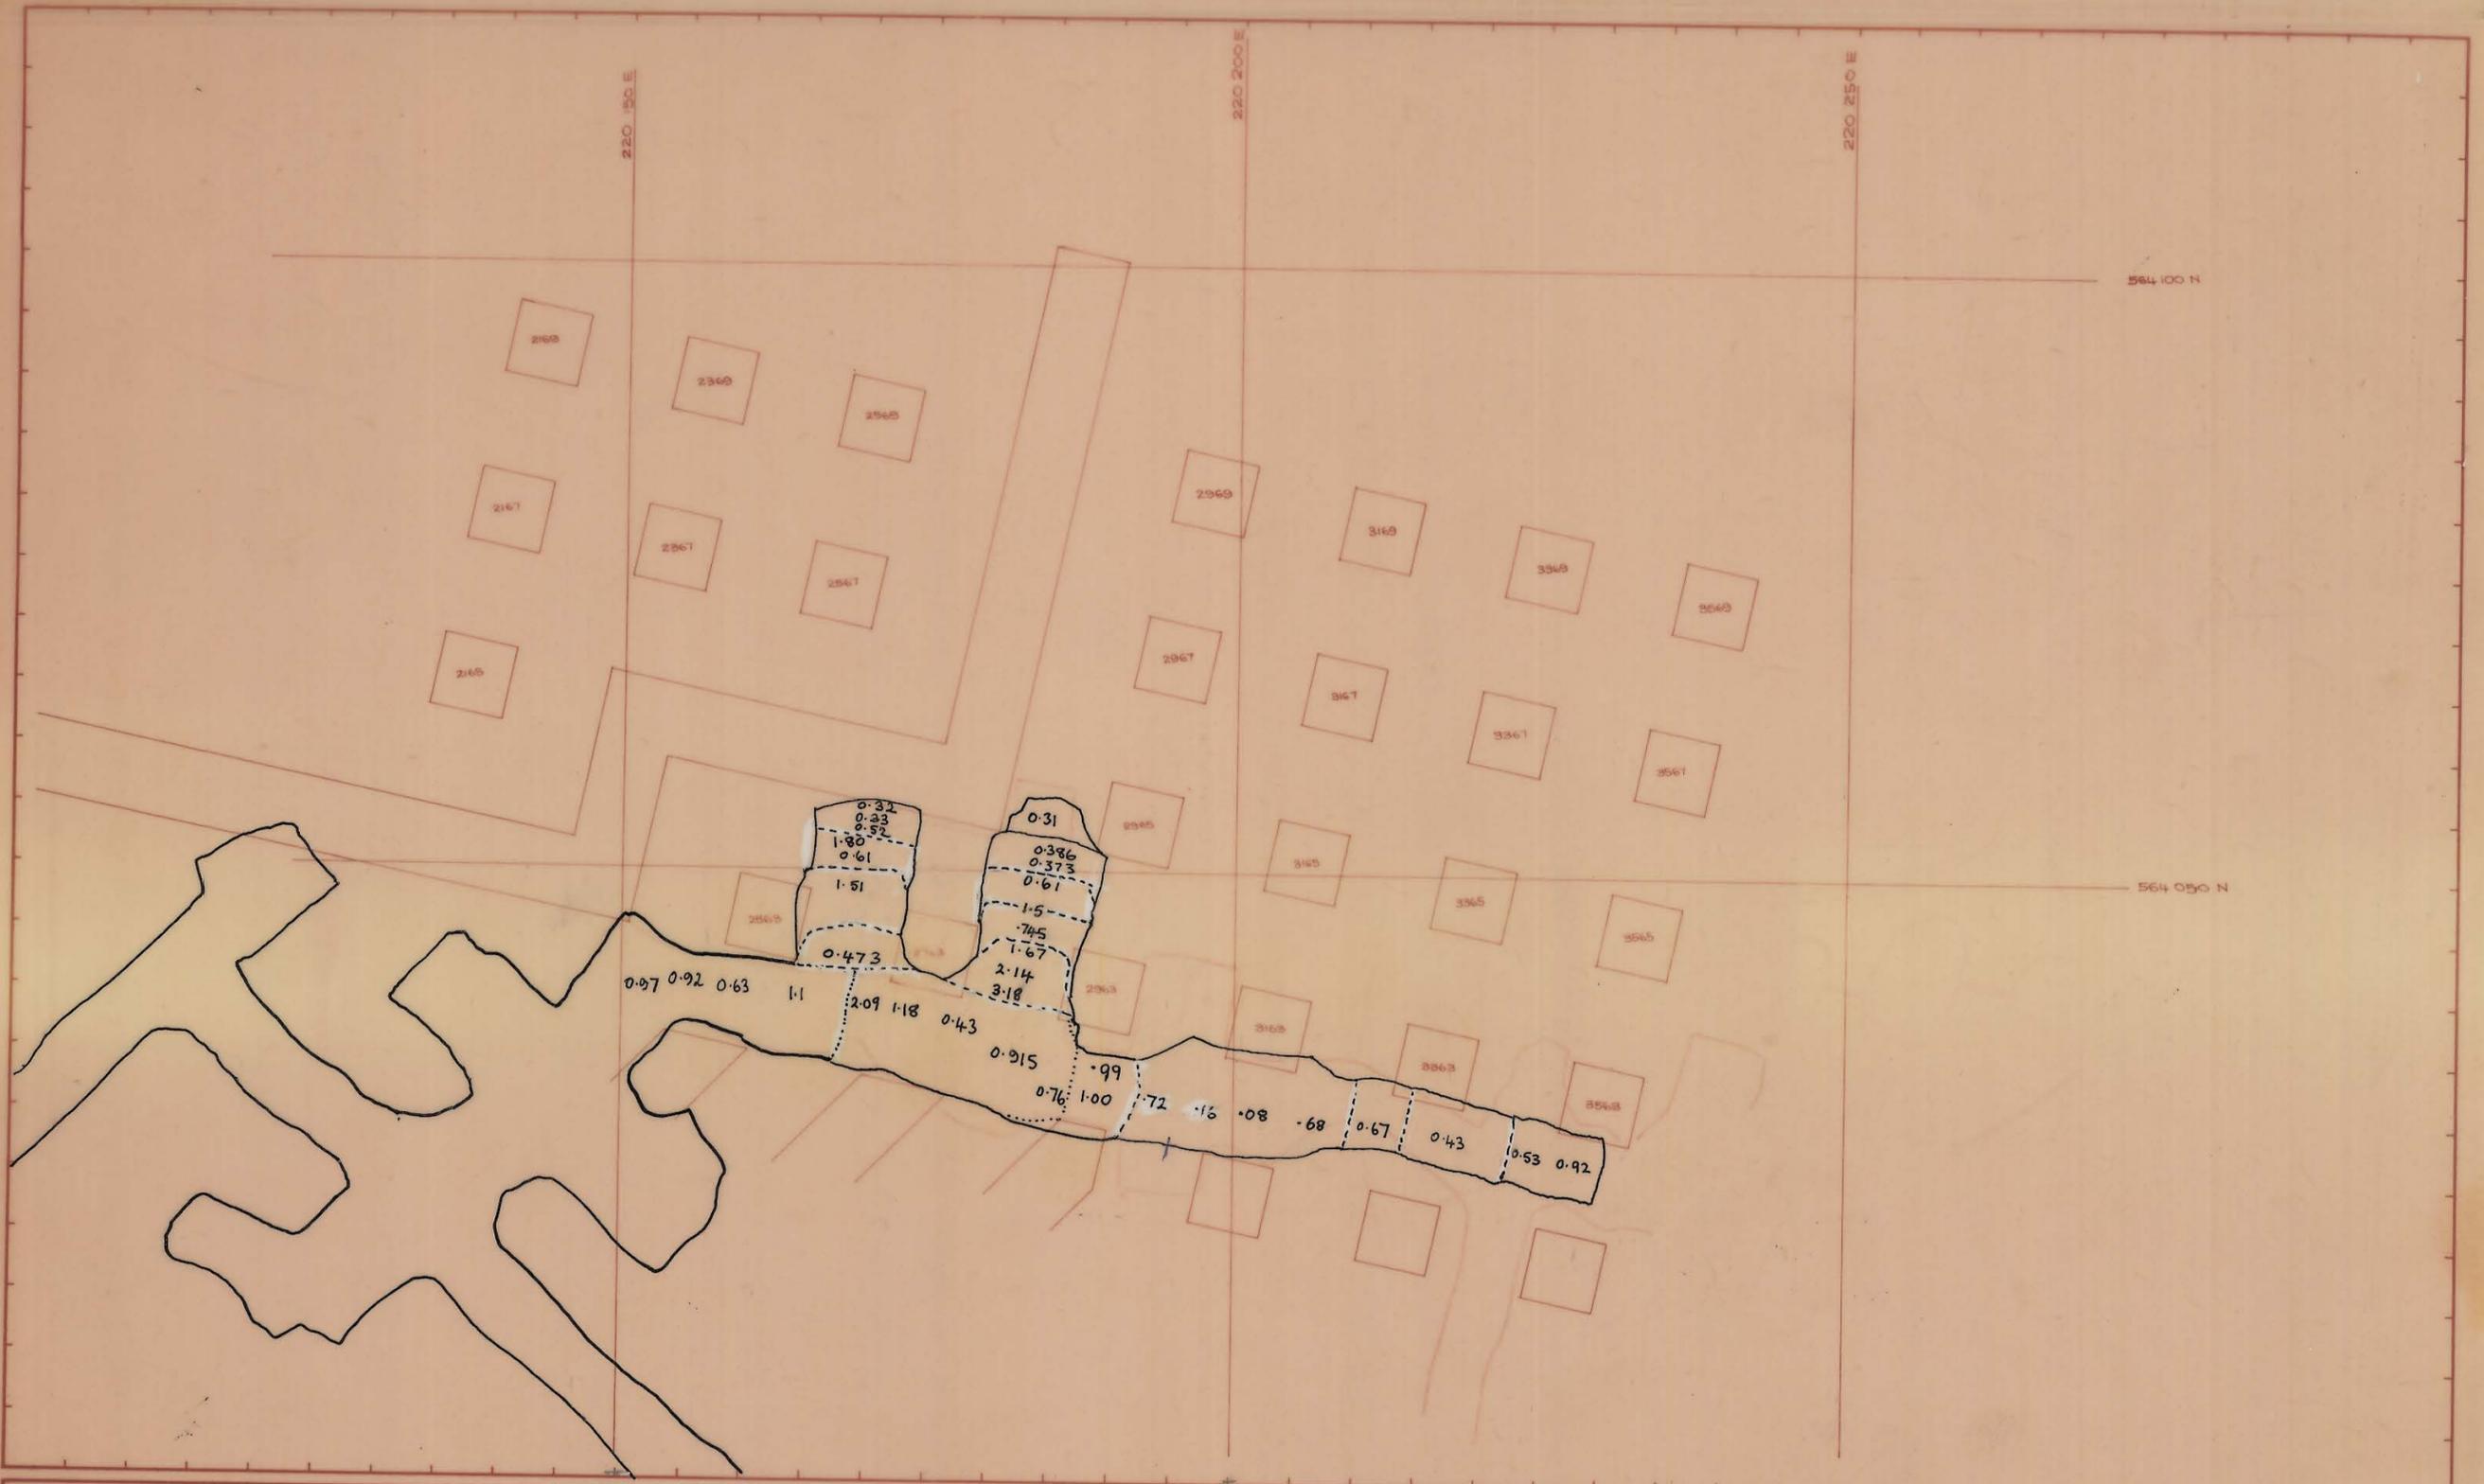

5 cm
0374 - 1908

REF PLAN
BACK-170.0
FLOOR-174.5

GEOLOGY		
SURVEY		
PLANNING	AD7	10-2-86
ROCK MEC.		
GRADE CON		
DRAFTING		
T.S.S.		

SCALE 1: 500

KIS KING ISLAND SCHEELITE
GRASSY KING ISLAND

MID CENTRAL SLOPE
1ST LIFT

DRAWING NUMBER